



LEVEL STATION	NORTHING	EASTING	STATION DESCRIPTION

PLAN OF MAIN DECK "CDP-1"  
SCALE 1:200

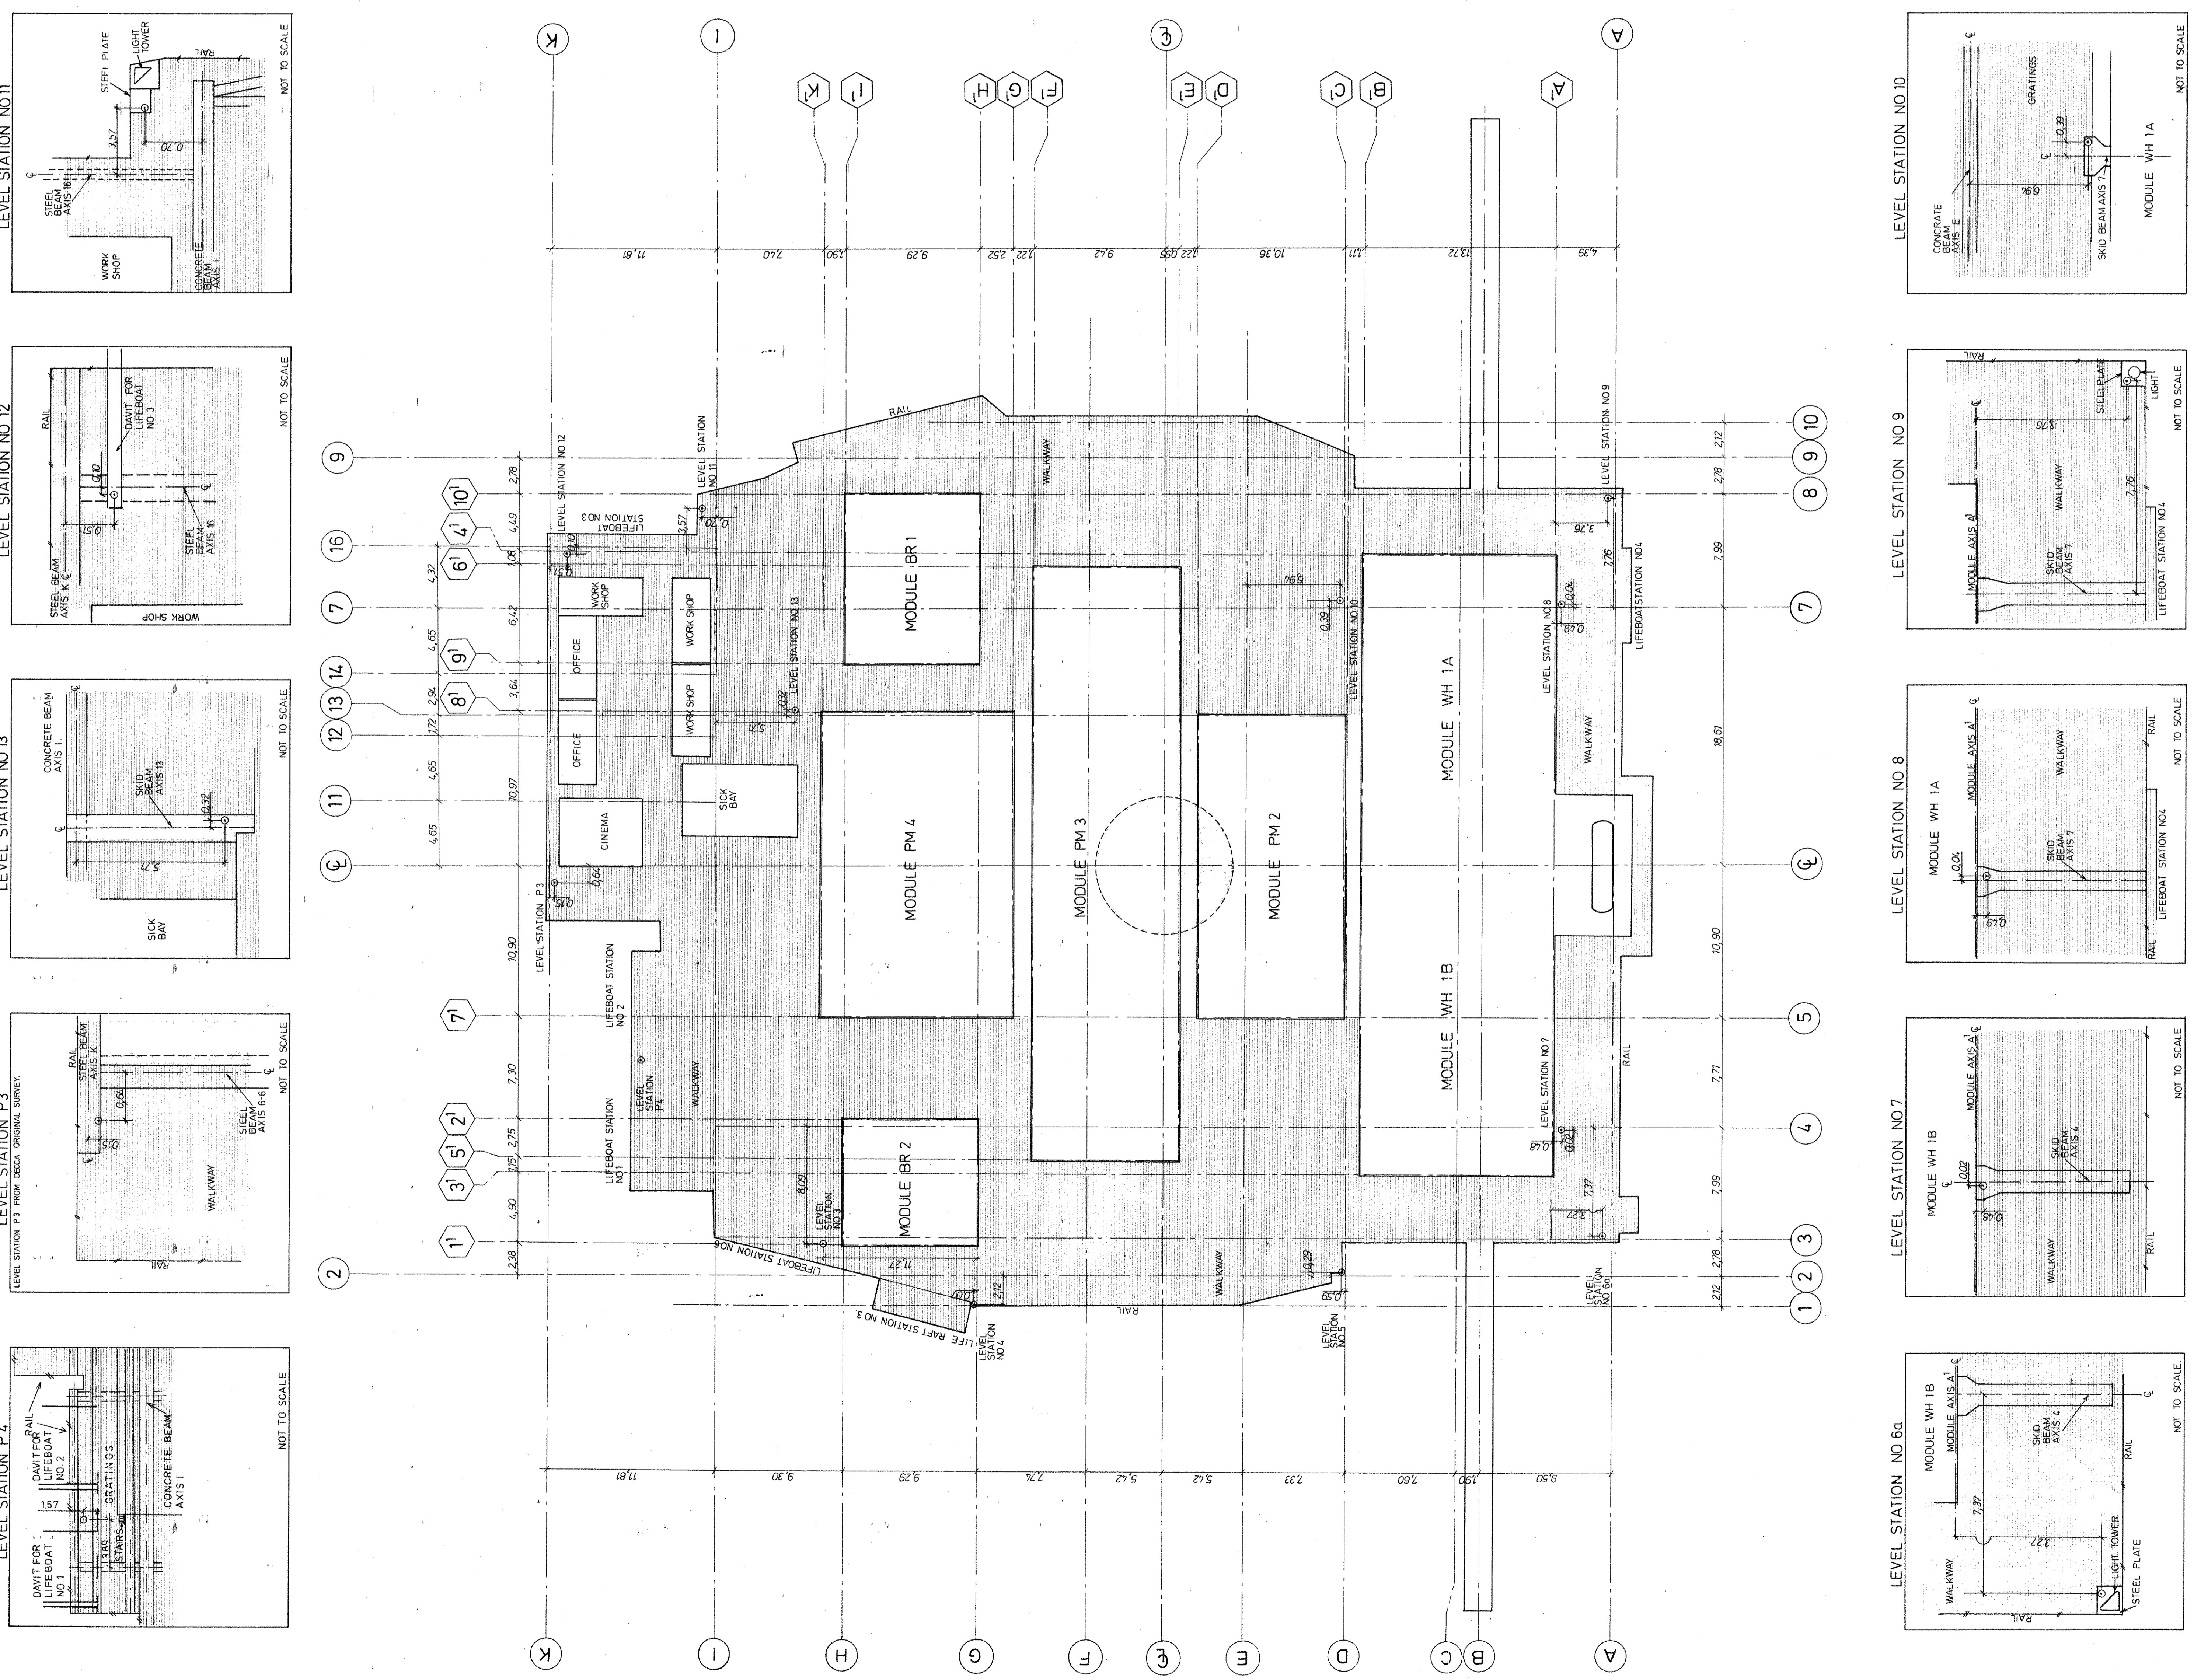

NOTES:  
DECK LEVELS REFERS TO BROWN & ROOT LTD. DRAWING.  
DWG NO. B-EN-AA-07  
DECK - TOP OF SKID BEAM - EL. 127.750 m  
MAIN DECK - TOP OF CONCRETE BEAM - EL. 126.5 m  
COORDINATES GIVEN IN PLATFORM SYSTEM  
PLATFORM CENTER COORDINATES: NORTHING: 0.00 m  
EASTING: 0.00 m  
REFERENCE LOCATION SURVEY CARRIED OUT ON NOVEMBER 26 TH AND 27 TH 1980.

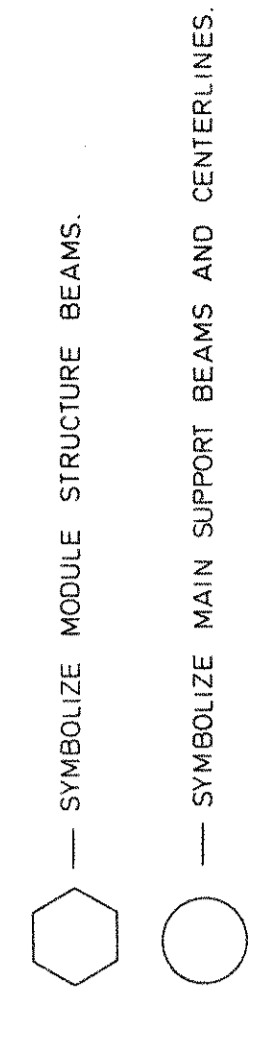

off equitime norge as  
CONCRETE DRILLING PLATFORM NO 1  
FRIGG FIELD

DESCRIPTION OF SURVEY STATIONS

FRIGG FIELD  
Bloms Opprømling A/S  
Strandkaien 2  
4000 Stavanger  
Telephone (045) 28190

Scale: 1:200  
Date: 00.33.00.28  
Sheet: 1