DWG. NO. ELN 2020 | SHEET NO. 164

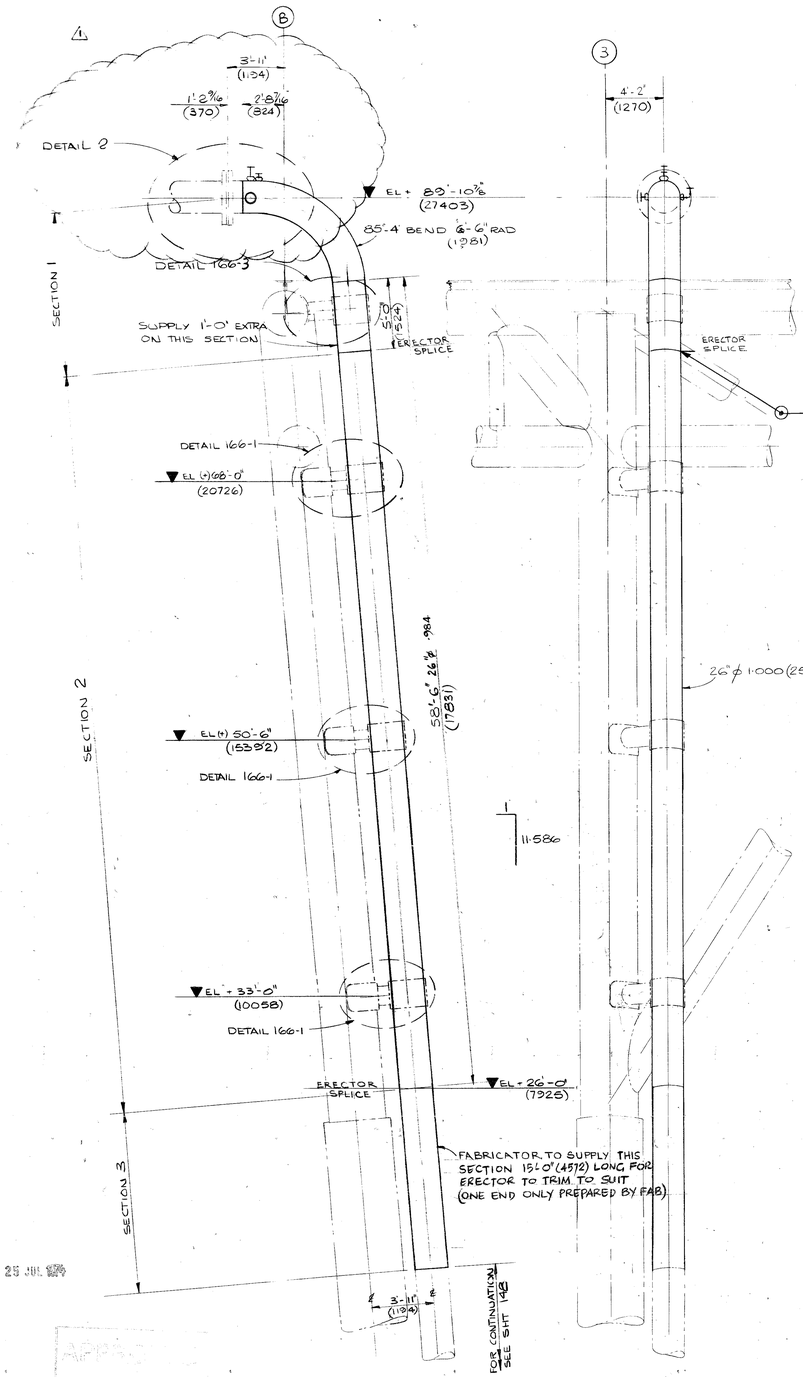

SECTION 'A-A'

26"ø PRODUCTION LINE SEE KEY PLAN

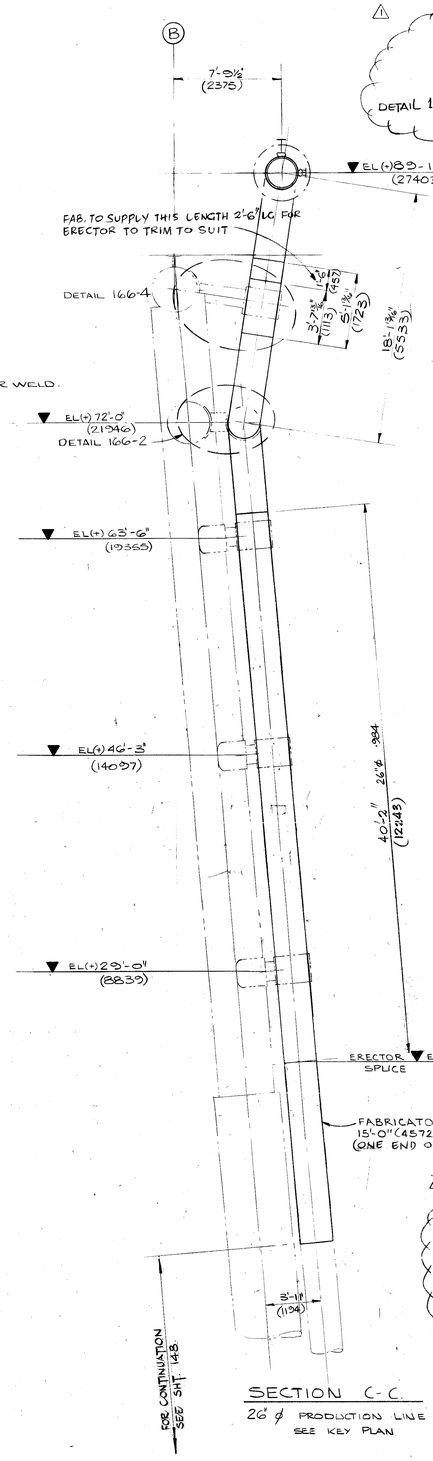

SECTION C-C

26"ø PRODUCTION LINE SEE KEY PLAN

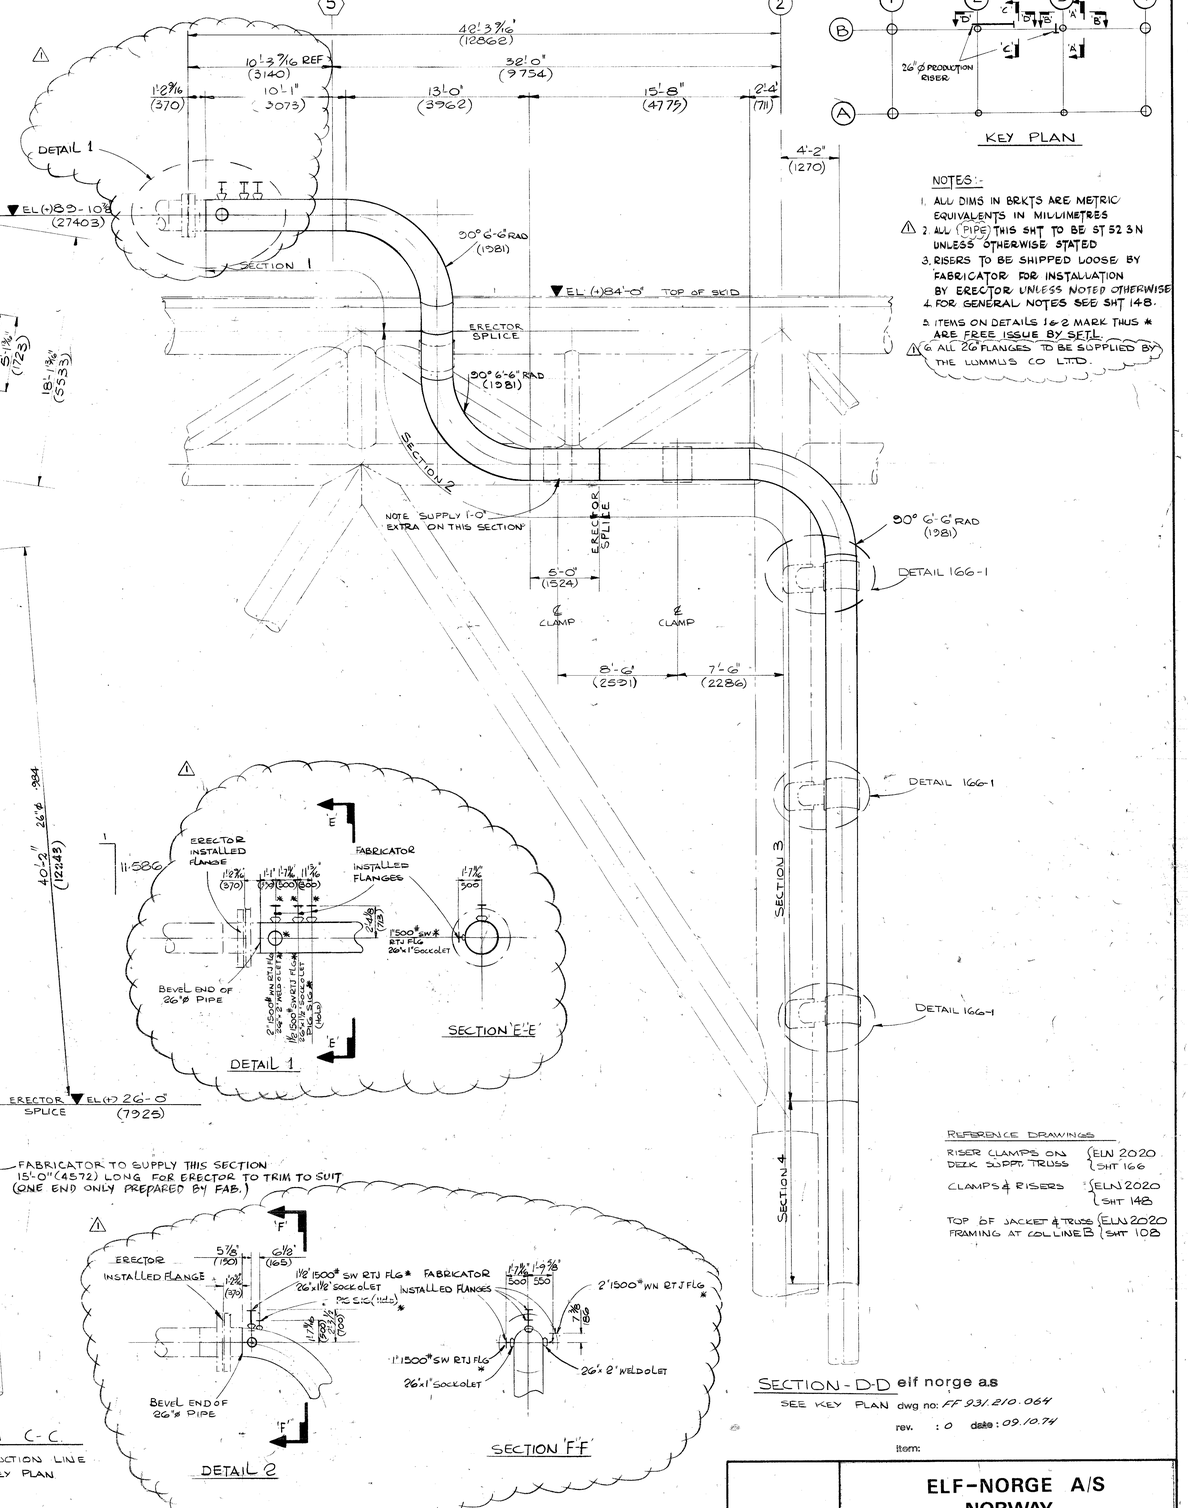

DETAIL 1

SECTION 'E'-'E'

DETAIL 2

SECTION 'F'-'F'

KEY PLAN

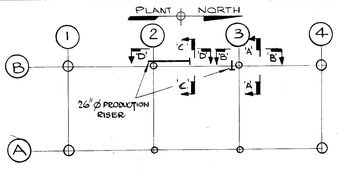

NOTES:-

1. ALL DIMS IN BRKTS ARE METRIC EQUIVALENTS IN MILLIMETRES
2. ALL (PIPE) THIS SHT TO BE ST 52 3 N UNLESS OTHERWISE STATED
3. RISERS TO BE SHIPPED LOOSE BY FABRICATOR FOR INSTALLATION BY ERECTOR UNLESS NOTED OTHERWISE
4. FOR GENERAL NOTES SEE SHT 148.
5. ITEMS ON DETAILS 1 & 2 MARK THUS * ARE FREE ISSUE BY SET.L.
6. ALL 26" FLANGES TO BE SUPPLIED BY THE LUMMUS CO LTD.

REFERENCE DRAWINGS

RISER CLAMPS ON DECK SUPPT. TRUSS — ELN 2020 SHT 166

CLAMPS & RISERS — ELN 2020 SHT 148

TOP OF JACKET & TRUSS FRAMING AT COLLINE B — ELN 2020 SHT 108

SECTION - D-D

SEE KEY PLAN

elf norge a.s

dwg no: FF 931.210.064

rev. : 0 date : 09.10.74

Item:

APPROVED

FOR CONSTRUCTION

25 JUL 1974

APPROVED: [signature] Mc DERMOTT — HUDSON DATE: 11 Dec 74

ENGINEERS APPROVAL

		DATE
PROJECT	[signature]	16/12/74
STRUCTURAL	[signature]	11 Dec 74
PROCESS		
MECHANICAL		
ELECTRICAL		
INSTRUMENT.		
PAR. CHECK	[signature]	10/12/74
PROP. CHECK	[signature]	11/12/74

ELF-NORGE A/S NORWAY

24 WELL SELF CONTAINED

DRILLING PLATFORM No 1

NORTH SEA FRIGG FIELD WD 98 M

McDERMOTT — HUDSON

LONDON — ENGLAND

DRAWN BY	SCALE	DATE	DWG NO.
M.G. MORRIS	1/4" = 1'-0"	31 JAN 74	ELN 2020
DESIGNED BY			SHEET NO.
MM			164

26" DIAM. RISERS ON DECK SUPPT TRUSS

FAB. STDS. REQ'D. THIS SHT.

DESIGN	STRUCT	PIPING	ELEC.	MK	BY	DATE	REVISIONS	DATE	APP.

DESIGN	STRUCT.	PIPING	ELEC.	MK.	BY	DATE	REVISIONS	DATE	APP.

DESIGN	STRUCT.	PIPING	ELEC.	MK.	BY	DATE	REVISIONS	DATE	APP.
				1	MM	13/12/74	DETAILS 1 & 2 & NOTE 6 ADDED.	16/12/74	MM

S & N LTD 2517