

GENERAL NOTES

DECK REFERENCE LEVEL 100000 D.L. 27.24 L.A.T. 131.70 P.L. 130.00 S.B.L.

HOLDS SEE DRAWINGS NO 5424W.00.00.60.72 AND 74

BULK HEAD

SHEETING



GRATING

REFERENCE DRAWINGS

CELLAR DECK PLOT PLAN 5424W 0000 60 72

MAIN DECK PLOT PLAN 5424W 0000 60 73

UPPER DECK PLOT PLAN 5424W 00 00 60 74

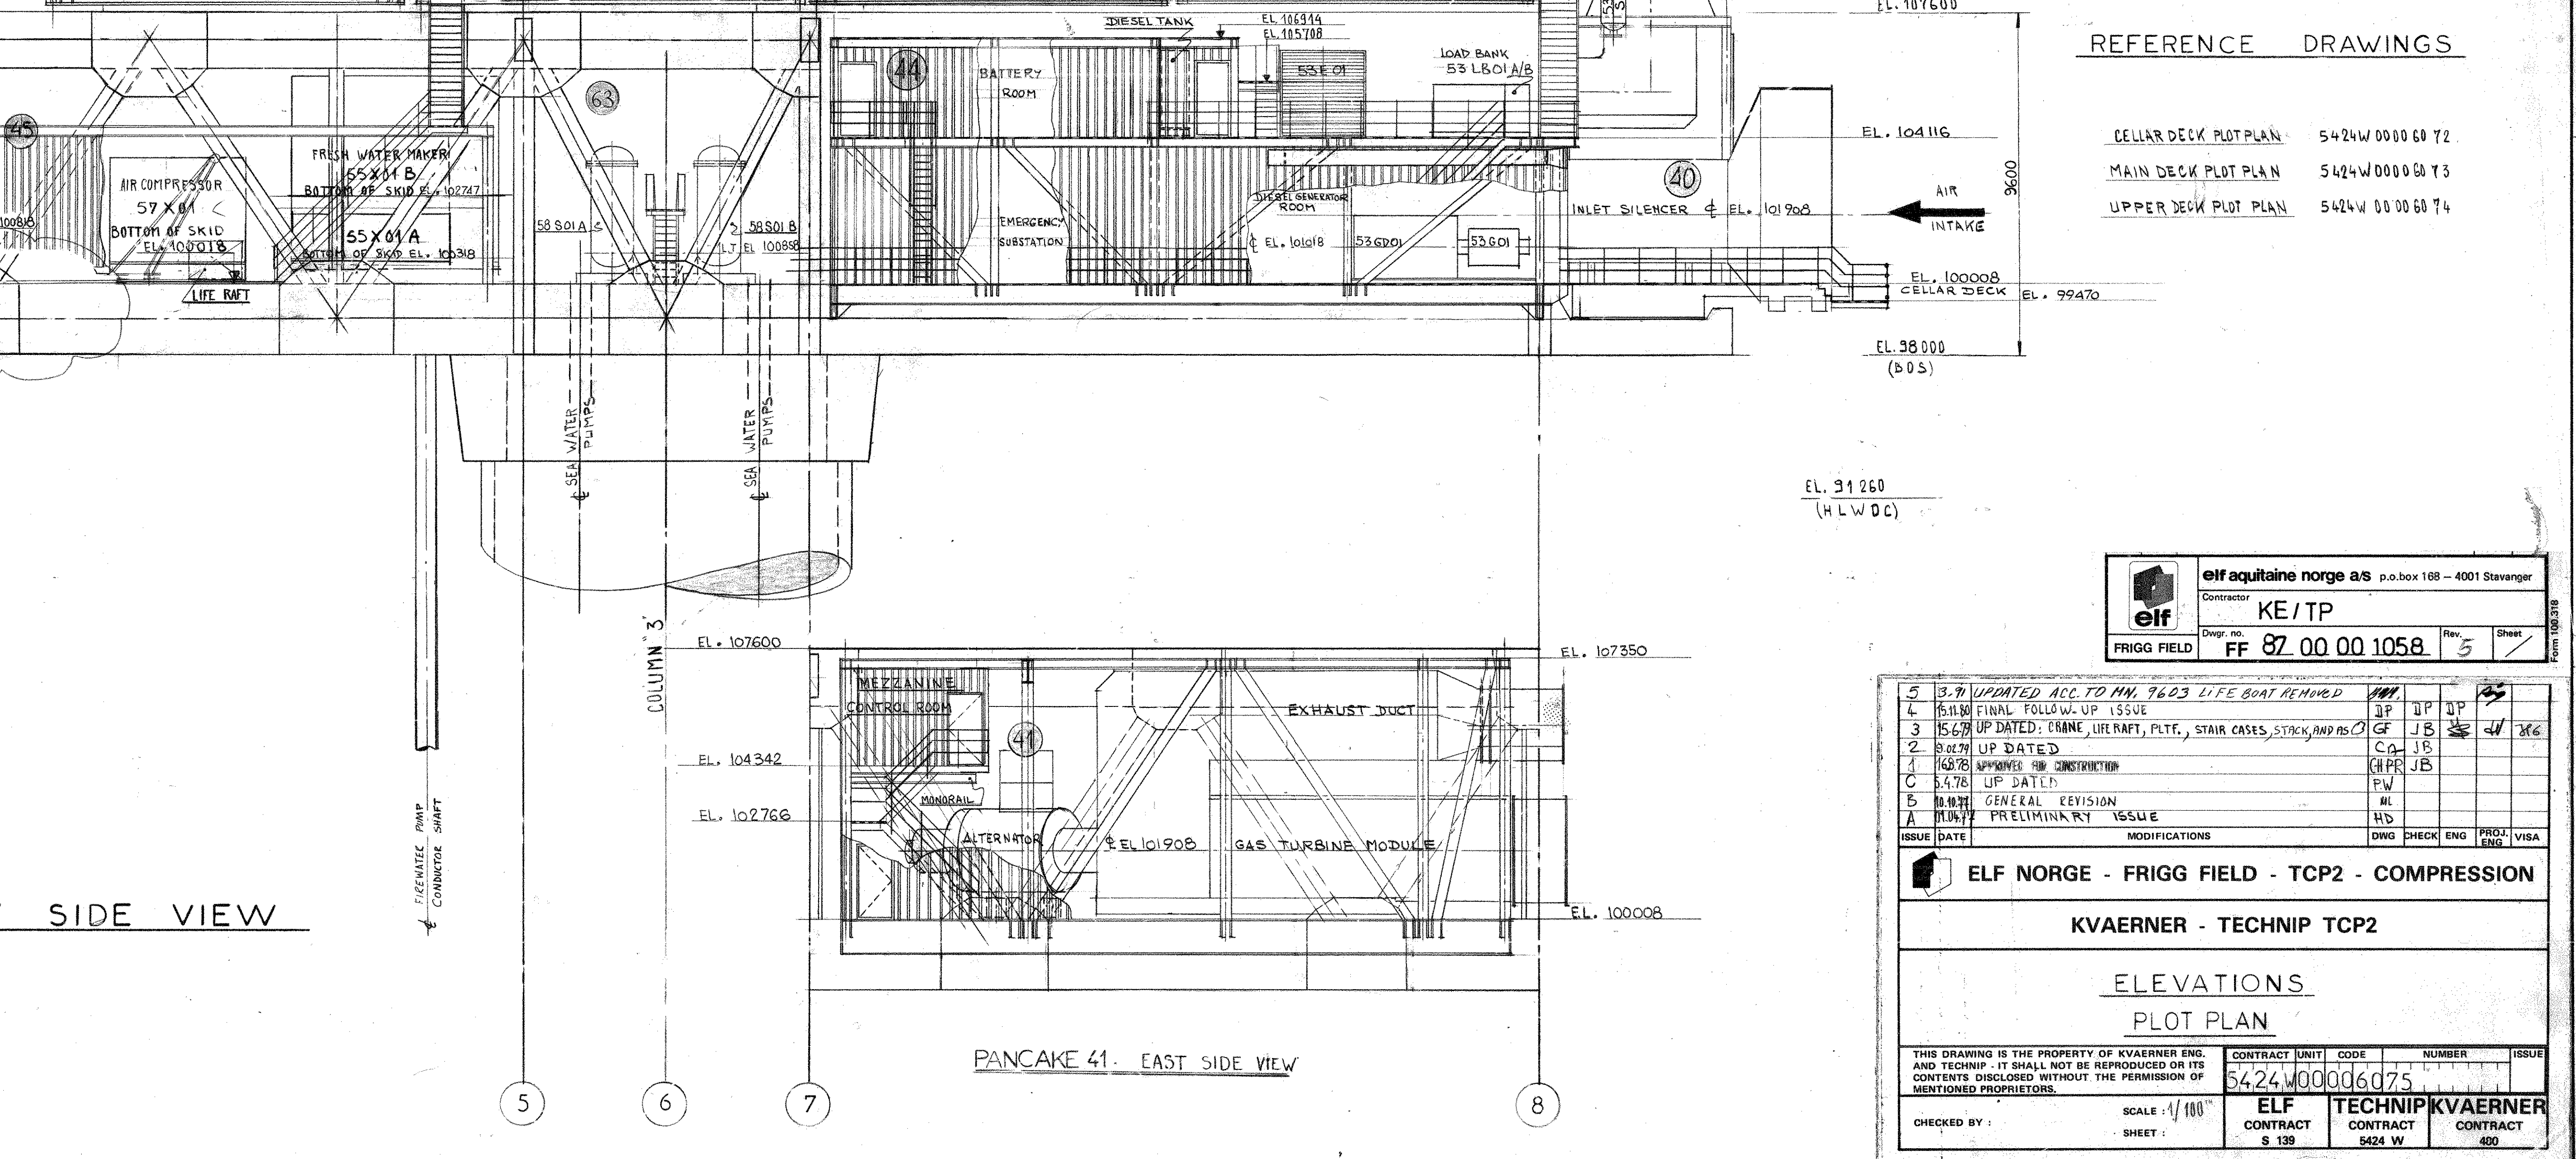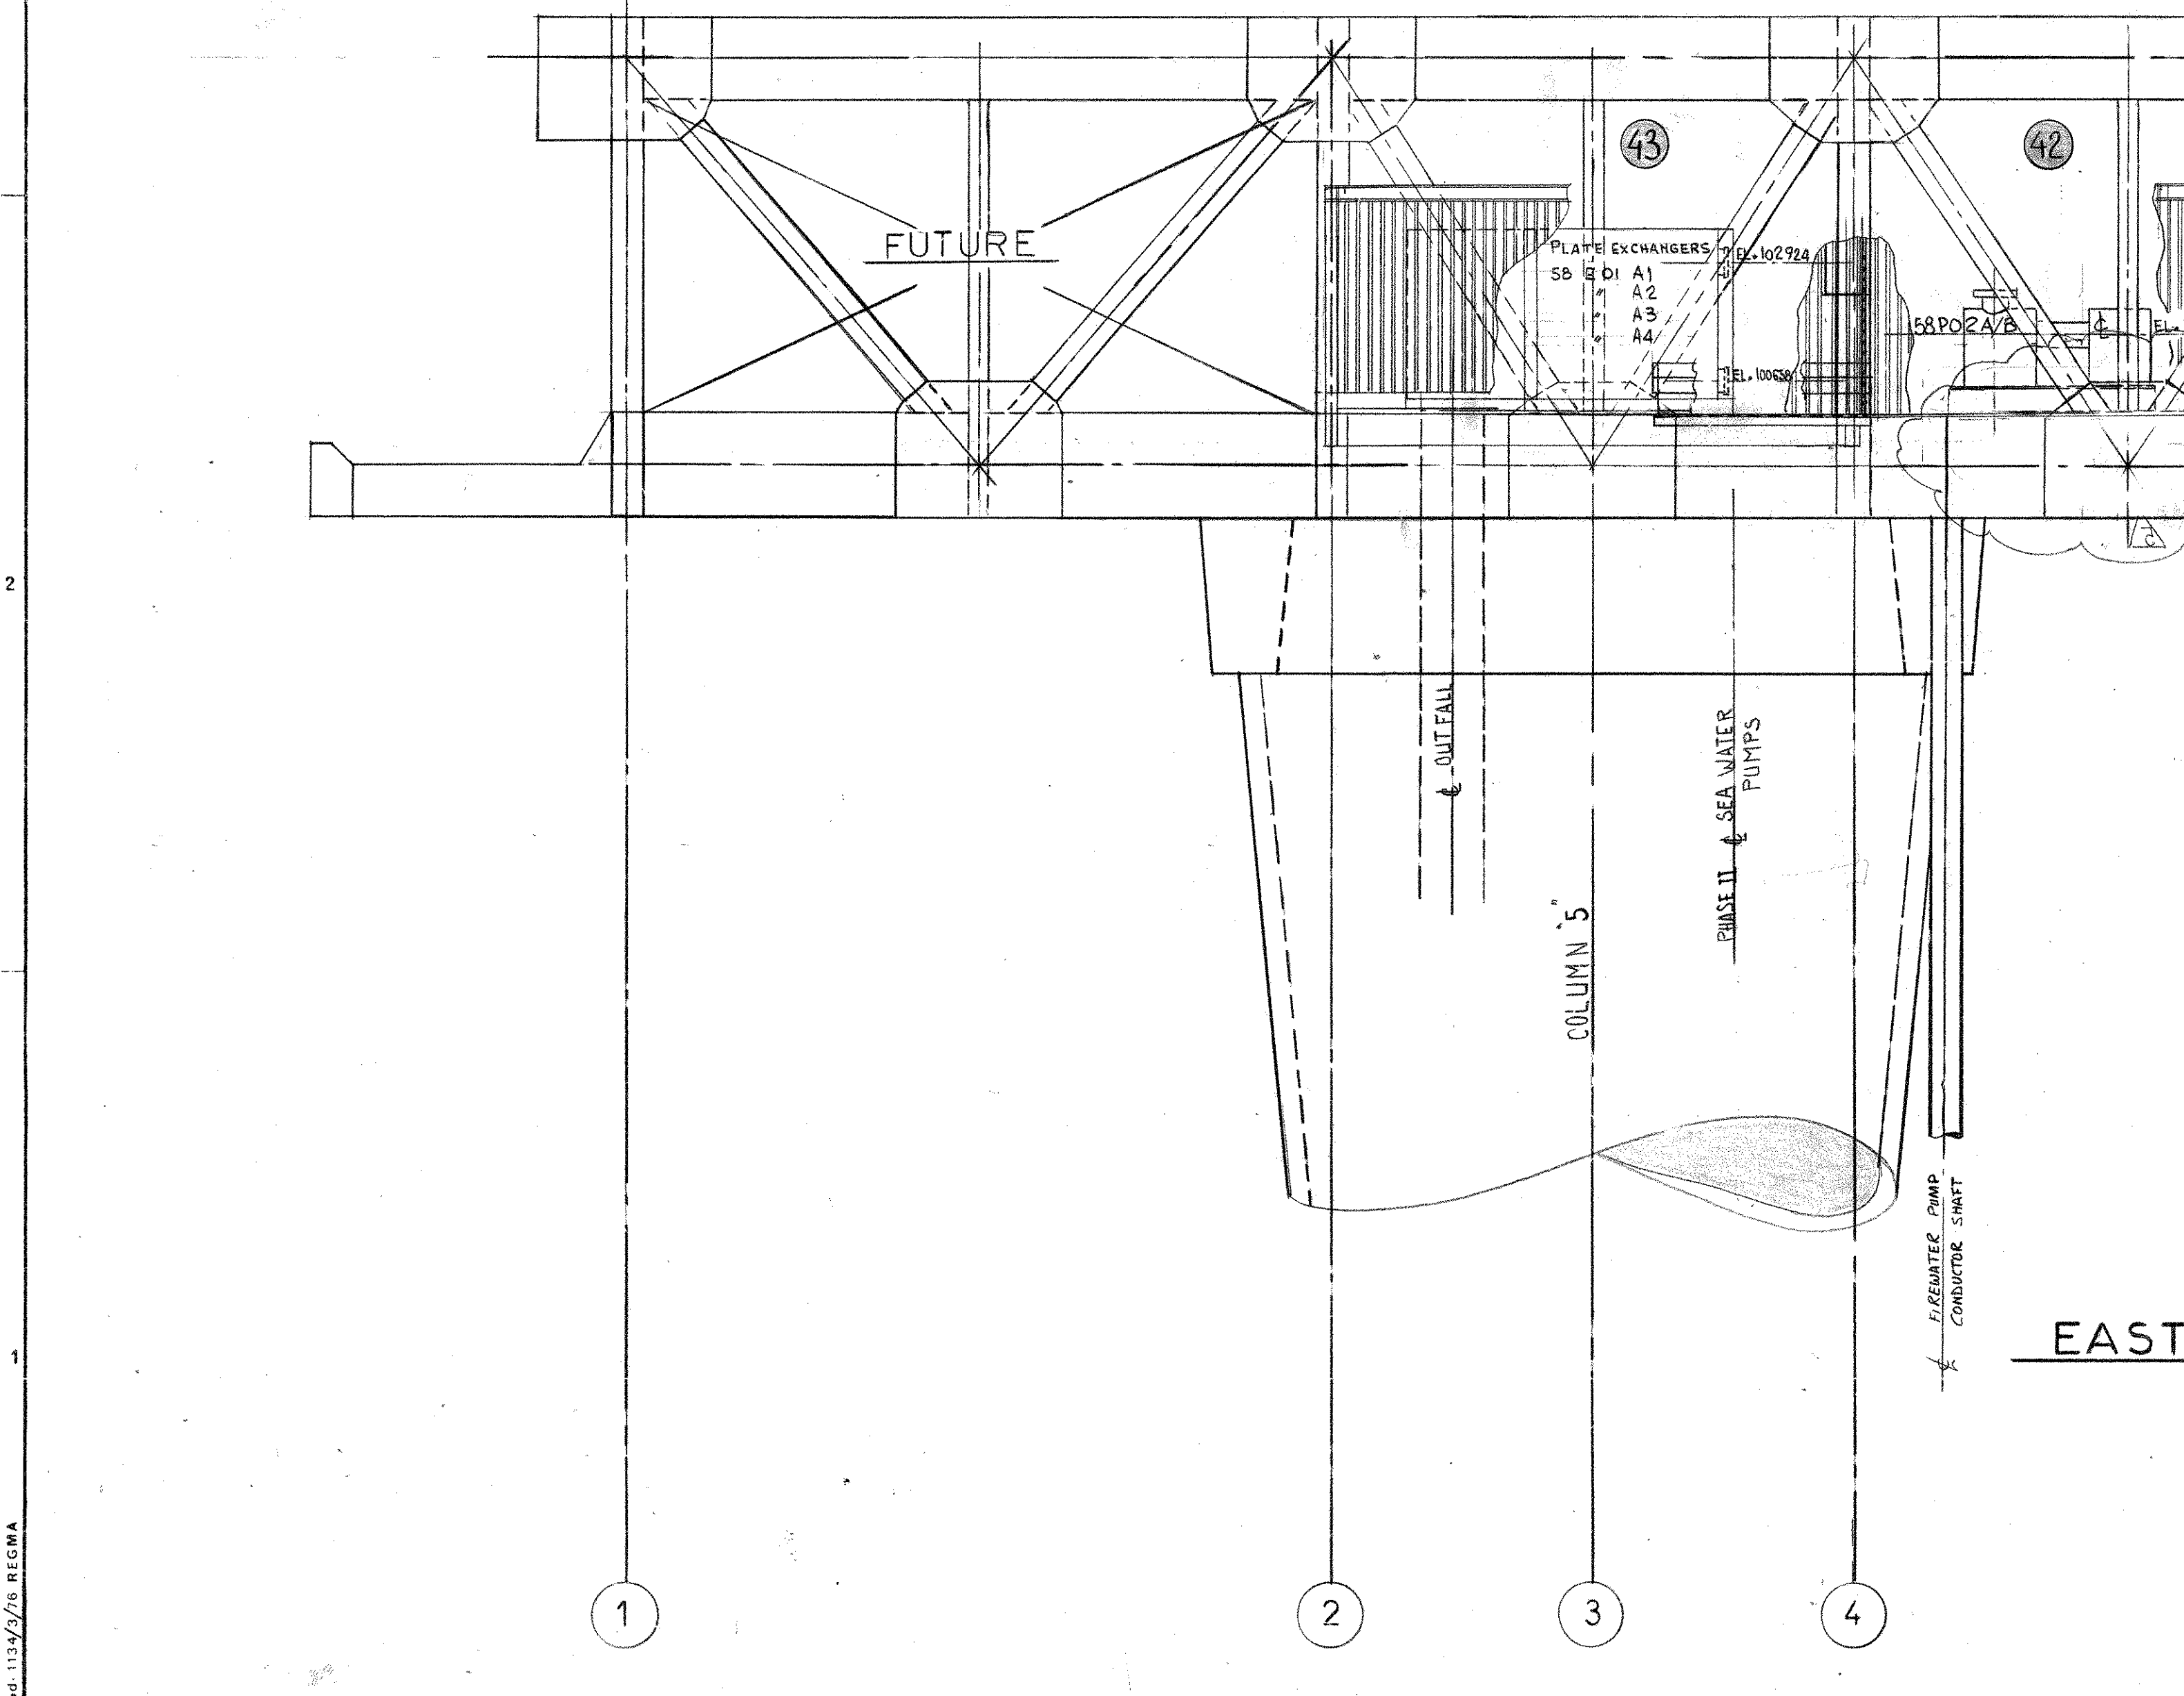

elf aquitaine norge as p.o. box 168 - 4001 Stavanger
 Contractor **KE/TP**
 Project No. **FF 87 00 00 1058** Rev. 5

5	3.7. UPDATED ACC TO MM 7623 LIFE BOAT REVISED	VP	VP	VP
4	5.10.01 FINAL FOLLOW UP ISSUE	JP	JP	JP
3	15.02.01 UP DATED: FRAME, LIFE RAFT, PLATE, STAIR CASES, STOCK AND RS	CF	JP	VP
2	2.02.01 UP DATED	CA	JP	VP
1	1.02.01 APPROVED FOR CONSTRUCTION	CF	JP	VP
C	5.4.78 UP DATED	VP	VP	VP
B	0.0.0.0 GENERAL REVISION	VP	VP	VP
A	0.0.0.0 PRELIMINARY ISSUE	VP	VP	VP
DATE	MODIFICATIONS	DWG	CHECK	ENG

ELF NORGE - FRIGG FIELD - TCP2 - COMPRESSION

KVAERNER - TECHNIP TCP2

ELEVATIONS PLOT PLAN

THIS DRAWING IS THE PROPERTY OF KVAERNER ENG. AND TECHNIP. IT SHALL NOT BE REPRODUCED OR ITS CONTENTS DISCLOSED WITHOUT THE PERMISSION OF MENTIONED PROPRIETORS.

CONTRACT UNIT CODE NUMBER ISSUE
5424W00006075

CHECKED BY: **ELF TECHNIPKVAERNER**
 SHEET: **CONTRACT S 139 CONTRACT 5424 W CONTRACT 400**