DWG. NO. ELN 2111 | SHEET NO. 7022

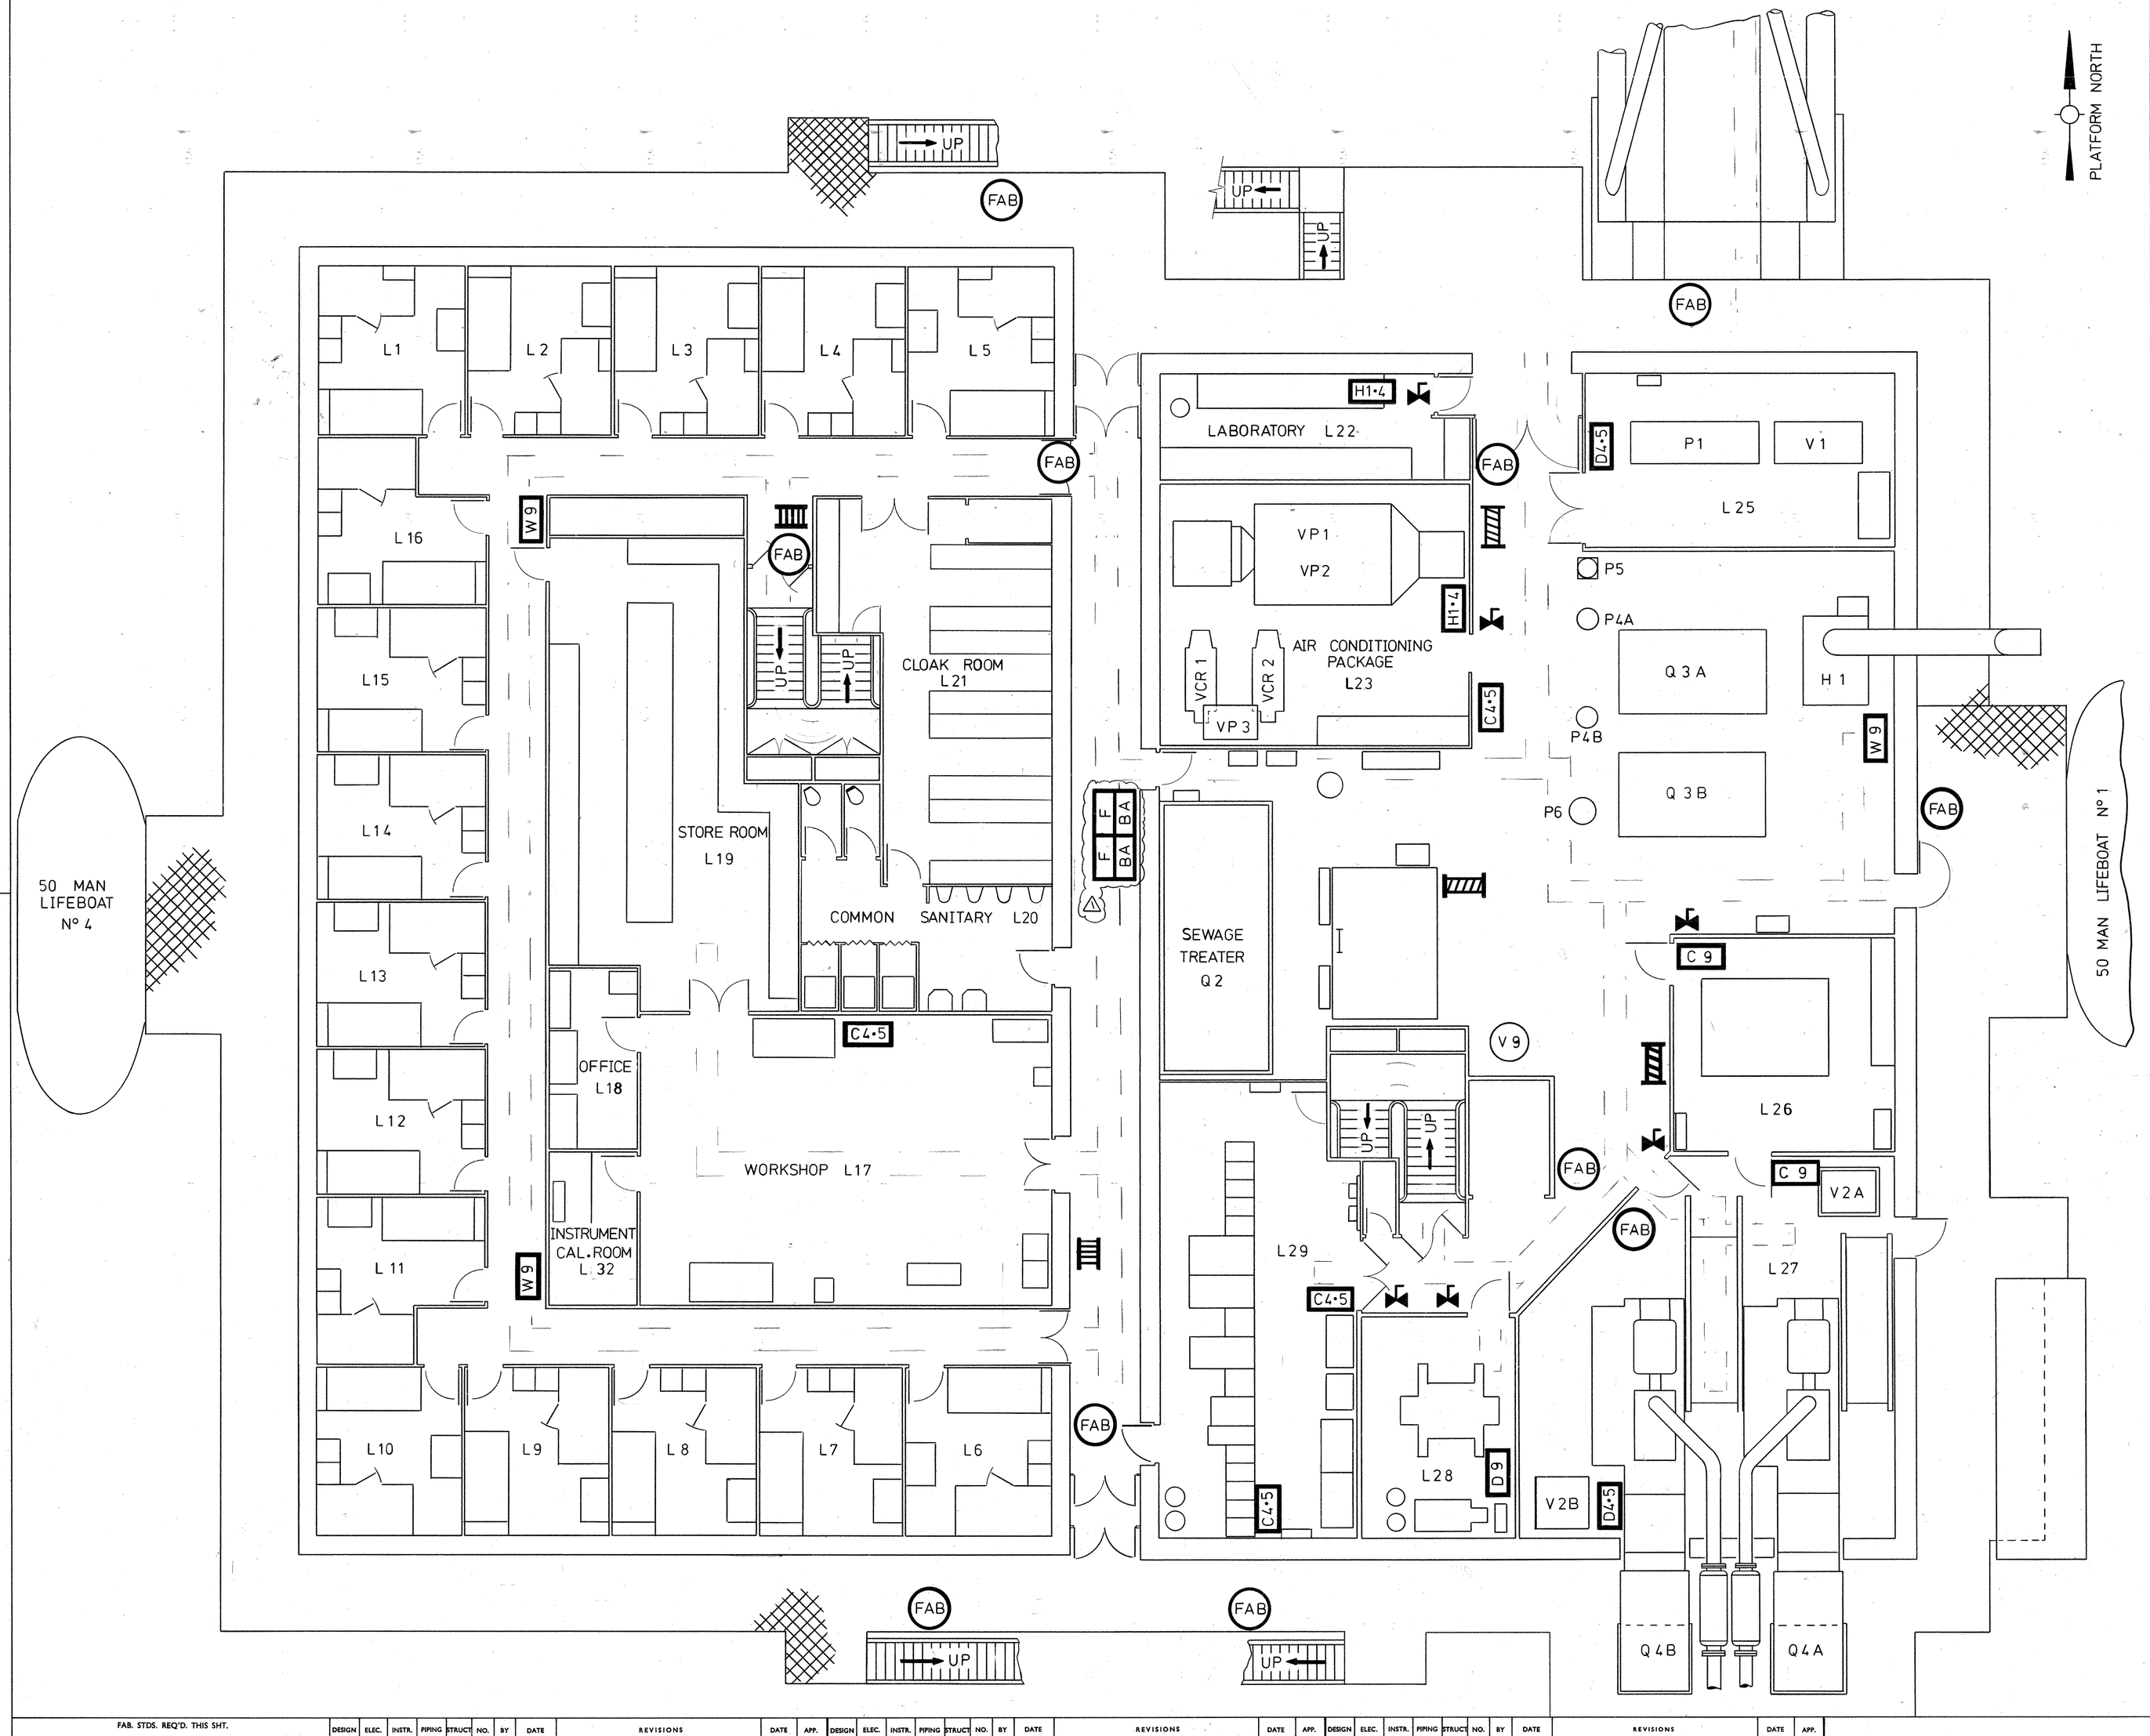

LEGEND

- H1.4 — 1.4 Kg. HALON FIRE EXTINGUISHER
- W9 — 9 Kg. WATER FIRE EXTINGUISHER
- D4.5 — 4.5 Kg. DRY CHEMICAL FIRE EXTINGUISHER
- D9 — 9 Kg. DRY CHEMICAL FIRE EXTINGUISHER
- D68 — 68 Kg. DRY CHEMICAL FIRE EXTINGUISHER
- C4.5 — 4.5 Kg. FIRE EXTINGUISHER CO_2
- C9 — 9 Kg. FIRE EXTINGUISHER CO_2
- C13.6 — 13.6 Kg. FIRE EXTINGUISHER CO_2
- FIRE WATER MONITOR
- WASHDOWN HOSE REEL
- FIRE WATER HOSE REEL
- F — WATER/FOAM HOSE REEL
- C — DRY CHEMICAL HOSE REEL
- BREAK GLASS UNIT - HALON MANUAL RELEASE
- MANUAL START STATION - WATER DELUGE (VESSEL NUMBER IN BRACKETS)
- WFR — WATER/FOAM RELEASE LEVER FOR FIRE PUMP START
- PR — POWER RELEASE LEVER
- ESD — ESD BUTTON
- FAB — FIRE ALARM BUTTON (ALARM & FIRE PUMP START)
- FB — FIRE BLANKET
- F — FIREMANS OUTFIT
- BA — BREATHING APPARATUS
- M — MUSTER ALARM
- EQUIPMENT COVERED WITH WATER DELUGE
- COMPARTMENTS COVERED WITH HALON
- ESCAPE ROUTES

AS BUILT
TO INFORMATION RECEIVED UP TO DEC 1977

FAB. STDS. REQ'D. THIS SHT.

DESIGN	ELEC.	INSTR.	PIPING	STRUCT	NO.	BY	DATE	REVISIONS	DATE	APP.