


GRID NORTH
331° 03' 06"

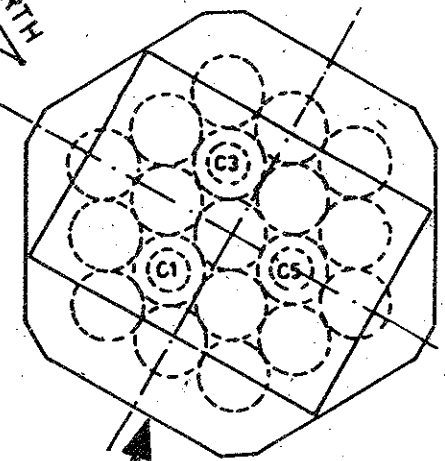

KEY PLAN

PLATFORM NORTH

Rev.	Date	Description	By	App.	Contractor
02	10/87	NEW PIPELINES INSTALLED IN JS AND J7 1/4" PLASTIC BUNDLE INST. REF. SST. 87803/87804 PROT. BAR ON J7 REMOVED. REF TO SST 6077	OTB	M	TEMEX
1	7.5.87		TB		
0	03/85	First issue	J.P.		
04	10/89	REMOVAL OF THE BOTTOM OF THE CENTRAL 16" UTILITY RISER ON SHAFT-3. REF. SST. 89005	OTB	J.C.T.	
03	12/88	EE. ELGABLES & UMBILICAL INST.	OTB	J.C.T.	
rev.	date	DESCRIPTION	by	app.	

elf
aquitaine
norge a/s
P.O. Box 188
4001 Stavanger

NOTES	
Installation	TCP-2 System
Job no.	
Scale	NTS
Drwg. no.	FF 85. 36. 25. 0519
Rev.	04
Sheet	1/2

GENERAL - PERSPECTIVE VIEW
SOUTH-WEST SIDE