DWG. NO. ELN 02020 | SHEET NO. 120

elf norge a.s
dwg no: FF 931.210.023
rev. :0 date: 09.10.74
PLANT NORTH item:

NOTES

1. DIMENSIONS SHOWN IN [ ] BRACKETS ARE METRIC EQUIVALENTS IN MILLIMETRES
2. ALL MATERIAL TO BE HIGH STRENGTH STEEL EXCEPT 14" Ø (355.6) BUOYANCY TANKS WHICH ARE TO BE MILD STEEL UNLESS NOTED.

REF DWGS NOS

McD-H DWGS:-

CONDUCTOR GUIDE FRAMING	ELN 02020 SHEET 125
BUOYANCY TANKS	ELN 02020 SHT 146
CONDUCTOR GUIDE FRMG AT 41'Ø GUIDE	ELN 02020 SHT 150

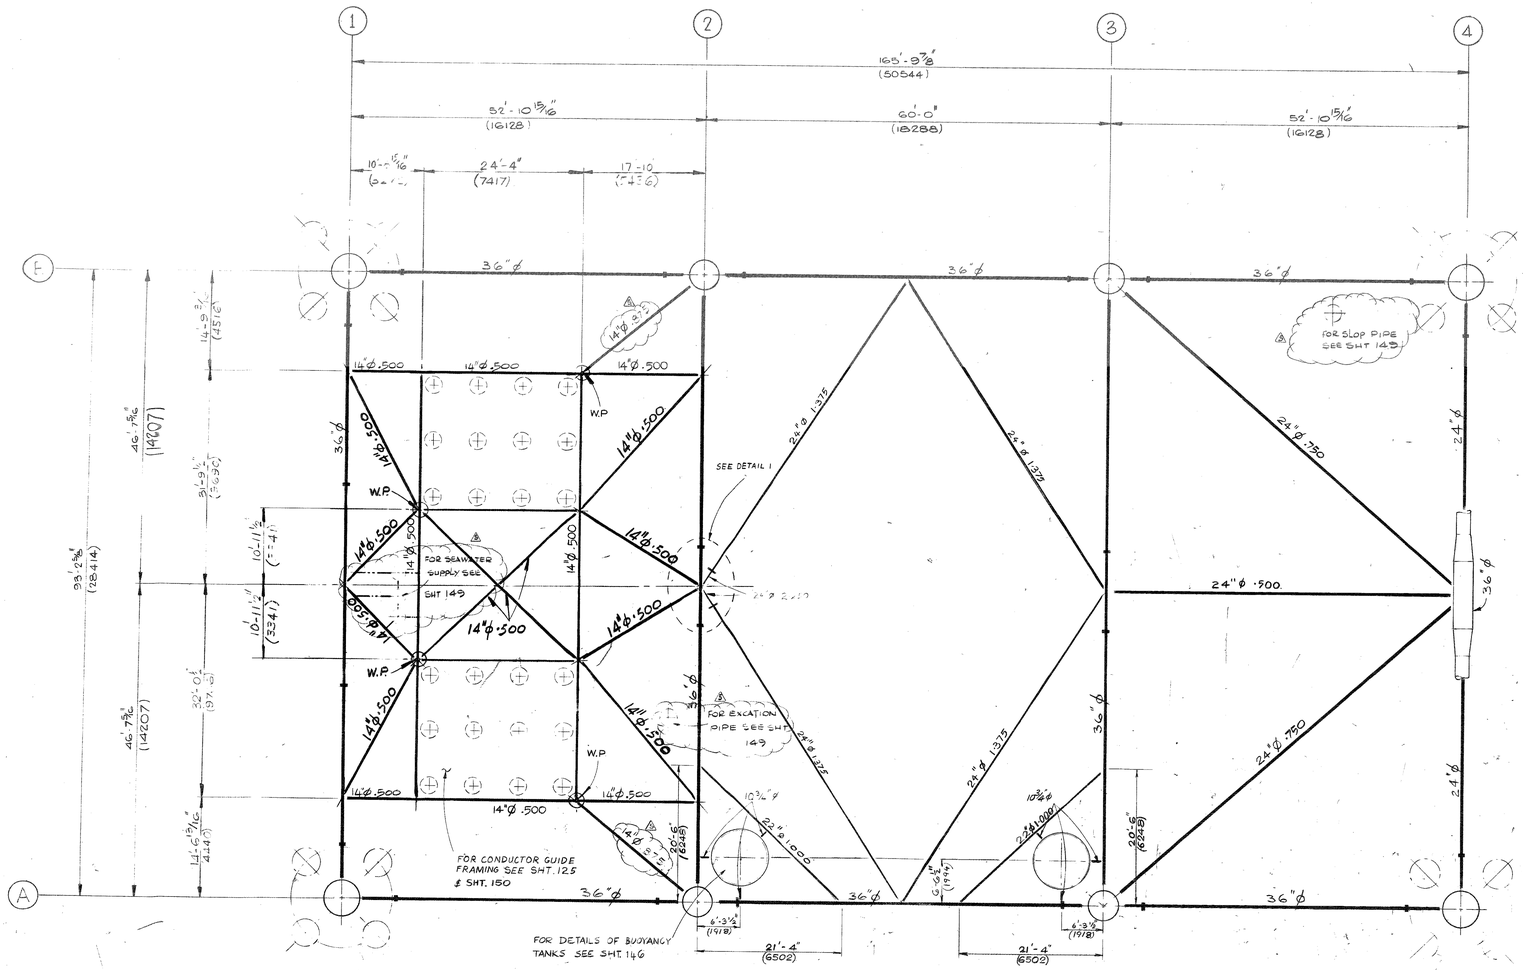

HORIZONTAL FRAMING EL (-) 38'-11" (℄ OF PIPES)
(11861)

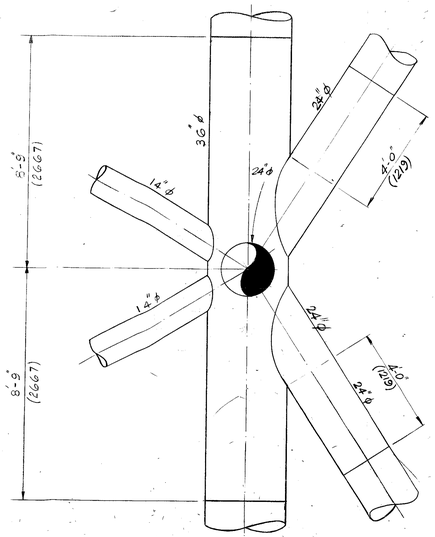

DETAIL 1
SCALE: 1/2" : 1'-0

SCALES :-
0 5 10 15 20 25
1/8" : 1'2"

elf norge a.s
dwg no: FF 931.210.023
rev. :0 date: 09.10.74
item:

ELF-NORGE A/S
NORWAY
24 WELL SELF CONTAINED
DRILLING PLATFORM No 1
NORTH SEA FRIGG FIELD WD 98 M
McDERMOTT – HUDSON
LONDON — ENGLAND

APPROVED
Mc DERMOTT — HUDSON
DATE 10/5/73

ENGINEERS APPROVAL

	BY	DATE
PROJECT		
STRUCTURES		
PROCESS		
MECHANICAL		
ELECTRICAL		
INSTRUMENT		
PIPING		
PROP. CHECK		

DRAWN BY	SCALE	DATE	DWG. NO.
D. MINTY	1/8" : 1'2"	26 FEB 73	ELN 02020
DESIGNED BY P. MAYER			SHEET NO. 120

HORIZONTAL FRAMING EL(-)38'-11"

FAB. STDS. REQ'D. THIS SHT.

DESIGN	STRUCT	PIPING	ELEC.	MK.	BY	DATE	REVISIONS	DATE	APP

DESIGN	STRUCT	PIPING	ELEC	MK.	BY	DATE	REVISIONS	DATE	APP
				5	MO	1/4/74	SEAWATER SLOPE EXCATION PIPES ADDED - ISO 1828 DWG. NO. 1828-1-200	11/4/74	

DESIGN	STRUCT	PIPING	ELEC	MK.	BY	DATE	REVISIONS	DATE	APP
				4	CAP	30-7-73	DIMS TO BUOYANCY TANKS ADDED, DIM CHANGED AT CONDUCTOR GUIDE FRMG, 3 STIFFENERS ADDED TO 24"Ø 1.375	9/10/73	
				3	AS	25-7-73	BUOYANCY TANKS STEELMORE ADDED	6/9/73	
				2	ET	12-4-73	CHANGED FROM 26 DIA TO 30 DIA CONDUCTOR	10/5/73	
				1	MH	13-3-73	CHANGED FROM 5 PILE TO 4 PILE GROUP	16/5/73	

S & H LTD 2622