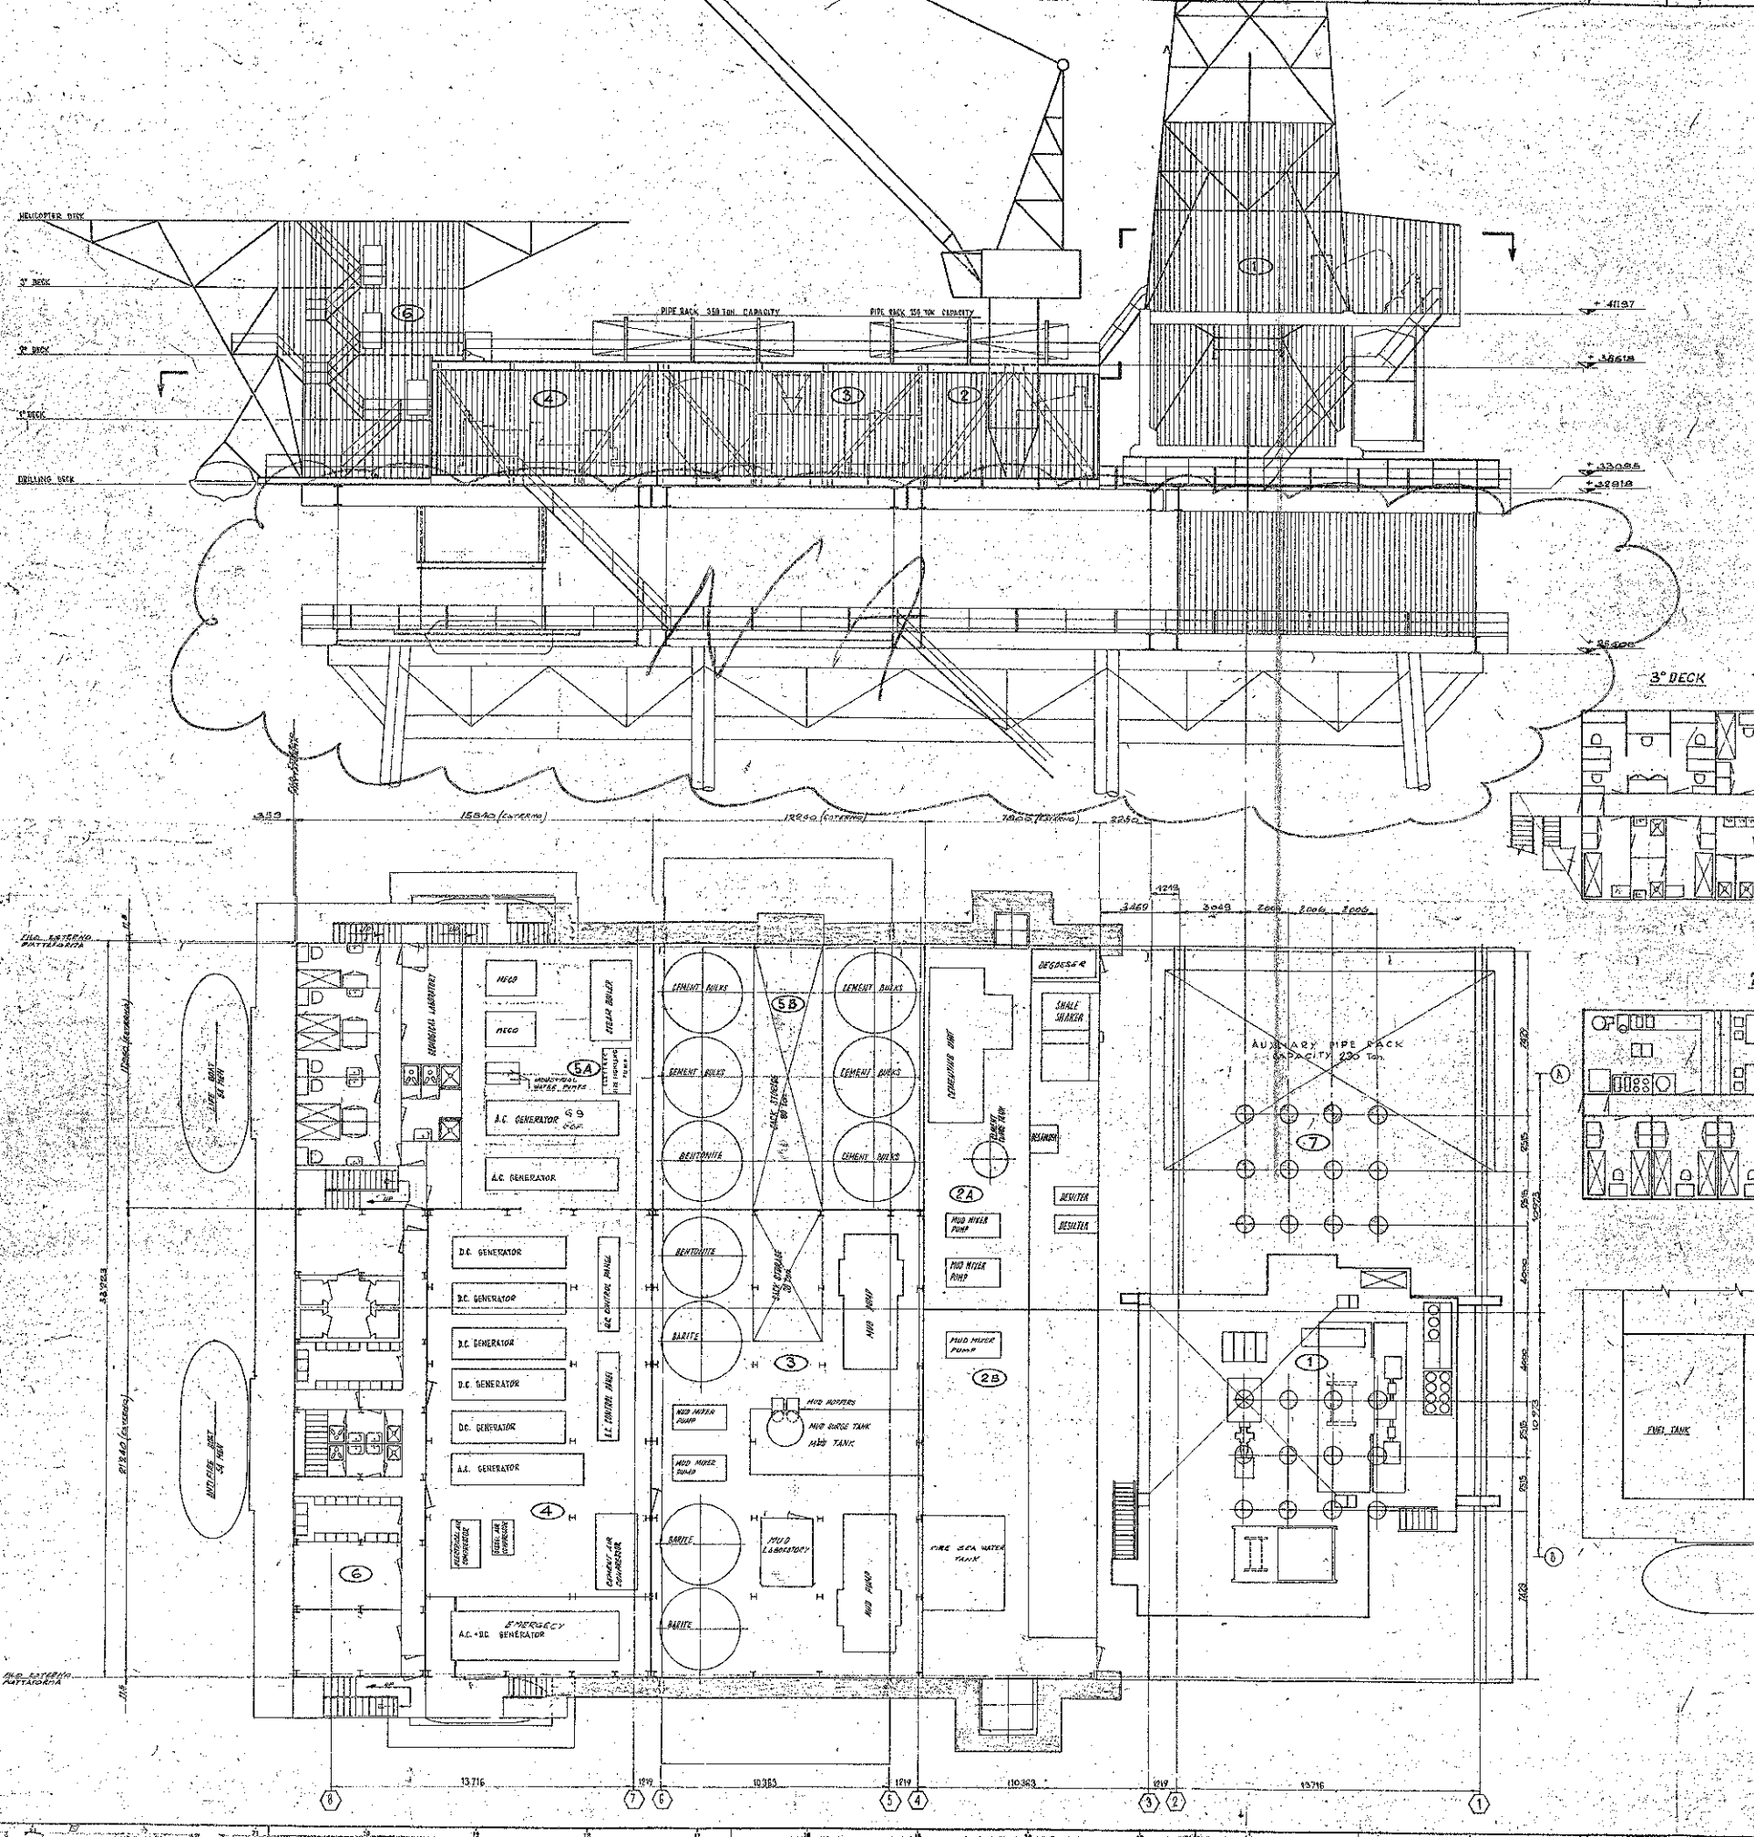

PACKAGE N° (1) 17.5 × 17.54

ITEM	DESCRIPTION	QT.Y	WEIGHT EMPTY	WEIGHT LOAD	TYPE	OVERALL DIMENSIONS L	W	H
1	CROWN BLOCK L.C. MOORE	1	6		500-7.5L			
2	DERRICK	1	45		161'-30"	39'	30'	147'
3	DERRICK SUBSTRUCTURE	1	110			39'	39'	39'
4	SKIDDING STRUCTURE	1	30			97'	39'	47'3"
5	B.O.P. CONTROL PANNE	1	5		E168-5-BS	6.00	1.00	1.50
6	DRAWWORK EMSCO 2000 HP	1	58		C3 TYPE II	7.19	5.50	1.95
7	ROTARY TABLE NATIONAL	1	16		C-275	2.5	1.48	0.75
8	SWIVEL EMSCO	1	9		LA 400			
9	SKIDDING HYDRAULIC EQUIPMENT 100 T	1 SET	3		50" STROKE	-	-	-
10	SCHLUMBERGER UNIT	1	15		DWL-E	4.95	2.50	2.55
11	WIRE ROPE SPOOLER	1	10			2.56	2.00	2.53
12	WIND WALL	1	10					
13	TRAVELLING BLOCK	1	12			1.50	0.80	2.40
14	MANIFOLD AND STAND PIPE	1	3					
15	DEAD END NATIONAL	1	1		E	1.55	0.5	1.09
16	AIR HOIST INGERSOLL RAND	2	1		KOIL	1.00	0.5	1.10
17	AIR HOIST GARDEN DENVER	2			NHK			
18	DEY BACK PANNEL	1	1					
19	DEY BACK CAPACITY			226				
20	CASING CAPACITY			367				
21	COOLING WATER TANK	1	8	58	50 m³	3.50	2.40	1.40
22	CHOKE MANIFOLD	1	6					
23	POSSUM BELLY	1	1					
24	WATER BOMBS	2	0.5					
25	AIR TANK	1	0.5			2.40	0.82	
26	WARE HOUSE	1	10			6.40	4.00	2.40
	TOTAL WEIGHT		368	646				

PACKAGE N° (2A) 16.80 × 7.80 × 5.70

1	STEEL STRUCTURE W/ PIPE RACK SECTION	1	86	245.4		16.80	7.80	5.70
2	MUDD TANK	1	15	225	150 m³	14.5	4.46	2.52
3	SHALE SHAKER HUTCHINSON	4	4		DSC-48-36	4.98	1.30	1.80
4	DE SANDER	1	5		8 CONES	1.20C	1.20	1.70
5	DE SILTER DEMCO	2	5		416	0.88	0.8	1.5
6	DE GASSER	1	5		DEGASS 200	5.20	1.40	0.90
7	ELECTRIC MUD MIXER LIGHTNING	3	2		5.5 HP			
8	CEMENTING UNIT DOWELL-SCHLU.	1	15		4T 60	7.00	4.70	2.75
9	BARYTE STORAGE TANK	1	45		100 m³ (5 of 20 m³)			
10	GRADE UNIT MARINER	1	20	35.5 m³	MODIFIED			
11	CRANE PEDESTAL	1	12					
12	CENTRIFUGAL MUD PUMP MISSION	2	9		8x8 E	2.50	1.20	1.60
	TOTAL WEIGHT		195.5	350.4				

PACKAGE N° (2B) 16.80 × 7.80 × 5.70

1	STEEL STRUCTURE W/ PIPE RACK SECTION	1	86	116.4		16.80	7.80	5.70
2	ANTIFIRE SEA WATER TANK	1	15	90	80 m³	8.00	3.75	6.00
3	ELECTRIC FIRE-FIGHTING PUMP	1	5			3.00	0.80	1.40
4	CRANE NATIONAL	1	36	44.1 m³	85.455			
5	CRANE PEDESTAL	1	12					
6	MUD TANK	1	10	225				
7	CENTRIFUGAL MUD MIXER PUMP MISSION	1	3.0					
8	DIESEL FIRE-FIGHTING PUMP	1	6					
	TOTAL WEIGHT		183.0	475.5				

PACKAGE N° (3) 21.2 ×

ITEM	DESCRIPTION	QT.Y	WEIGHT EMPTY	WEIGHT LOAD	TYPE	OVERALL DIMENSIONS L	W	H
1	STEEL STRUCTURE W/PIPE RACK SECTION	1	150	208.5		21.20	17.60	5.70
2	ACTIVE MUD TANK	1	42	140	70 m³	8.40	3.50	2.50
3	MUD PUMPS EMSCO	2	80		8 1/2	6.50	2.65	3.50
4	CENTRIFUGAL MUD PUMPS MISSION	2	7		6 x 8 E	2.50	1.20	1.60
5	ELECTRIC MUD MIXER LIGHTNING	2	1		5.5 HP			
6	BULKS STORAGE	4	50	220		23.40		4.70
7	MUD SUCTION TANK	1	1		3 m³	2.40	1.15	
8	MUD HOPPERS	2	0.5		0.6 m³			
9	MANIFOLD PUMP 5000 PSI W.P.	1 SET	1		4 1/2"			
10	CONVEYOR BELT FOR SACKS	1	1			5.00	0.60	1.95
11	SACK STORAGE AREA		30					
12	MUD LABORATORY	1	1.5	0.5				
	TOTAL WEIGHT		278	569				

PACKAGE N° (4) 21,24 × 10,24 × 5.70

1	STEEL STRUCTURE W/PIPE RACK SECTION	1	150	245		21.24	10.24	5.70
2	D.C. GENERATOR W/EXITER	5	55		430 KW 518 A	2.40	1.50	2.40
3	A.C. GENERATOR W/EXITER	1	17		430 KW 518 A	2.50	1.42	2.40
4	D.C. + A.C. GENERATOR W/EXITER	1	14		430 KW 518 A	2.40	1.42	2.40
5	DIESEL AIR COMPRESSOR	1	1					
6	ELECTRIC AIR COMPRESSOR	1	1					
7	D.C. CONTROL PANEL	1	5		6KW	3.40	1.07	2.20
8	A.C. CONTROL PANEL	1	2					
9	A.C. EMERGENCY CONTROL PANEL	1	2					
10	CEMENT AIR COMPRESSOR	1	3.5			3.50	1.50	1.60
11	DAILY FUEL TANK	1	3	7	1 m³	4.00	2.00	1.50
12	AIR TANK	2	1			2.50	0.80	0.80
13	FUEL PUMP	1	0.05		3 cm³ KW1			
14	CLEANER	1	0.08					
15	AIR FILTER	1	0.08					
16	PRESSURIZATION SYSTEM	1 SET	10			14.00	1.55	2.00
	TOTAL WEIGHT		274.86	452				

PACKAGE N° (5A) 15.84 × 11.36 × 5.70

1	STEEL STRUCTURE W/PIPE RACK SECTION	1	150	245		15.84	11.36	5.70
2	INDUSTRIAL WATER TANK	1	15	100	100 m³	2.5	2.2	2.2
3	FUEL TANK	1	20	150	150 m³	5.5	2.5	2.5
4	STEAM BOILER	1	3		CLAYTON 3.5	1.93	1.93	2.50
5	DISTILLATING WECO UNIT	2	10		300 BBL/D	2.11	2.60	2.60
6	A.C. GENERATOR	2	24		CAT 3.406	3.20	1.52	1.70
7	LIFE RAFT W/ SUPPORT (50 MEN)	1	5					
8	ADDITIONAL TO MEN LIVING QUARTER W/ELECTRICAL LABORATORY AND AIR CONDITIONING ROOM	1				18	15	2.80
9	HYDRAULIC WATER PUMPS	2	2			1.5	0.8	0.8
	TOTAL WEIGHT		212	868				

PACKAGE N° (5B) 12.24 × 10.56 × 5.70

1	STEEL STRUCTURE W/PIPE RACK SECTION	1	80	170		12.24	10.56	5.70
2	BULKS STORAGE	4	50	220	PNEUMATIC	23.40		4.70
3	SACK STORAGE AREA		30					
	TOTAL WEIGHT		160	390				

PACKAGE N° (6) 28.3 × 28.3 × 12.1 LODGING QUARTERS

DRILLING DECK								
	DRINKABLE WATER TANK 100 m³		100					
	FUEL TANK 65 m³		60					
	WORK SHOP							
	WATER PRESSURE TANK							
	WARE HOUSE							
	54 MEN ANTIFIRE LIFE BOAT W/SUPPORT							
1° DECK								
	KEEPER							
	DRY FOOD STORAGE		15					
	WAREHOUSE							
	LAUNDRY							
	AIR CONDITION EQUIPMENT							
2° DECK								
	KITCHEN							
	DINNING ROOM							
	INFIRMARY							
	N° 2 RES ROOM 2 MEN							
	N° 8 RES ROOM 4 MEN							
	BATHS AN SERVICE							
	STORAGE ROOM							
3° DECK								
	N° 2 RES ROOM W/SERVICE 1 MEN							
	N° 7 RES ROOM 4 MEN							
	BATHS AND SERVICE							
	CONTRACTOR OFFICE							
	RADIO OFFICE							
	HELICOPTER DECK W/ FLOORING						28.3	28.3
	FIRE-FIGHTING SYSTEM (CAPACITY SIMULTAN N-2 OF DRILLER)							
	PERSONNEL (N. 52 MEN)	5						
	TOTAL WEIGHT		820	980				

PACKAGE N° (7)

	AUXILIARY PIPE RACK 240 TON CAPACITY		20	230				
	GENERAL TOTAL							

N.B. 700 TON PIPE RACK CAPACITY PLACED ON THE ROOF OF THE PACKAGE

REV.	DATA	MODIFICHE	DISEGN.	CONTR.	APPROV.
S	26-5-75	BRUCATO LIST LOAD (PACKAGE N°6)			
R	5-2-74	REVISED			
P	15.2.74	HOOKS PREARRANGING ROOM N° PACKAGE 4			
O	1-2-74	REVISIONE GENERALE			
I	28-11-73	REVISIONE GENERALE			
C	31-10-73	EMISSIONE			

SAIPEM — MILANO - ITALIA — SERVIZIO TED — DIS. J 211 b-1-

FIXED PLATFORM FRIGG FIELD

LAYOUT

N. ARCH. —

INDICE —

SCALA 1:100

SOSTITUISCE N.

SOSTITUITO DAL