DWG. NO. ELN 2099 | SHEET NO. 2415.

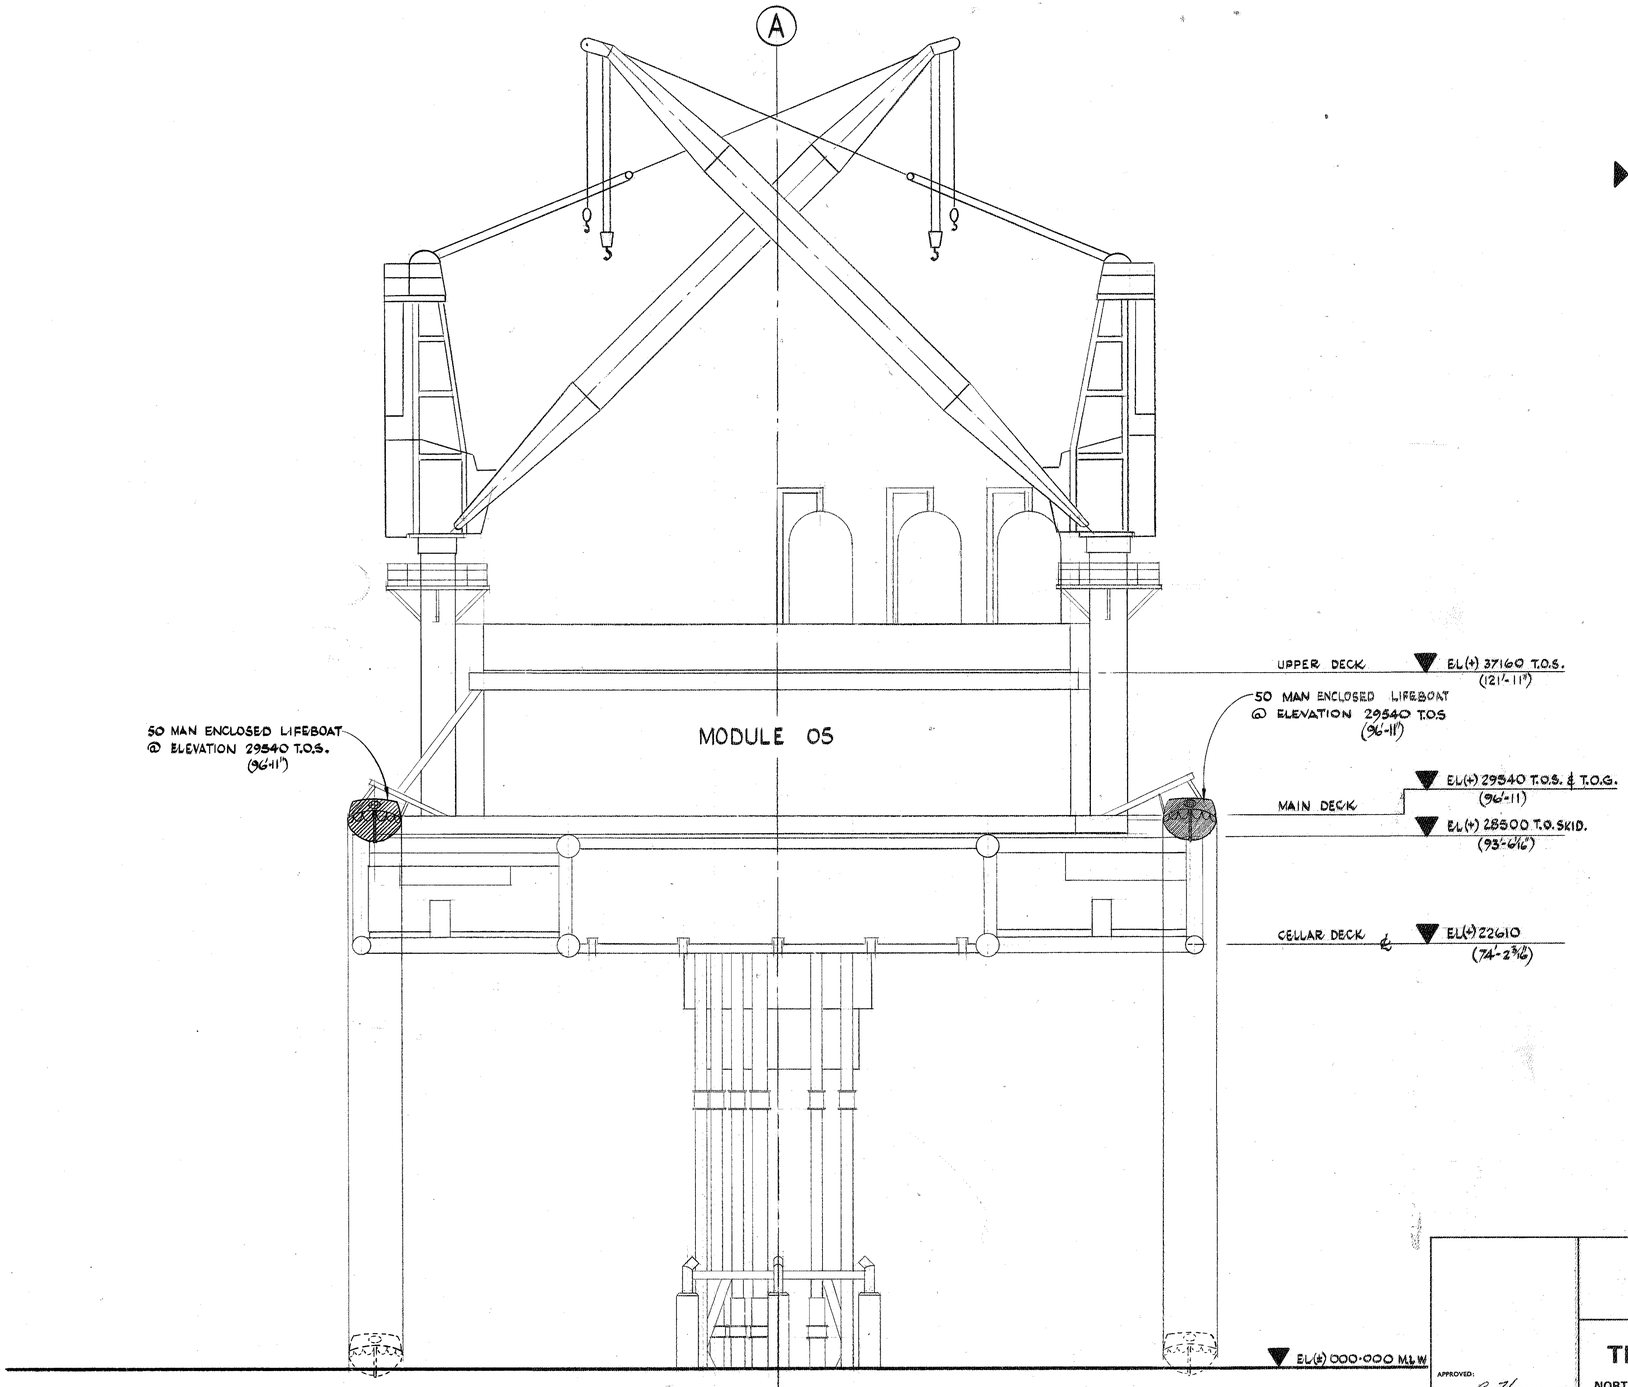

SOUTH ELEVATION ON T.P.1. SHOWING LOCATION OF LIFEBOATS

SCALE 1:150.

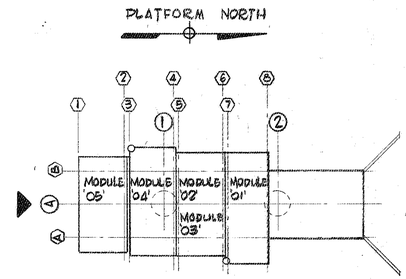

KEY PLAN

REFERENCE DRAWINGS

LOCATION OF LIFEBOATS SHT 1 OF 3. } FF.95.21. 23.3005

LOCATION OF LIFEBOATS SHT 2 OF 3. } FF.95.21 23.3006

rev.	date	DESCRIPTION	by	app.
0	19/11-80	RENUMBERING	NOS	[illegible]

elf aquitaine norge a/s p.o.box 168 – 4001 Stavanger

Contractor

FRIGG FIELD | Dwgr. no. FF 95212 33007 | Rev. 0 | Sheet

Form 100.318

APPROVED: B. Homaye

DATE: 24-5-76

ENGINEERS APPROVAL

	BY	DATE
PROJECT		
STRUCTURAL	BH.	24-5-76
PROCESS		
MECHANICAL		
ELECTRICAL		
INSTRUMENT		
FAB. CHECK	R.B.	21 MAY 76
PROP. CHECK		

ELF-NORGE A/S NORWAY

TREATMENT PLATFORM No1

NORTH SEA | FRIGG FIELD | W.D. 104-M

McDERMOTT-HUDSON

LONDON – ENGLAND

DRAWN BY	SCALE	DATE	DWG. NO.
K.W. SNOWDON	AS NOTED	18TH MAY 76	ELN 2099
DESIGNED BY BH.			SHEET NO. 2415

LOCATION OF LIFEBOATS SHT. 3 OF 3.

AS BUILT

TO INFORMATION RECEIVED UP TO OCTOBER 77

FAB. STDS. REQ'D. THIS SHT

DESIGN	ELEC.	INSTR.	PIPING	STRUCT	NO.	BY	DATE	REVISIONS	DATE	APP.	DESIGN	ELEC.	INSTR.	PIPING	STRUCT	NO.	BY	DATE	REVISIONS	DATE	APP.
															FB	1	ER	14/10/77	REVISED TO SUIT AS BUILT CONDITION	10/1/77	[illegible]

U.D.O.