




SECTION BB
(Scale 1/100)

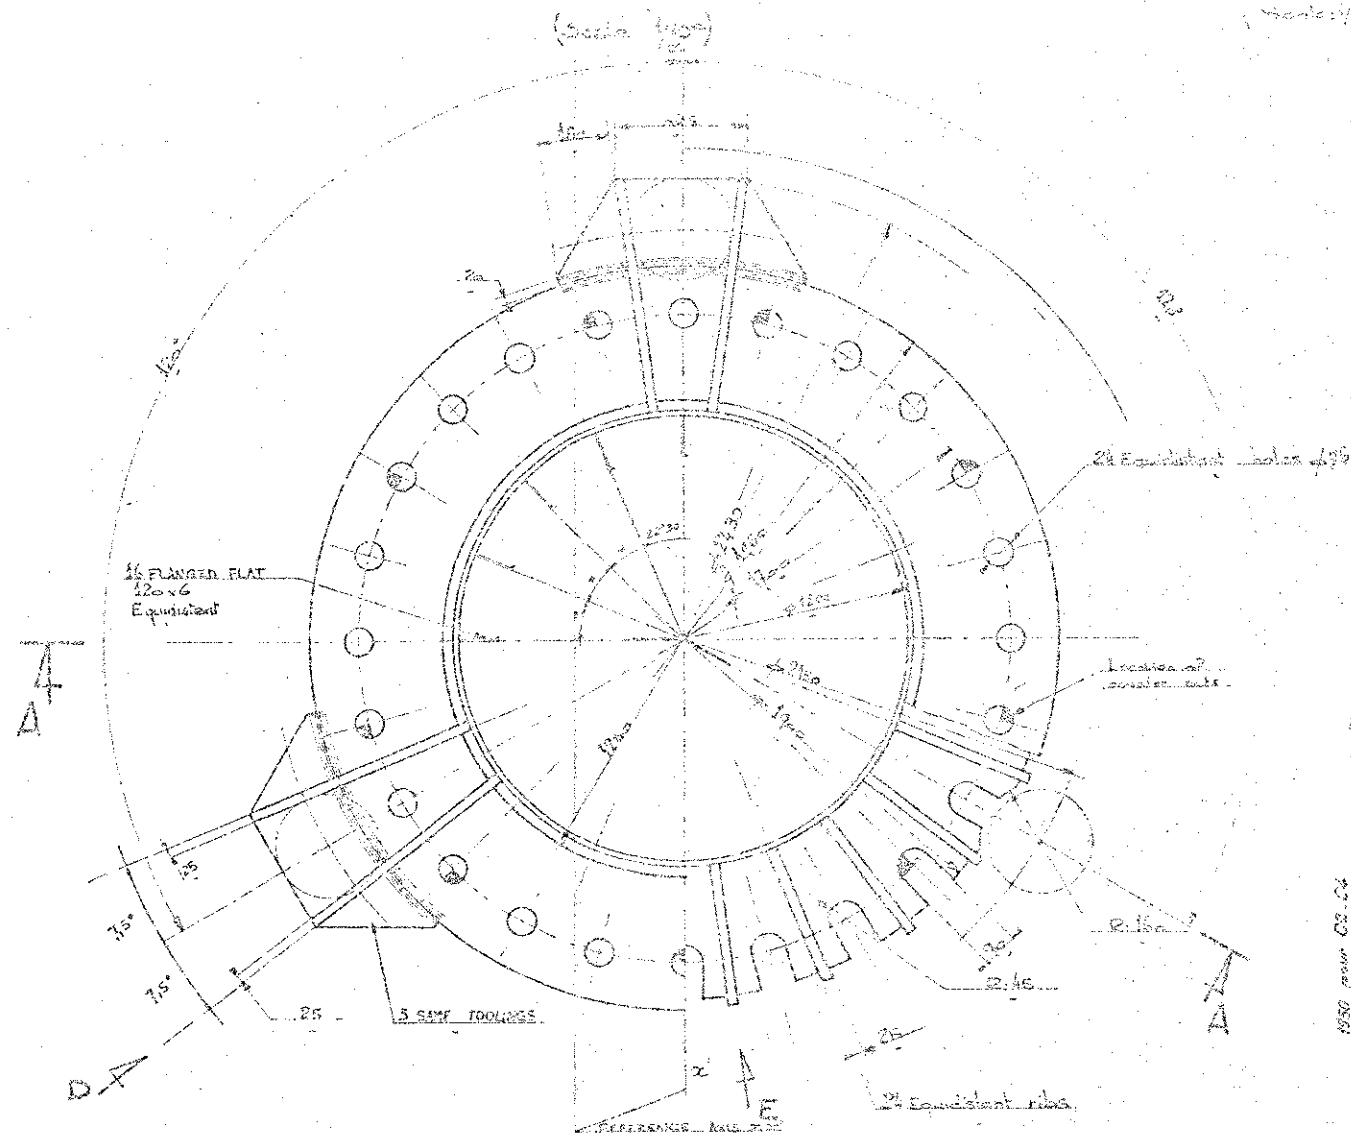


VIEW E
(Scale 1/10)

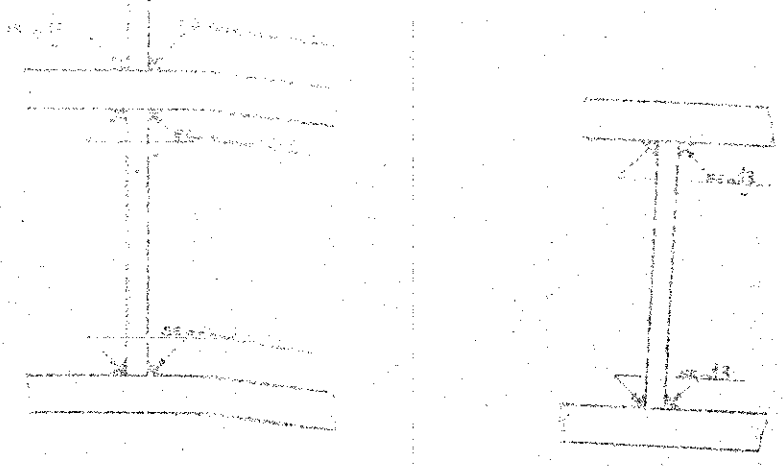



SECTION AA
(Scale 1/100)

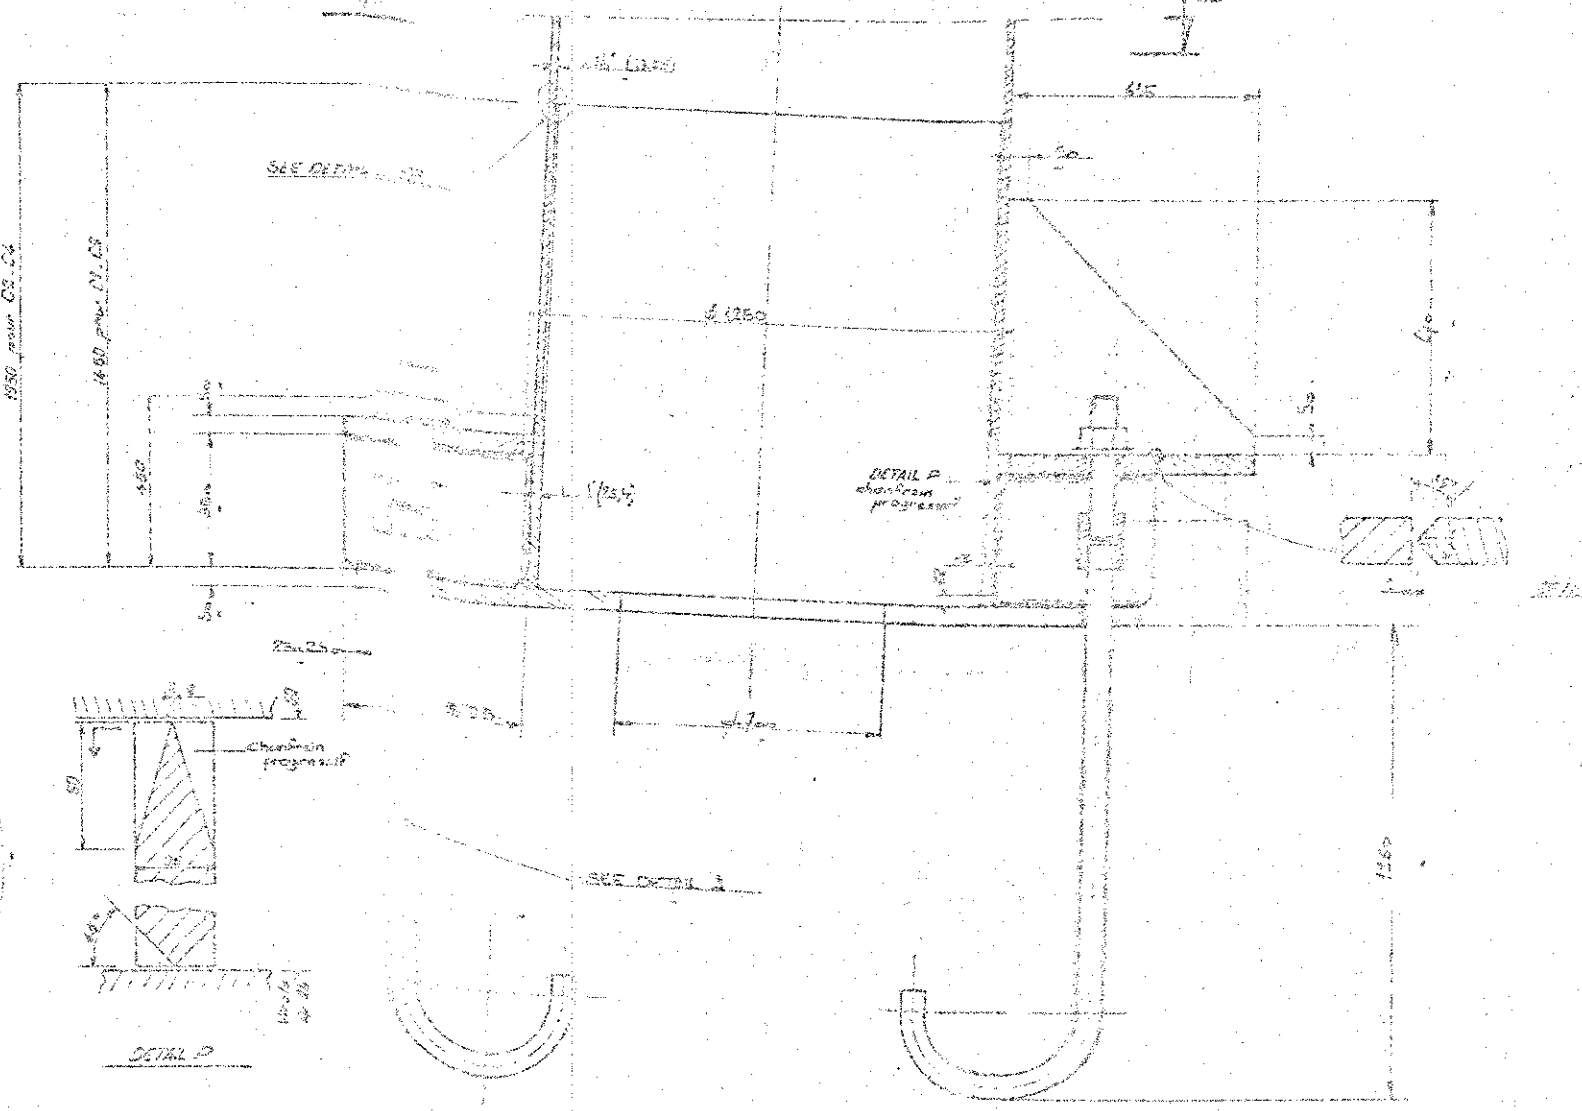

DETAIL A
Scale 1/2

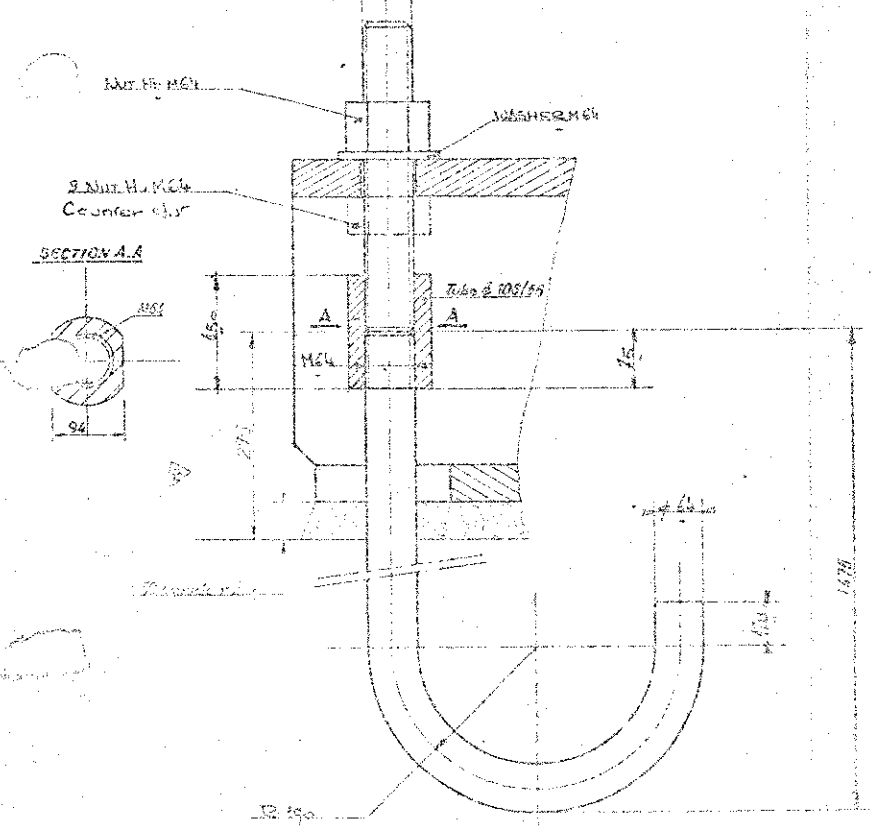

DETAIL B
Scale 1/4

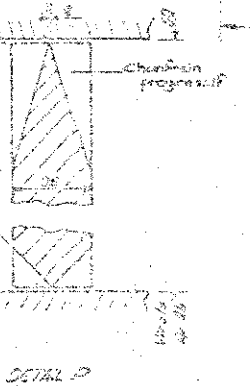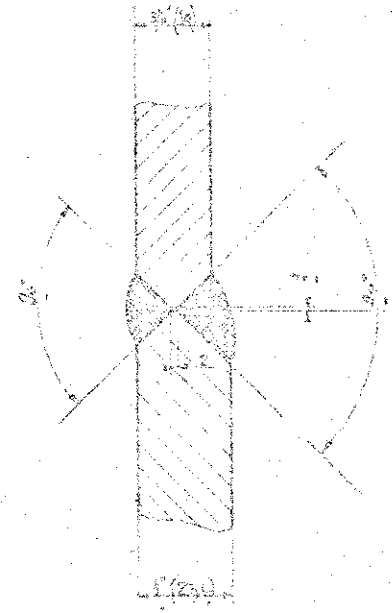

MP 1
CP 1
TOTAL OIL MARINE LIMITED
1970

REFERENCE DRAWINGS		REVISIONS	
NUMBER	DATE	BY	DESCRIPTION

MP 1
CP 1
12 1/2