DWG. NO. ELN2111 | SHEET NO. 797

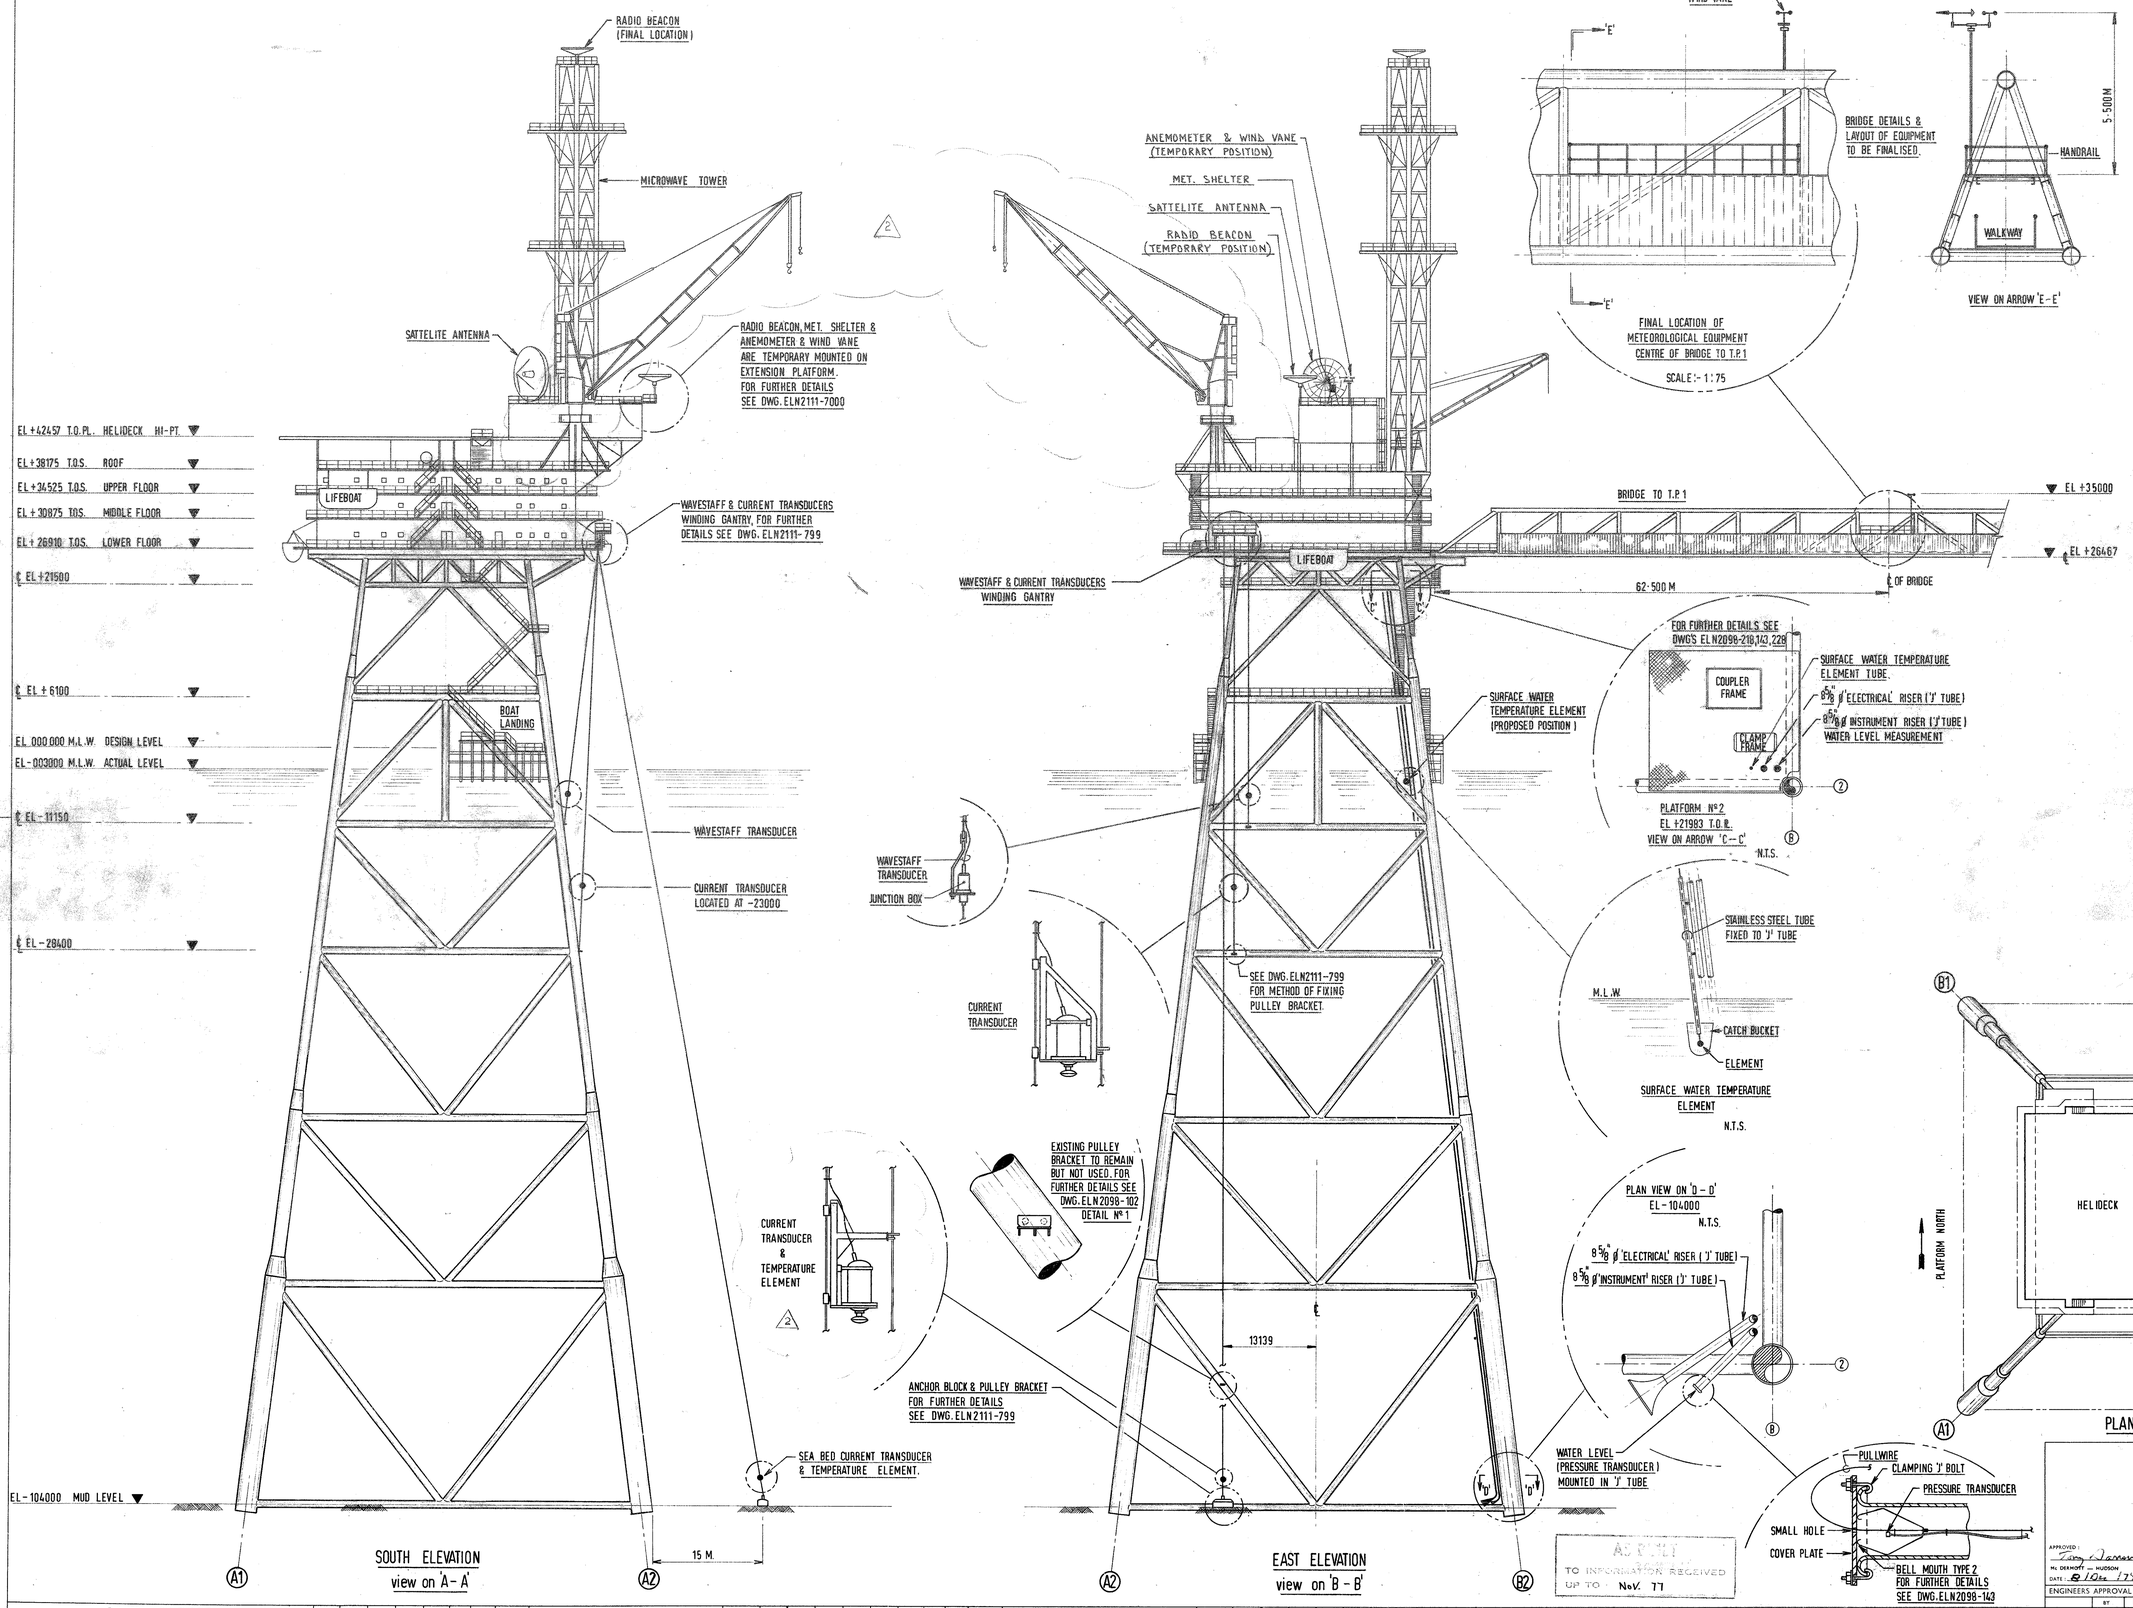

KEY PLAN

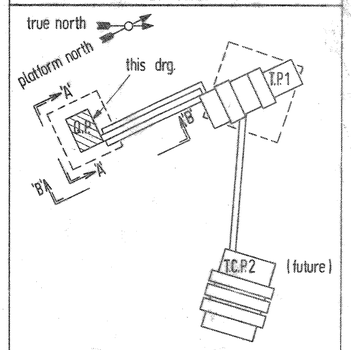

GENERAL NOTES

1. ALL ELEVATIONS ARE FROM DESIGN LEVEL

REFERENCE DRAWINGS

DWG. Nº	SHT. Nº	TITLE
ELN2111	799	WAVESTAFF & CURRENT TRANSD. WINDING GANTRY
"	754	OCEANOGRAPHIC & MET. EQUIP. INSTALLATION
"	7000	" " "

AS BUILT
TO INFORMATION RECEIVED UP TO : Nov. 77

FAB. STDS. REQ'D. THIS SHT	DESIGN	ELEC.	INSTR.	PIPING	STRUCT	NO.	BY	DATE	REVISIONS	DATE	APP.
						2	D.M	18-11-77	REVISED TO 'CONEX' DWGS. CRANE REVISED AS SHOWN & DWG. ISSUED AS BUILT.	30-11-77	DEF
						1	G.P.	24-11-75	ISSUED FOR APPROVAL	6.12.75	GP
						0	G.P.	30-10-75	ISSUED FOR PINK		

SUBMITTED FOR APPROVAL

	BY	DATE
APPROVED:		
Mc DERMOTT — HUDSON		
DATE: 8 Dec 75		
ENGINEERS APPROVAL		
PROJECT	[illegible]	8 Dec 75
STRUCTURAL	[illegible]	5-12-75
PROCESS		
MECHANICAL		
ELECTRICAL	[illegible]	24.11.75
INSTRUMENT	[illegible]	24.11.75
PAB. CHECK	[illegible]	24 Nov 75
PROP. CHECK	[illegible]	24 Nov 75

ELF - NORGE
FRIGG FIELD

QUARTERS PLATFORM
NORTH SEA — JOB 1-40-D2 — W.D.104 M

McDERMOTT — HUDSON
LONDON — ENGLAND

DRAWN BY	SCALE	DATE	DWG NO.
G.Patterson	1:300	23-10-75	ELN2111
DESIGNED BY K. Townshend			SHEET NO. 797

Oceanographic & Meteorological Equipment Installation layout

GAV 5408/72