
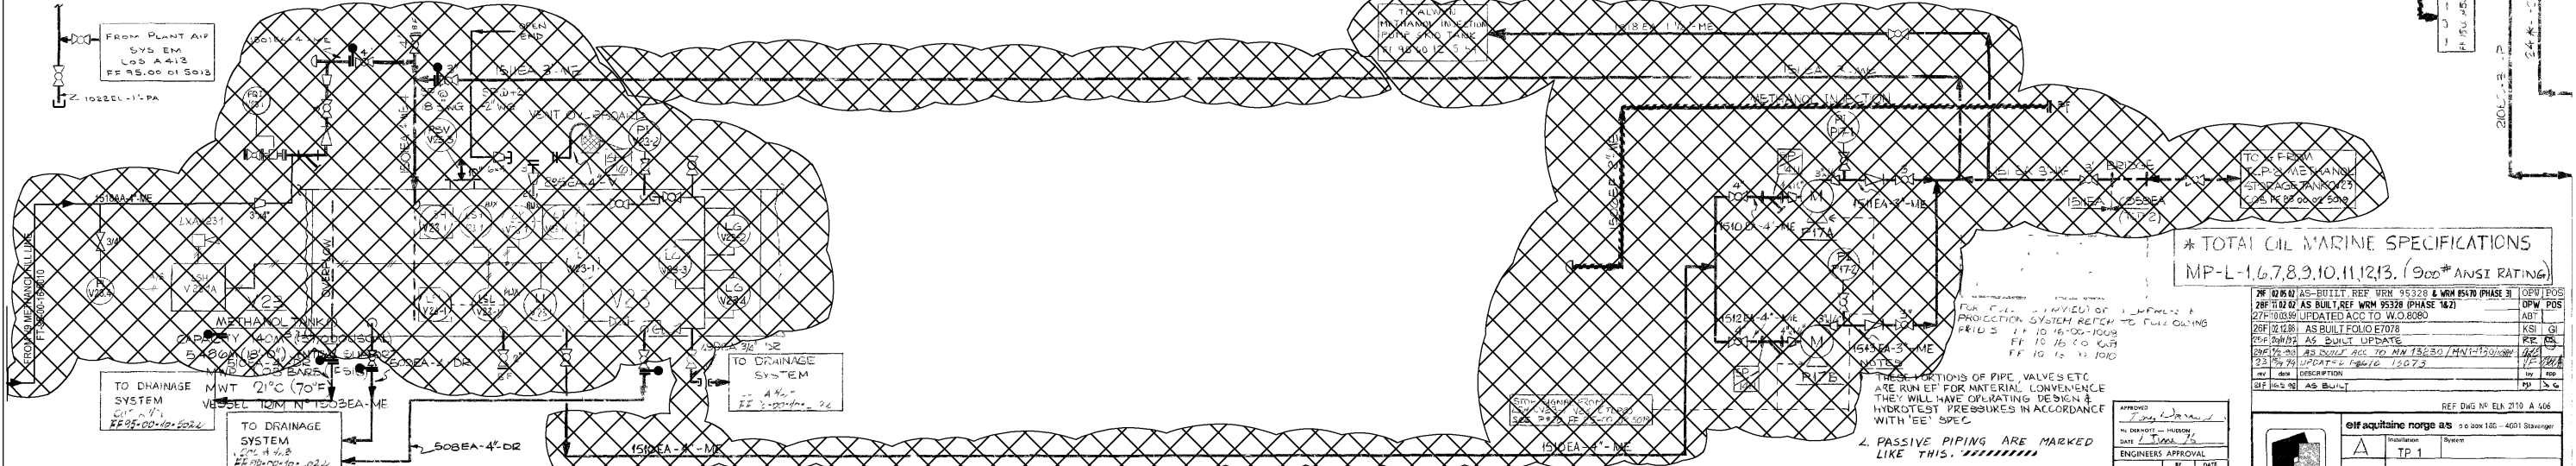
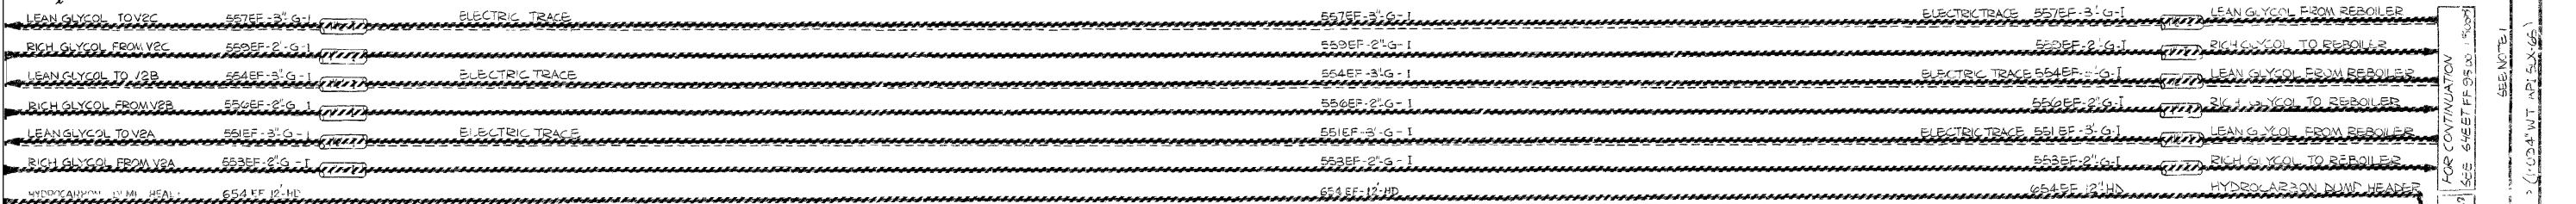


DENOTES INSTRUMENTS TAKEN OUT OF SERVICE. REF. WRM 85470
 DENOTES PIPING THAT HAS BEEN PASSIVATED. REF. WRM 85470

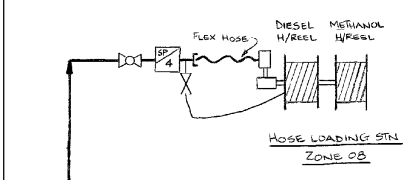

*** TOTAL CIL MARINE SPECIFICATIONS**
 MP-L-1,6,7,8,9,10,11,12,13 (900# ANSI RATING)


elf aquitaine norge as
 PIPING & INSTRUMENT DIAGRAM
 METHANOL INJECTION SYSTEM
 FRIGG FIELD

DESIGN	STRUCT	PIPING	ELEC	ME	BY	DATE	REVISIONS	DATE	APP	DESIGN	STRUCT	PIPING	ELEC	ME	BY	DATE	REVISIONS	DATE	APP	
					11	13-87	SEE REVISION LIST													
					10	DL-87	SEE REVISION LIST													
					9	17-86	SEE REVISION LIST													
					13	10-88	SEE REVISION LIST													

1. THESE PORTIONS OF PIPE, VALVES ETC ARE RUN UP FOR MATERIAL CONVENIENCE THEY WILL HAVE OPERATING DESIGN & HYDROTEST PRESSURES IN ACCORDANCE WITH 'EE' SPEC.
2. PASSIVE PIPING ARE MARKED LIKE THIS:
3. CLOSE HV M28 & IF ESDV TCP21 NOT FULLY OPEN