1. SITE ERECTED PIPEWORK. (ALL IN THIS AREA)
2. FUTURE PHASE II PIPEWORK.
3. EXISTING McD/H PIPEWORK.
4. EXISTING McD/H PIPEWORK TAKEN FROM THEIR DRAWING OF THE SAME AREA ELN 2169 C 5020 REV. 2

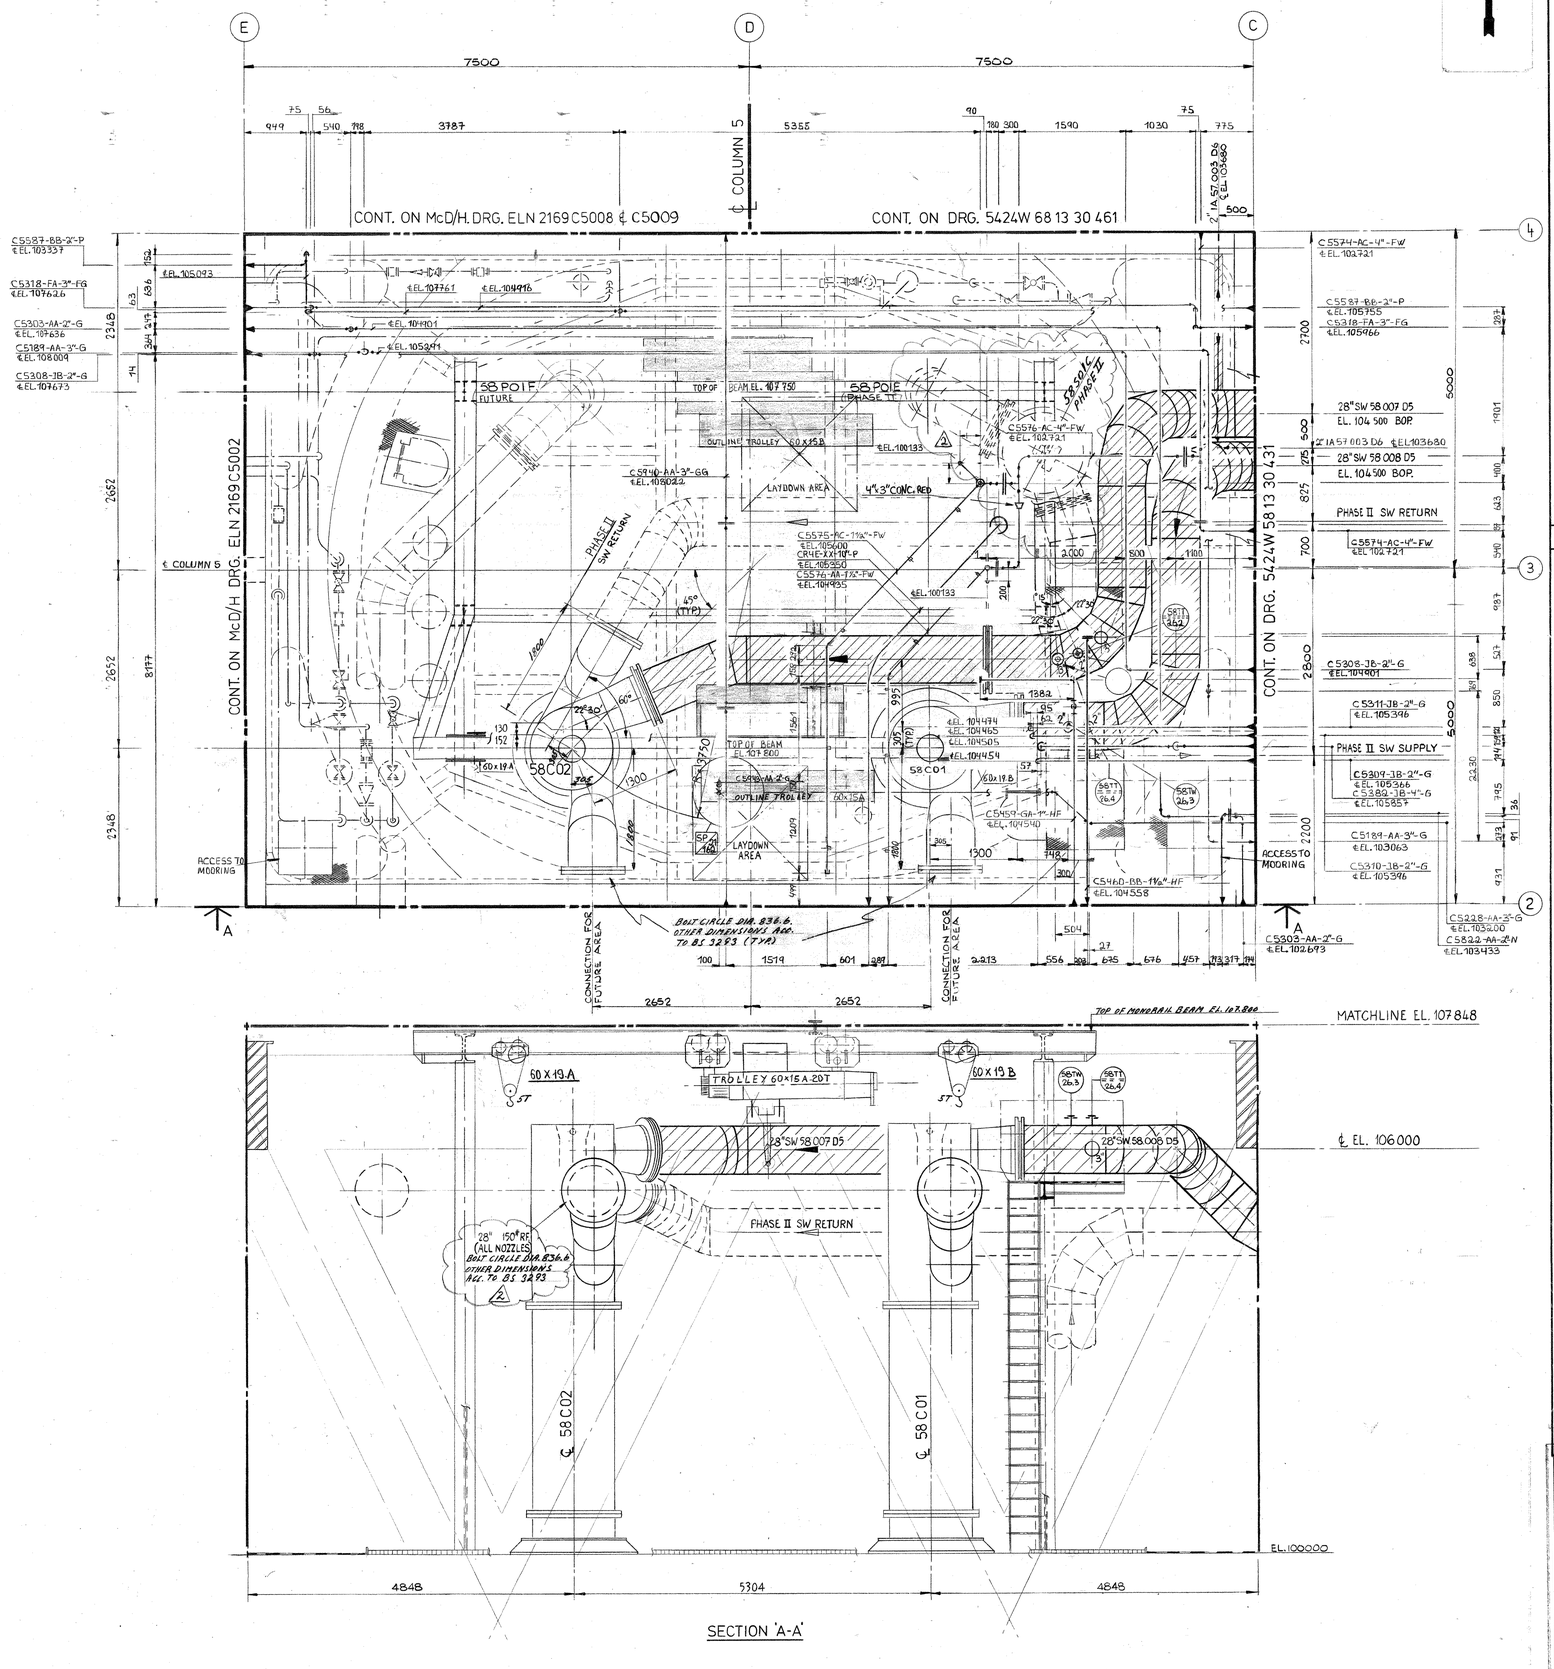

REFERENCE DRG.S

OVERALL PLOT PLAN	5424W.00.00.60.71
CELLAR DECK PLOT PLAN	5424W00006072
KEY PLAN	5424W.11.13.30.001

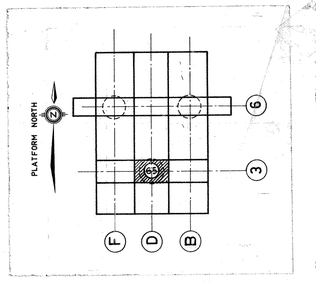

elf aquitaine norge a/s p.o.box 168 – 4001 Stavanger
Contractor: KE / TP
FRIGG FIELD | Dwgr. no: FF 87 20 00 1032 | Rev.: 1 | Sheet:

ISSUE	DATE	MODIFICATIONS	DWG	CHECK	ENG	PROJ. ENG	VISA
3	20.10.88	AS BUILT ACC. TO LILLE FRIGG INTEGR.	TRL				
2	12.7.88	UPDATED, ADDED MONORAIL AAA.58.SO.01C MOVED.	AL	TP			
1	24.5.78	APPROVED FOR CONSTRUCTION	TS	TP			
XA	16.5.78	PRELIMINARY ISSUE	TSD				

ELF NORGE - FRIGG FIELD - TCP2 - COMPRESSION

KVAERNER - TECHNIP TCP2

PIPING ARRANGEMENT
AREA 65 — CELLAR DECK
PLAN BETWEEN EL. 100 008 & 107 848 & SECTIONS

THIS DRAWING IS THE PROPERTY OF KVAERNER ENG. AND TECHNIP - IT SHALL NOT BE REPRODUCED OR ITS CONTENTS DISCLOSED WITHOUT THE PERMISSION OF MENTIONED PROPRIETORS.

CHECKED BY :
SCALE : 1:33⅓
SHEET :

CONTRACT	UNIT	CODE	NUMBER	ISSUE
5424W5813306S1				3

ELF CONTRACT	TECHNIP CONTRACT	KVAERNER CONTRACT
B 139	5424 W	280