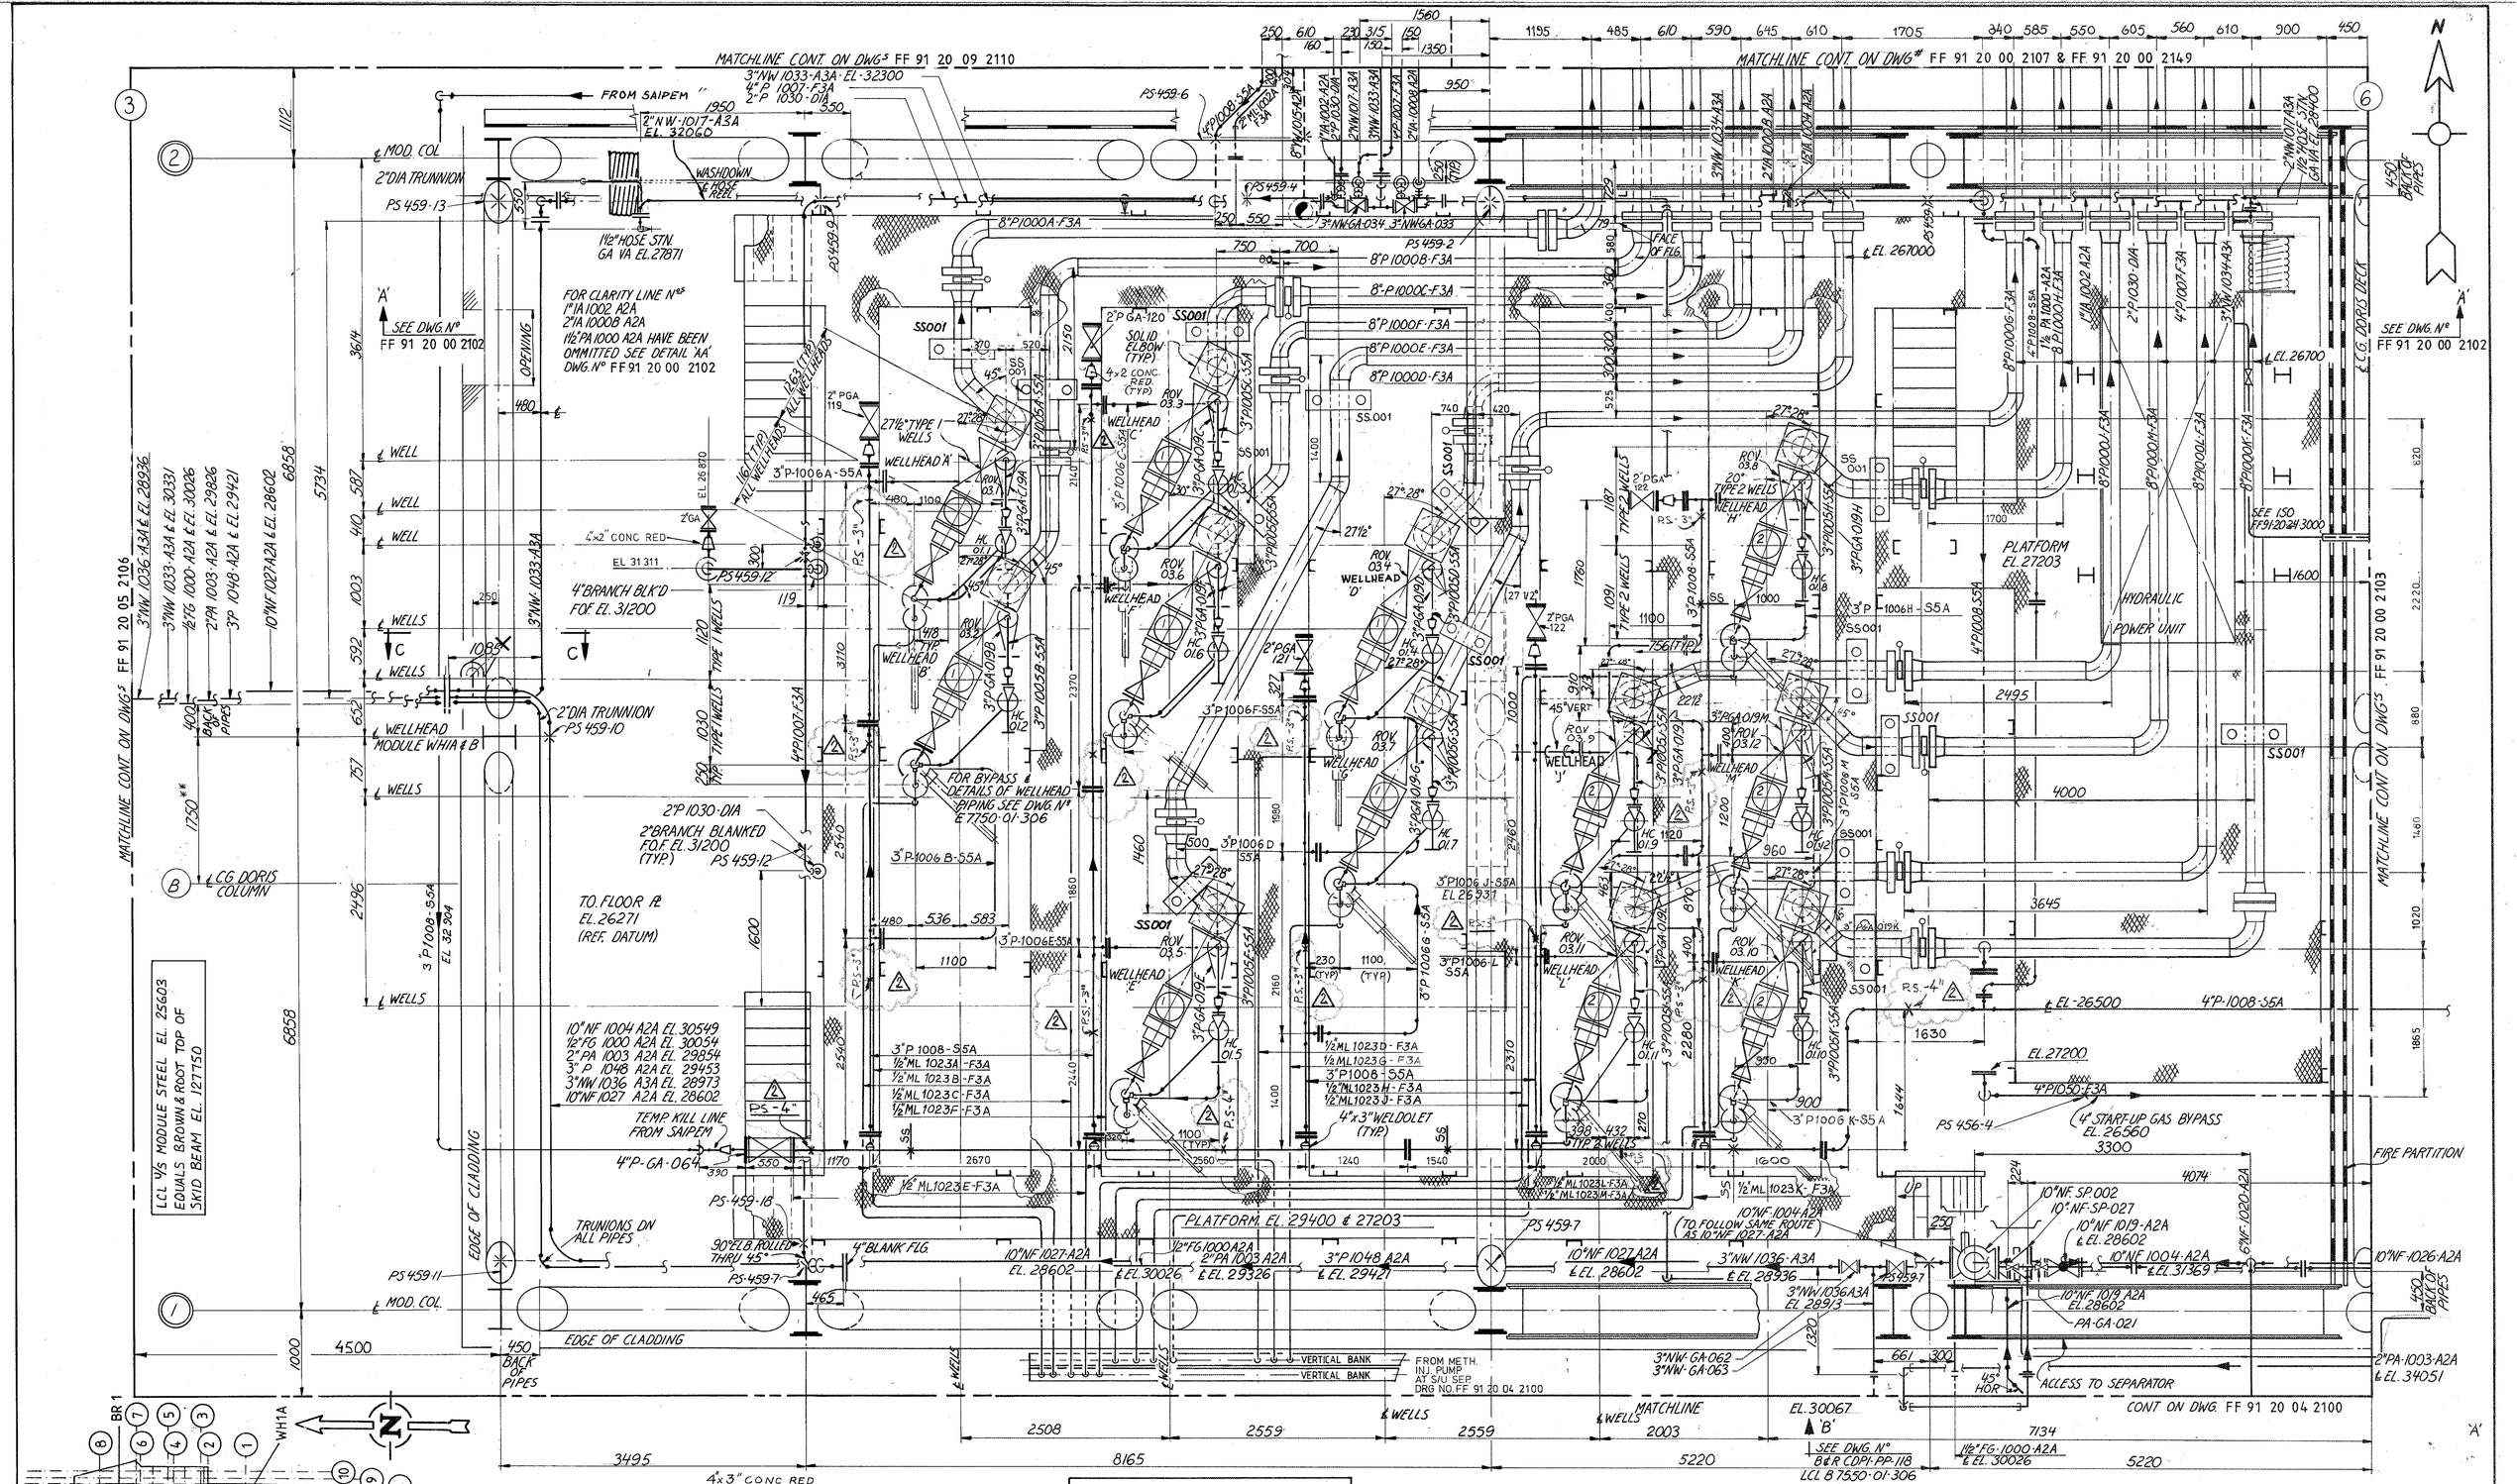

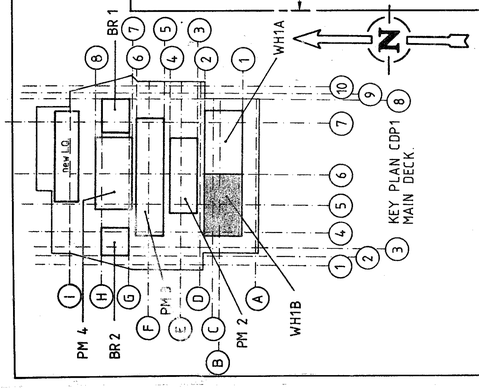

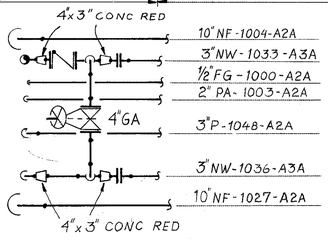

ELEVATION 'C-C'

WELLHEAD REFERENCE TABLE	
SITE NUMBER	B&R. DRAWING IDENTIFICATION
1	A
2	B
3	C
4	D
5	E
6	F
7	G
8	H
9	J
10	K
11	L
12	M

AS BUILT

rev.	date	DESCRIPTION	by	app.
2	20/2-94	WELLHEAD REF. TABLE, KEY PLAN & AS BUILT MR 91147	A.H.	[illegible]
1	02.02.92	4" P 1008-S5A REDRAWN MR 91110	A.E.	
0	30.6.81	AS BUILT INFORMATION ADDED DRG.NO CHANGED	KE	[illegible]

THIS DRAWING REPLACES BROWN & ROOT DRAWING N°
CDP1-PP-106

elf aquitaine norge a/s p.o.box 168 – 4001 Stavanger

Installation: CDP1
System: GENERAL

PLAN PIPING
MODULE WH 1B
FRIGG FIELD CDP1

Job no.
Scale 1:33⅓

FRIGG FIELD
Drwg. no. FF 91 20 00 2101
Rev. 2
Sheet 1/1