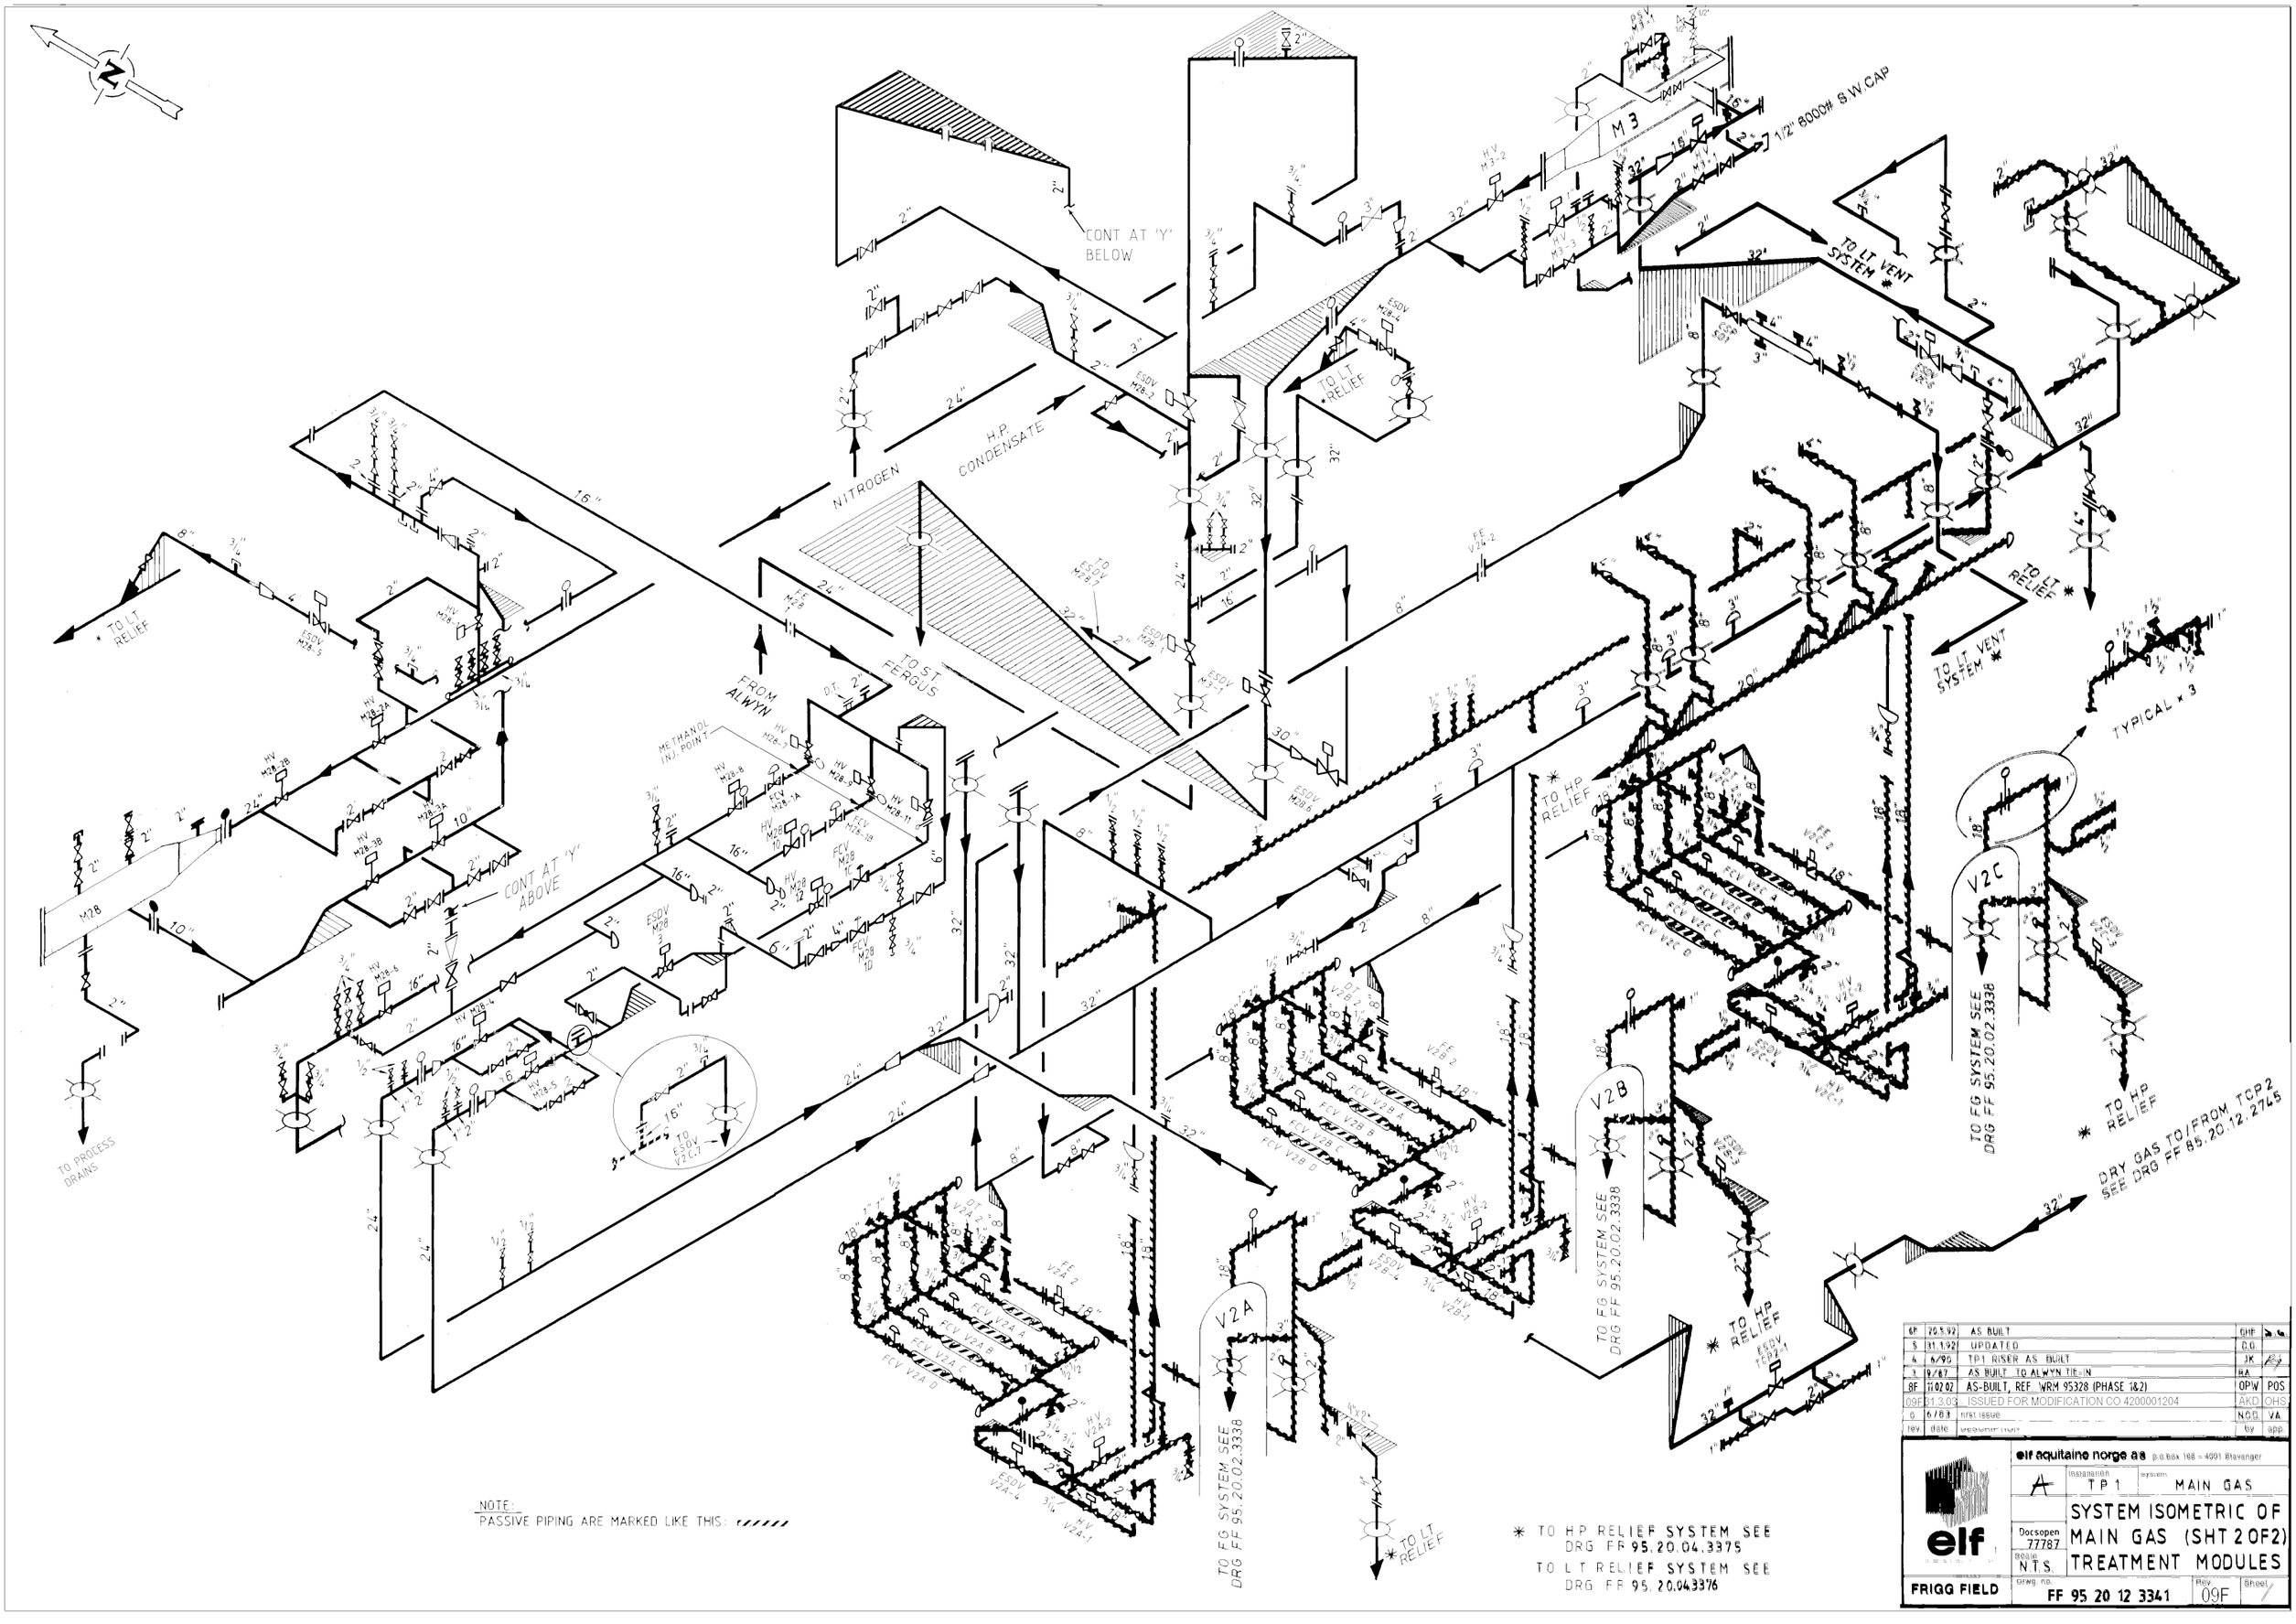

rev	date	description	by	app
6F	20.5.92	AS BUILT	GHF	
5	31.1.92	UPDATED	D.G.	
4	6/90	TP1 RISER AS BUILT	JK	
3	9/87	AS BUILT TO ALWYN TIE-IN	RA	
8F	11.02.02	AS-BUILT, REF. WRM 95328 (PHASE 1&2)	OPW	POS
09F	31.3.03	ISSUED FOR MODIFICATION CO 4200001204	AKD	OHS
0	6/83	first issue	N.O.D.	VA

elf aquitaine norge a/s p.o.box 168 - 4001 Stavanger

elf

A	Installation: TP1	System: MAIN GAS
Docsopen 77787	SYSTEM ISOMETRIC OF MAIN GAS (SHT 2 OF 2) TREATMENT MODULES	
Scale: N.T.S.		
FRIGG FIELD	Drwg. no.: FF 95 20 12 3341	Rev.: 09F
		Sheet: 1