


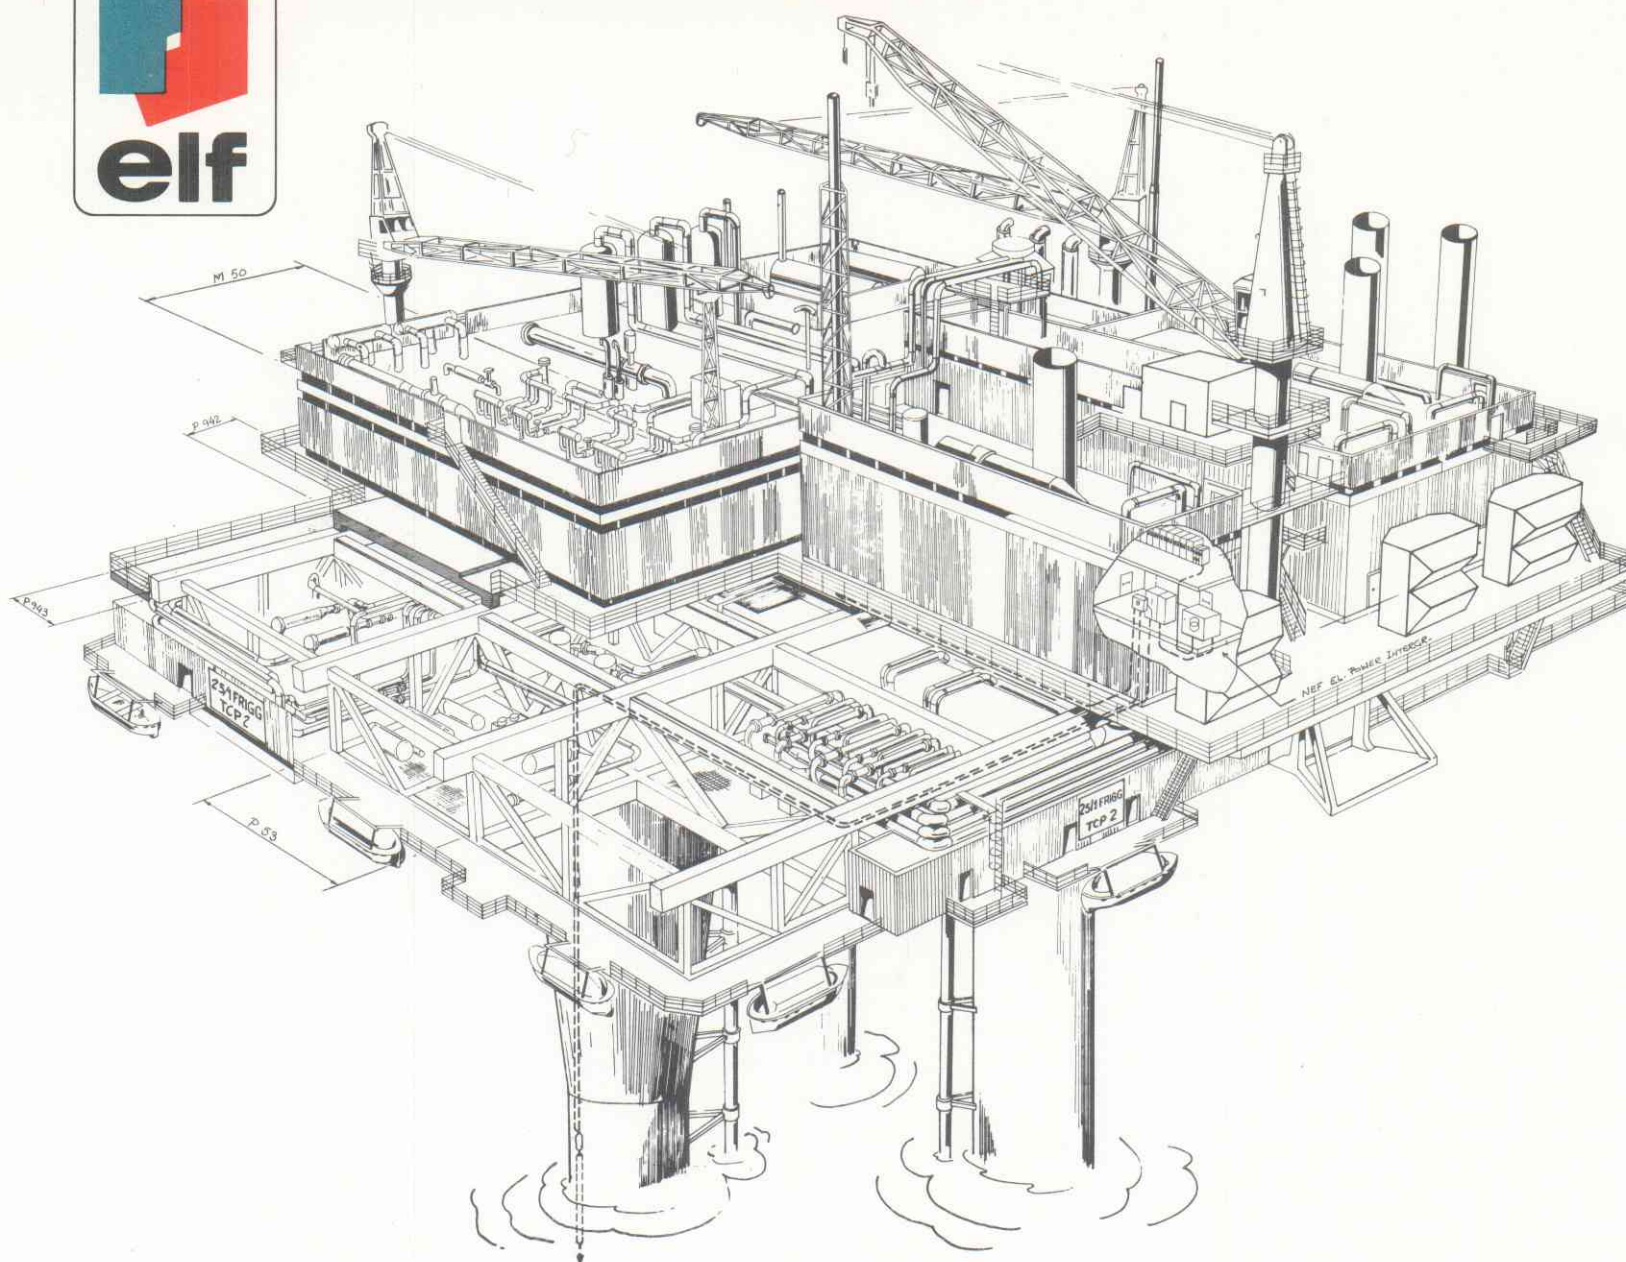

elf aquitaine norge a/s



elf aquitaine norge a/s

FRIGG FIELD — TCP2 EXTENSION

FINAL REPORT

VOLUME 1

PROJECT DESCRIPTION

STAVANGER

FEBRUARY 1984

TCP-2 EXTENSION FINAL REPORT

VOLUME I

PROJECT DESCRIPTION

TCP-2 EXTENSION FINAL REPORT

GENERAL INDEX

TCP2 EXTENSION FINAL REPORT

GENERAL INDEX FOR ALL VOLUMES

VOL I - PROJECT DESCRIPTION

1 GENERAL DESCRIPTION OF TCP-2 EXTENSION PROJECT

1.1 INTRODUCTION

1.2 FIELDS LOCATION

1.3 EXTENSION LOCATION

1.4 PROCESS DESCRIPTION

1.5 DESCRIPTION OF PROCESS SAFETY SYSTEMS

1.6 DESCRIPTION OF GAS RELIEF SYSTEM

1.7 GENERAL DRAWING LIST

2 PRINCIPLES OF ENGINEERING DESIGN

2.1 ENVIRONMENTAL CONDITIONS

2.2 DOCUMENT NUMBERING, DISTRIBUTION AND ROUTING

2.3 ENGINEERING DESIGN

3 NEF - ELECTRICAL POWER SUPPLY

3.1 GENERAL DESCRIPTION OF NEF POWER SUPPLY INSTALLATION

3.2 DESIGN PHILOSOPHY

4 APPENDICES

APPENDIX 1 - NEF Gas Composition, Reservoir Pressure and Production Profile

APPENDIX 2. - ODIN Gas Composition, Reservoir Pressure and Production Profile

APPENDIX 3 - Process Flow Diagrams

APPENDIX 4 - Safety Analysis Table (SAT)

APPENDIX 5 - Safety Analysis Function Evaluation Chart

Index Continued

- APPENDIX 6 - Functional Description of the ESD System
- APPENDIX 7 - Description of Process Safety System
- APPENDIX 8 - Pressure Drop Calculations for LP Vent System
- APPENDIX 9 - Back Pressure Calculations - LT Relief System
- HP Relief System
- APPENDIX 10 - Calculation of Temperature Downstream of the
Blow Down Valves
- APPENDIX 11 - Fire Protection - Liquid Vapourization
- Gas Expansion
- APPENDIX 12 - Back Pressure Calculations - LP Vent System to
Glycol Surge Drums CV 17
- APPENDIX 13 - Data Sheets for Safety Relief Valves

Index Continued

VOLUME II - PROJECT DEVELOPMENT

1. OVERALL PROJECT DEVELOPMENT

- 1.1 SCOPE OF WORK
- 1.2 ORGANIZATION
- 1.3 PLANNING AND EXECUTION
- 1.4 QUALITY ASSURANCE PRINCIPLES
- 1.5 INSURANCE
- 1.6 FILING KEY

2. ENGINEERING

- 2.1 GENERAL
- 2.2 ORGANIZATION
- 2.3 QUALITY ASSURANCE (QA) / QUALITY CONTROL (QC)
- 2.4 PLANNING AND PROGRESS
- 2.5 ENGINEERING AND DISCIPLINE REPORT

3. PROCUREMENT

- 3.1 GENERAL
- 3.2 QUALITY ASSURANCE (QA) / QUALITY CONTROL (QC)
- 3.3 PURCHASING
- 3.4 INSPECTION / EXPEDITING
- 3.5 TRANSPORTATION / CUSTOMS
- 3.6 MATERIALS HANDLING
- 3.7 SURPLUS
- 3.8 VENDOR DOCUMENTATION
- 3.9 KEY FIGURES

Index Continued

4 CONSTRUCTION ON YARD

- 4.1 GENERAL
- 4.2 ORGANIZATION
- 4.3 QUALITY ASSURANCE / QUALITY CONTROL (QA/QC)
- 4.4 PLANNING AND PROGRESS
- 4.5 WORK REPORT
- 4.6 KEY FIGURES
- 4.7 FINAL ACCEPTANCE DOCUMENTATION

5 PRE HOOK UP

- 5.1 GENERAL
- 5.2 RISERS EXTENSION IN COLUMN 5
- 5.3 WORKS ON TCP-2
- 5.4 WORKS ON DP-2
- 5.5 KEY FIGURES

6 TRANSPORTATION AND LIFTING

- 6.1 GENERAL
- 6.2 TRANSPORTATION
- 6.3 LIFTING

7 HOOK UP

- 7.1 GENERAL
- 7.2 HOOK UP PREPARATION
- 7.3 QUALITY ASSURANCE / QUALITY CONTROL
- 7.4 PLANNING AND PROGRESS
- 7.5 HOOK UP PREPARATION
- 7.6 MOBILIZATION
- 7.7 EXECUTION OF THE WORK
- 7.8 KEY FIGURES
- 7.9 FINAL ACCEPTANCE DOCUMENTATION

Index Continued

8 COMMISSIONING

- 8.1 GENERAL
- 8.2 ORGANIZATION
- 8.3 QUALITY ASSURANCE PRINICIPLES
- 8.4 PLANNING AND PROGRESS
- 8.5 WORK REPORT
- 8.6 MANHOURS

9 LOGISTICS

- 9.1 FLOTEL
- 9.2 MARINE SERVICES
- 9.3 HELICOPTER TRANSPORTATION

10 APPENDICES

- APPENDIX 1 - Bid Evaluation TCP-2 Extension Engineering Services Contract F.087.
- APPENDIX 2 - TCP-2 Extension Bid Evaluation Construction Contract
- APPENDIX 3 - Lifting Bid Evaluation
- APPENDIX 4 - Hook Up and Planning
- APPENDIX 5 - Hook Up Progress Curves
- APPENDIX 6 - Hook Up Cumulative Manhours
- APPENDIX 7 - Flotel Bid Evaluation

Index Continued

VOLUME III - COST

1 GENERAL INTRODUCTION

- 1.1 SUMMARY
- 1.2 OVERALL PROJECT PLAN
- 1.3 ORGANIZATION WITHIN EAN
- 1.4 MAIN CONTRACTS
- 1.5 NORWEGIAN CONTENT
- 1.6 BUDGETS / COST ESTIMATES
- 1.7 PROJECT COST

2 PROJECT MANAGEMENT

- 2.1 ORGANIZATION
- 2.2 PROJECT SUPERVISION COST

3 ENGINEERING

- 3.1 SUMMARY
- 3.2 TENDER / BID EVALUATION
- 3.3 ORGANIZATION OF THE WORK
- 3.4 PLANNING / PROGRESS
- 3.5 COST
- 3.6 EXPENDED MANHOURS
- 3.7 RATIOS

4 PROCUREMENT

- 4.1 ORGANIZATION OF WORK
- 4.2 COST OF MATERIAL & EQUIPMENT
- 4.3 EXPENDITURE AGAINST TIME
- 4.4 DELIVERY TIME

Index Continued

5 YARD CONSTRUCTION

- 5.1 SUMMARY
- 5.2 TENDER / BID EVALUATION
- 5.3 ORGANIZATION OF THE WORK
- 5.4 PLANNING AND PROGRESS
- 5.5 COST
- 5.6 EXPENDED MANHOURS
- 5.7 WEIGHTS
- 5.8 RATIOS

6 TRANSPORTATION AND LIFTING

- 6.1 TRANSPORTATION
- 6.2 COST
- 6.3 PLANNING

7 HOOK UP AND INTEGRATION

- 7.1 PRE-HOOK-UP
- 7.2 HOOK-UP AND COMMISSIONING
- 7.3 OTHER CONTRACTS

8 LOGISTICS

- 8.1 GENERAL
- 8.2 FLOTEL COST
- 8.3 MARINE SERVICES COST
- 8.4 HELICOPTER TRANSPORT
- 8.5 TCP-2 EXTENSION ENVIRONMENTAL COST
- 8.6 OTHER CONTRACTS

Index Continued

9 APPENDICES

- APPENDIX 1 - BID EVALUATION - TCP-2 EXTENSION - ENGINEERING SERVICES - CONTRACT F.087.
- APPENDIX 2 - TCP-2 EXTENSION - BID EVALUATION - CONSTRUCTION CONTRACT
- APPENDIX 3 - LIFTING BID EVALUATION
- APPENDIX 4 - HOOK UP AND PLANNING
- APPENDIX 5 - HOOK UP PROGRESS CURVES
- APPENDIX 6 - HOOK UP CUMULATIVE MANHOURS
- APPENDIX 7 - FLOTEL BID EVALUATION

VOLUME I - PROJECT DESCRIPTION

1. GENERAL DESCRIPTION
OF TCP-2 EXTENSION
PROJECT
-

2. PRINCIPLES OF
ENGINEERING DESIGN
-

3. NEF - ELECTRICAL
POWER SUPPLY
-

4. APPENDICES

TCP-2 EXTENSION FINAL REPORT

VOLUME I

PROJECT DESCRIPTION

TCP2 EXTENSION FINAL REPORT

DETAILED INDEX FOR VOLUME I

VOL I PROJECT DESCRIPTION

1 GENERAL DESCRIPTION OF TCP-2 EXTENSION PROJECT

1.1 INTRODUCTION

1.2 FIELDS LOCATION

1.3 EXTENSION LOCATION

1.3.1 Outline of M50, P53 and Integration

1.3.1.1 Module M50

1.3.1.2 Pancake P53

1.3.1.3 Tie-In Installations

1.4 PROCESS DESCRIPTION

1.4.1 Introduction

1.4.2 Description

1.4.2.1 NEF Gas Treatment

1.4.2.2 ODIN Gas Treatment

1.4.2.3 Condensate Separation

1.4.2.4 Methanolated Water System

1.4.2.5 Triethylene Glycol (TEG) System

1.4.2.6 Methanol Injection System

1.4.2.6.1 General

1.4.2.6.2 Injection to the Articulated Column FCS for NEF Field

1.4.2.6.3 Injection Downstream ODIN and NEF Slug Catchers

1.4.2.7 Process Drainage System

1.4.2.8 Flare Drainage System

1.4.2.8.1 General

1.4.2.8.2 LP system

1.4.2.8.3 HP system

1.4.2.8.4 LT system

Index Continued

1.4.2.9 Fuel Gas System

1.4.2.9.1 Fuel Gas for Blanketing

1.4.2.9.2 Fuel Gas Used as Start Up Gas

1.4.2.10 Upset Operating Conditions

1.4.2.10.1 Slug formation

1.4.2.10.2 Depressurization

1.5 DESCRIPTION OF PROCESS SAFETY SYSTEMS

1.5.1 General Description of Process Safety Systems

1.5.2 Fire Protection

1.5.2.1 Introduction

1.5.3 Protection Against Process Over Pressure

1.5.3.1 Protection for High Pressure Gas Vessels CV 1A, CV 210, CV 201 and CV 211.

1.5.3.2 ODIN Condensate Lines Downstream the ESDV V1A.2 and ESDV V201.3.

1.5.3.3 NEF Condensate Lines Downstream the ESD V210.2 and ESDV V211.3.

1.5.3.4 Protection of Methanolated Water System.

1.5.4 Thermal Expansion in CE 203 / CE 211

1.5.5 Protection on Shell Side of Condensate Heaters, TEG Lines and Glycol Surge Drums CV 17 A/B/C

1.5.6 Pumps Discharge

1.6 DESCRIPTION OF GAS RELIEF SYSTEM

1.6.1 General

1.6.2 Basis of Design

1.6.3 Description of the Relief / Vent System

1.6.3.1 Low Pressure Vent System

1.6.3.2 High Pressure Relief System

1.6.3.3 Low Temperature Relief System

Index Continued

1.6.3.3.1 System Description

1.6.3.3.2 Calculation Summary

1.6.4 Depressurization of High Pressure Vessels, Lines and Sea Lines

1.6.4.1 Depressurization of High Pressure Vessels and Lines

1.6.4.1.1 Introduction

1.6.4.1.2 Basis for Calculations

1.6.4.1.3 Calculation Results

1.6.4.2 Sea Line Depressurization

1.6.4.2.1 Introduction

1.6.4.2.2 NEF Sea Line Depressurization

1.6.4.2.3 ODIN Sea Line Depressurization

1.6.5 Fire Protection

1.6.5.1 Introduction

1.6.5.2 Liquid Vapourization Risk

1.6.5.3 Gas Expansion Risk

1.6.5.4 Calculation Results

1.6.6 Protection Against Process Over Pressure

1.6.6.1 Protection for High Pressure Gas Vessels CV 1A, CV 210, CV 201 AND CV 211

1.6.6.2 ODIN Condensate Lines Downstream the ESDV V1A.2 and ESDV V201.3

1.6.6.2.1 Description

1.6.6.2.2 Calculation Results

1.6.6.3 NEF Condensate Lines Downstream the ESDV V210.2 and ESDV V211.3.

1.6.6.3.1 Description

1.6.6.3.2 Calculation Results

Index Continued

- 1.6.6.4 Thermal Expansion in CE 203/CE 211
- 1.6.6.5 Protection of Methanolated Water System
 - 1.6.6.5.1 Protection of Vessel CV 220 - Methanolated Water Flash Drum
 - 1.6.6.5.2 Protection of Vessel CV 222 - Methanolated Water Drainage Tank
- 1.6.6.6 Protection on Shell Side of Condensate Heaters, TEG Lines and Glycol Surge Drum CV 17 A/B/C
- 1.6.6.7 Methanolated Water Storage Tank CV 9
- 1.6.6.8 Pumps Discharge

1.7 GENERAL DRAWING LIST

- 1.7.1 General Drawings
 - 1.7.1.1 Process Flowsheets - Schematic Drawings
 - 1.7.1.2 Process / Utilities Drawings - P & IDs
 - 1.7.1.3 Plot Plans - Arrangement Drawings

Index Continued

2 PRINCIPLES OF ENGINEERING DESIGN

2.1 ENVIRONMENTAL CONDITIONS

2.1.1 Wind

2.1.1.1 Wind Profile

2.1.1.2 Factors in the Power Law for Wind Profile

2.1.1.3 Reference Wind Speed

2.1.1.4 Prevailing Winds

2.1.1.5 Storm Wind Direction

2.1.2 Ambient Air Conditions

2.1.2.1 Ambient Air Temperature

2.1.2.2 Ambient Air Relative Humidity

2.1.2.3 Rainfall

2.1.2.4 Atmospheric Pressure

2.1.2.5 Snow and Ice Accumulation

2.1.3 Sea Water Characteristics

2.1.3.1 Sea Water Temperature

2.1.3.2 Sea Water Salinity

2.1.3.3 Sea Water Oxygen Content

2.1.4 Water Depth - Sea Level

2.1.4.1 Water Depth

2.1.4.2 Tide in Storm Conditions

2.1.4.3 Tide in Operating Conditions

Index Continued

2.1.5 Waves and Current

2.1.5.1 Storm Conditions

2.1.5.2 Operating Conditions

2.1.5.3 Prevailing Wave Direction

2.2 DOCUMENT NUMBERING, DISTRIBUTION AND ROUTING

2.2.1 Foreword

2.2.2 Units of Measurement

2.2.3 Numbering System

2.2.3.1 Numbering of Equipment

2.2.3.2 Numbering of Engineering Drawings (Including Isometrics)

2.2.3.3 Numbering of Technical Documents Other Than Drawings

2.2.3.3.1 Prefix

2.2.3.3.2 Field Specification

2.2.3.3.3 Codification of Installation

2.2.3.3.4 Codification of Speciality

2.2.3.3.5 Chronological Number

2.2.3.3.6 Revision Index

2.2.3.3.7 Numbering Sample

2.2.3.4 Numbering of Inquiries

2.2.3.5 Numbering of Engineer's Purchase Order

2.2.3.6 Numbering of Letters, Transmittals, Telexes, Minutes of Meeting

2.2.3.6.1 Numbering of Letters

2.2.3.6.2 Numbering of Telexes

2.2.3.6.3 Numbering of Transmittals

2.2.3.6.4 Numbering of Minutes of Meeting

2.2.4 Document Distribution

Index Continued

2.3 ENGINEERING DESIGN

2.3.1 Structural Design

2.3.2 Mechanical Design

2.3.2.1 Applicable Codes / Standards

2.3.3 Piping Design

2.3.3.1 Design

2.3.3.2 Piping Materials

2.3.3.2.1 Piping Materials on TCP-2

2.3.3.2.2 Piping Materials on DP-2

2.3.3.3 Piping Design Pressure Classes

2.3.3.4 Piping Stress Analysis

2.3.4 Electrical Design

2.3.4.1 Motor Control Centre MCC

2.3.4.2 Lighting Distribution Board "DB"

2.3.4.3 Power Distribution Board "DB"

2.3.4.4 Trace Heating

2.3.4.5 Hazardious Areas

2.3.4.6 Design

2.3.5 Instrument Design

2.3.5.1 Instrument Installation M50 & P53

2.3.5.2 Process Control & Monitoring

2.3.5.3 ESD and Process Safety

2.3.5.4 Fire and Gas, Public Address System

2.3.6 Safety / Loss Prevention

2.3.6.1 Area Classification

2.3.6.2 Escape Routes

2.3.6.3 Firewater System

2.3.6.4 Fire Fighting Equipment

Index Continued

3 NEF - ELECTRICAL POWER SUPPLY

3.1 GENERAL DESCRIPTION OF NEF POWER SUPPLY INSTALLATION

3.2 DESIGN PHILOSOPHY

4 APPENDICES

APPENDIX 1 - NEF Gas Composition, Reservoir Pressure and
Production Profile

APPENDIX 2 - ODIN Gas Composition, Reservoir Pressure and
Production Profile

APPENDIX 3 - Process Flow Diagrams

APPENDIX 4 - Safety Analysis Table (SAT)

APPENDIX 5 - Safety Analysis Function Evaluation Chart

APPENDIX 6 - Functional Description of the ESD System

APPENDIX 7 - Description of Process Safety System

APPENDIX 8 - Pressure Drop Calculations for LP Vent System

APPENDIX 9 - Back Pressure Calculations - LT Relief System
- HP Relief System

APPENDIX 10 - Calculation of Temperature Downstream of the
Blow Down Valves

APPENDIX 11 - Fire Protection - Liquid Vapourization
- Gas Expansion

APPENDIX 12 - Back Pressure Calculations - LP Vent System to
Glycol Surge Drums CV 17

APPENDIX 13 - Data Sheets for Safety Relief Valves

1 GENERAL DESCRIPTION OF TCP-2 EXTENSION PROJECT

1.1 INTRODUCTION

The purpose of the new facilities installed on the Frigg Field is to:

- Process wet gases coming from the NORTH-EAST FRIGG (NEF) and ODIN fields.
- Recover and treat the condensates.
- Measure for royalty purposes the treated gases and condensates.
- Inject the gases into the FRIGG gas production system for a last treatment (glycol dehydration), compression (using FRIGG main compressors) and for transportation to Scotland.
- Inject the condensates, using existing equipment, into the FRIGG gas transportation system.

For this purpose a new gas treatment facility called Module M50 and a condensate recovery package called Pancake P53 have been constructed and integrated by connection pieces into the existing facilities on the TCP-2, QP and DP-2 Platforms on the Frigg Field.

A simple process sketch of the new installations is shown on drawing:

FF 88 00 00 0102 - Schematic Process Diagram (Figure 1.1)

The models of Module 50 and Pancake 53 are shown on the enclosed pictures.


FIGURE 1.1


Drawing No.: FF 88 00 00 0102


Schematic Process Diagram

TCI EXTENSION

SIMPLIFIED PROCESS FLOW DIAGRAM

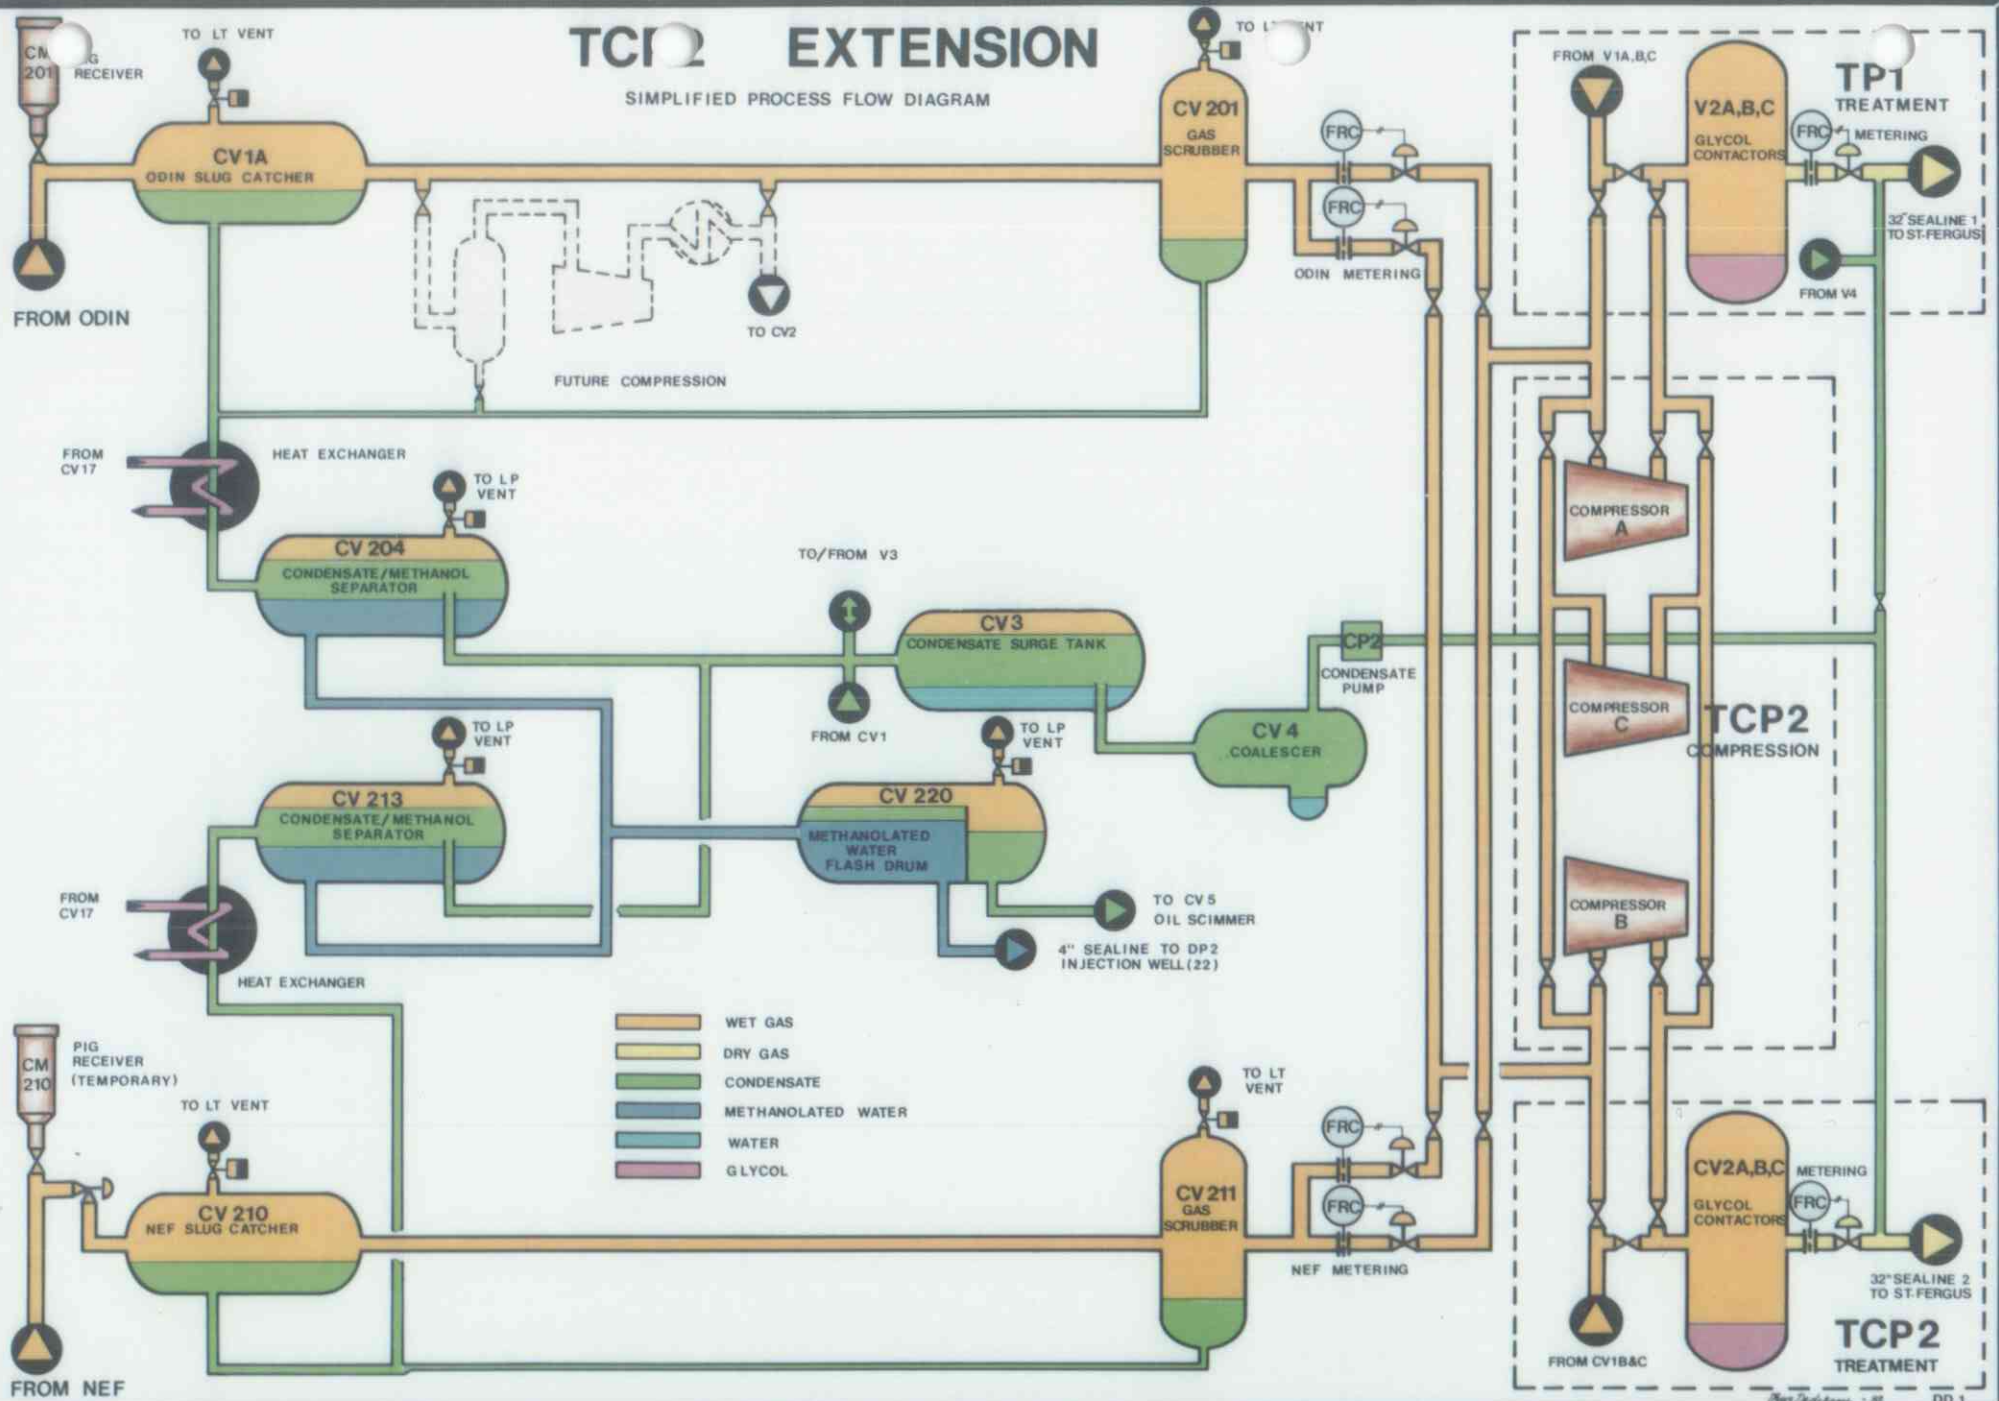

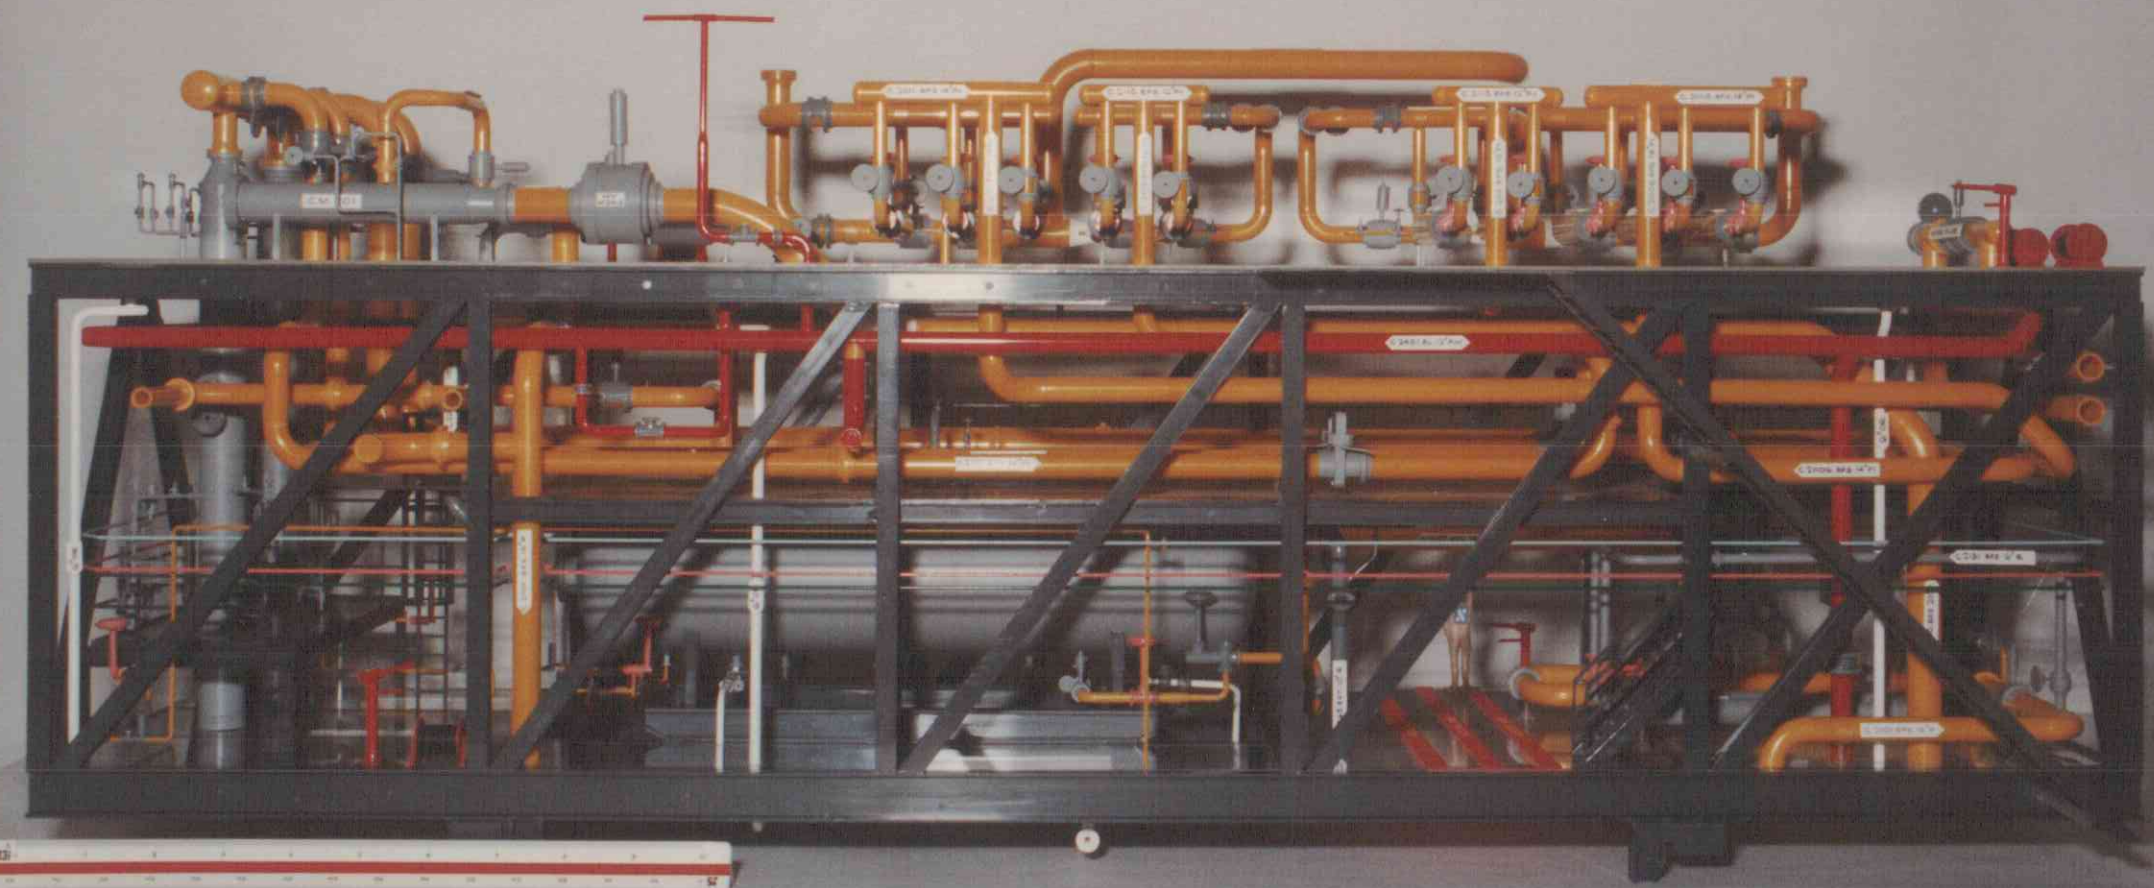

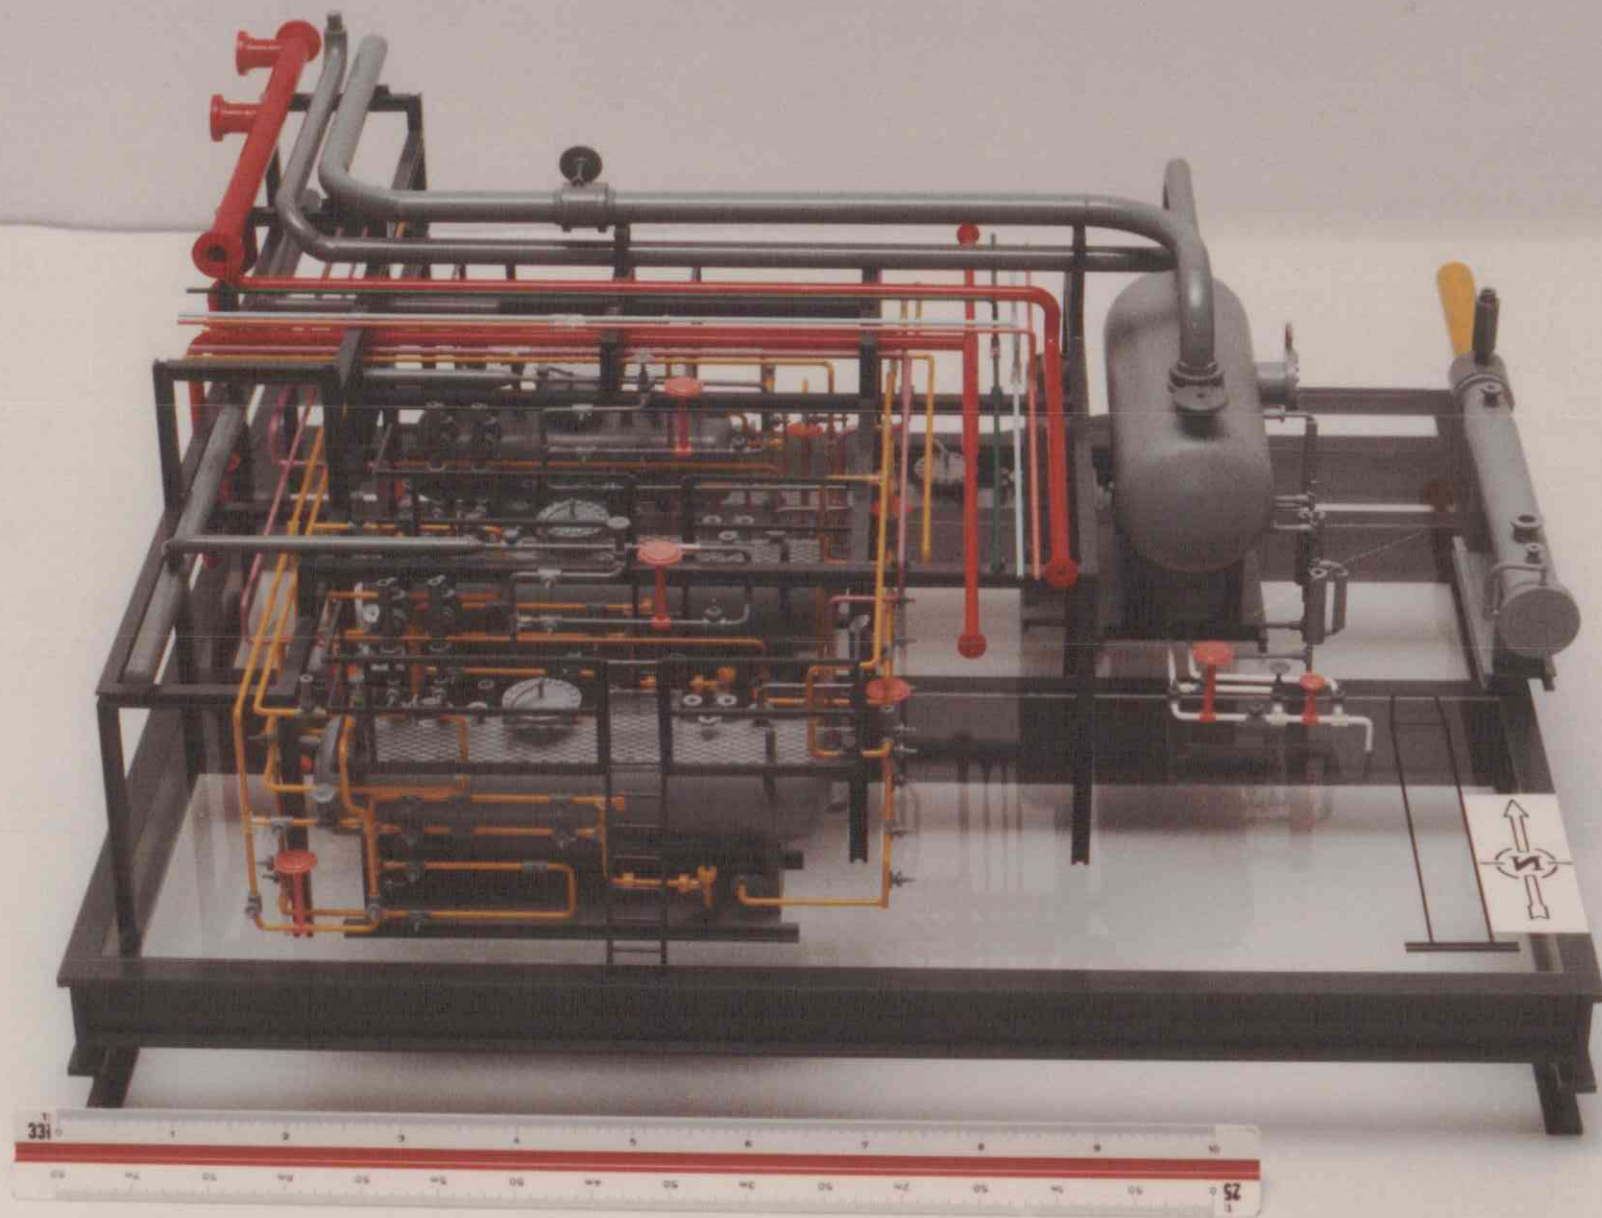

1.2 FIELDS LOCATION

Frigg Field, North-East Frigg Field (NEF) and the Odin Field are located in the northern part of the North Sea about 190 km off the Norwegian coast, 190 km from the Shetland Islands and 350 km from Scotland.

The map Figure No. 1.2 gives the relative location of NEF and Odin Fields in reference to the Frigg Field.

The Odin Field is located at a distance of about 22 km from the Frigg Field.

The NEF Field is located at a distance of about 17 km from the Frigg Field.

These fields are located inside the Norwegian coast water boundaries.


The Odin Field is developed in a conventional way; i.e. a fixed drilling / production platform of the jacket type.


The NEF Field is developed by means of a sub-sea technology with remote control from the Frigg Field through an articulated column located at the field.

Figure 1.3 shows the lay-out of the Frigg field treatment and transportation facilities.

FIGURE 1.2

MAP 1-2 (1)

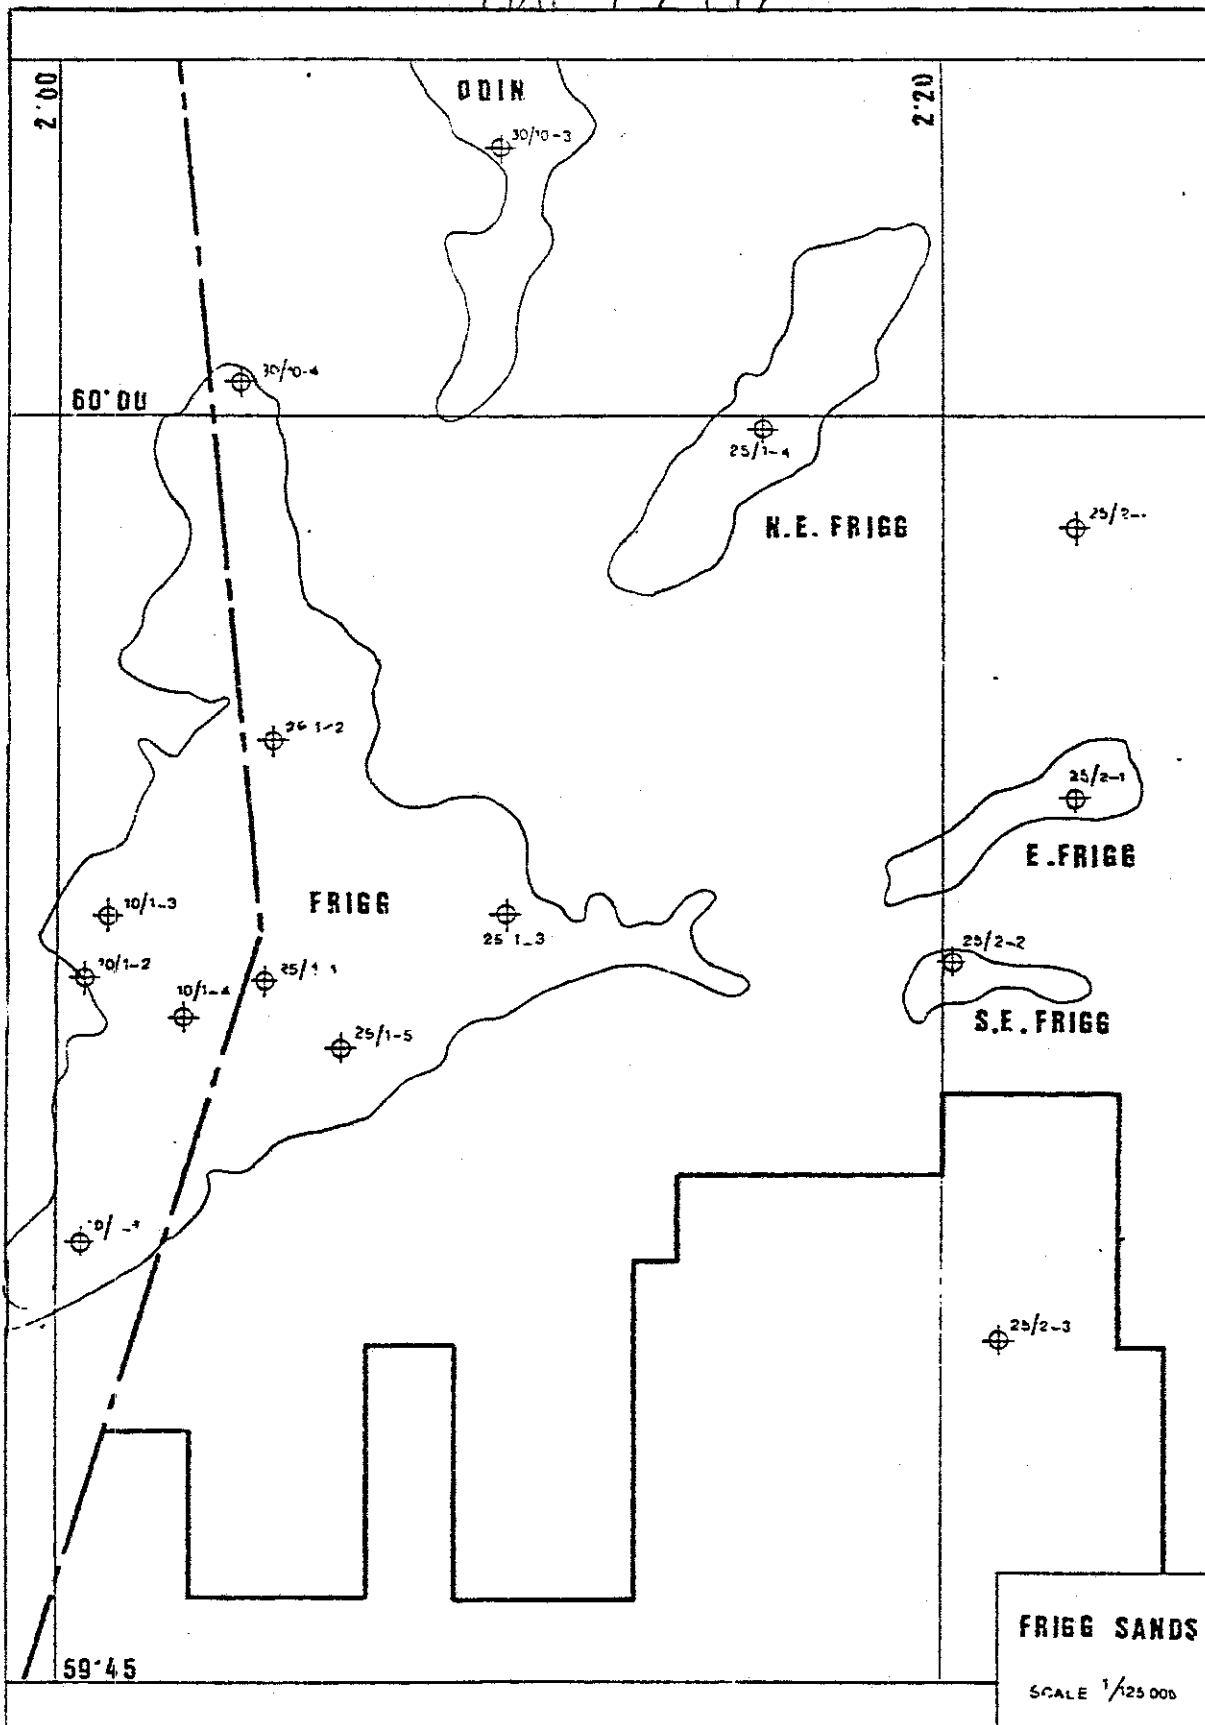

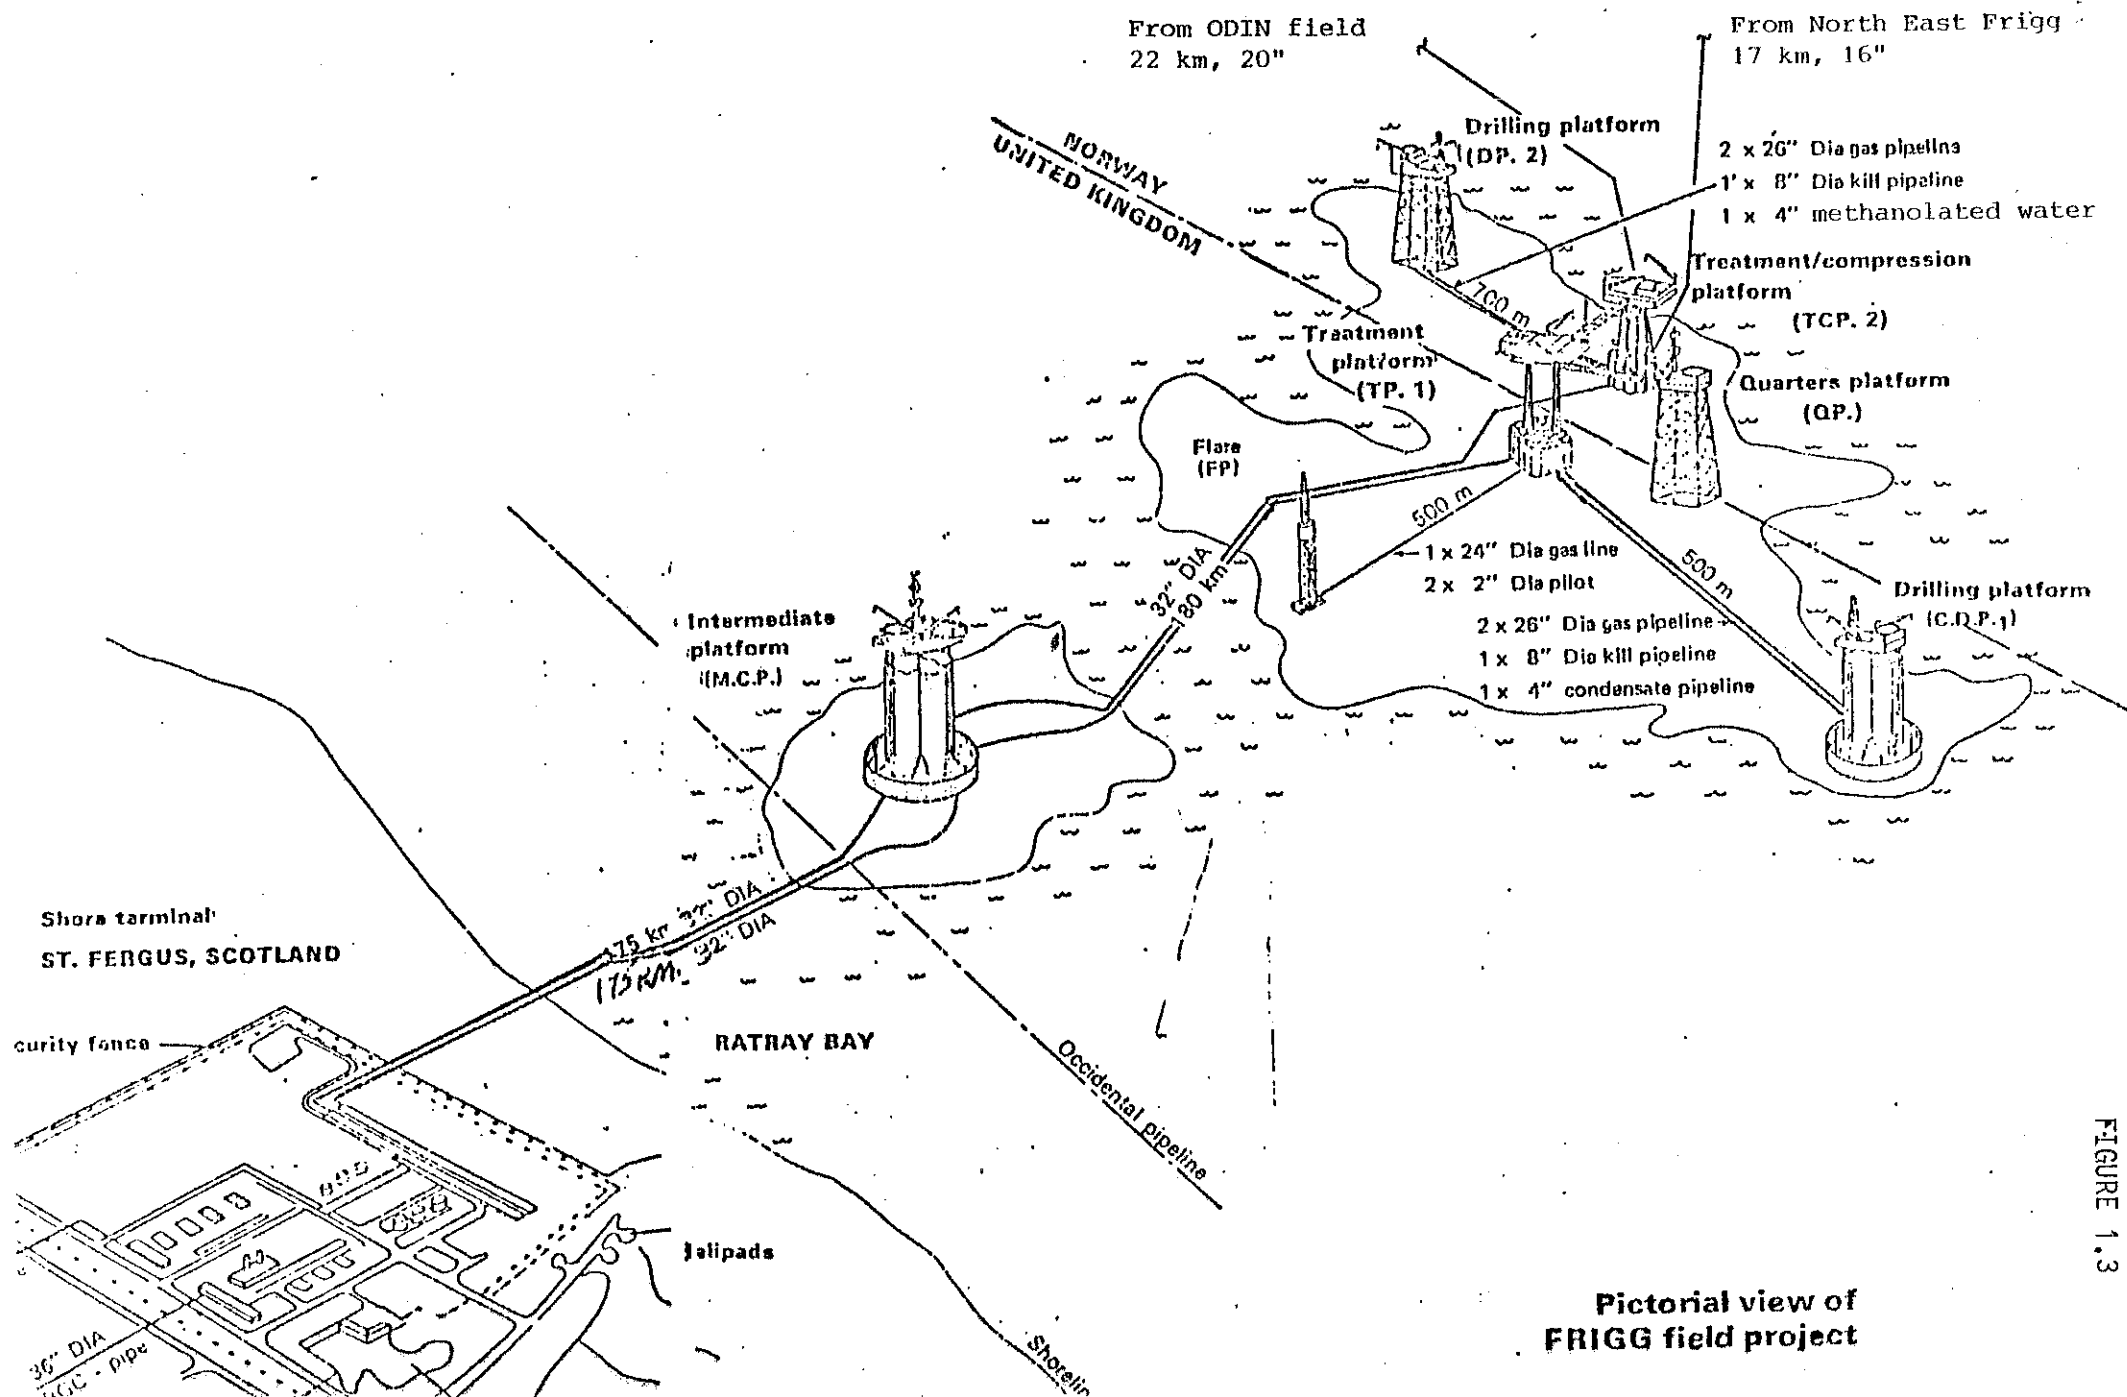

**Pictorial view of
FRIGG field project**

1.3 EXTENSION LOCATION

The locations of M50 and P53 onboard TCP-2 platform are shown on drawing Nos.:

FF 85 00 00 0030 - Admissible Load on Main
Deck for Module 50 (Figure 1.4)

and

FF 85 00 00 0031 - Admissible Load on Cellar
Deck Pancake 53 (Figure 1.5)

The gas from the ODIN field is received on TCP-2 through an existing 20" riser.

The gas from the NEF Field is received on TCP-2 through an existing 16" riser.

The gas treatment facilities and the condensate recovery facilities of the two gases are located on TCP-2.

The DP-2 platform shall support the waste methanolated water facilities.

FIGURE 1.4


Drawing No.: FF 85 00 00 0030

Admissible Load on Main Deck for Module 50

FIGURE 1.5

Drawing No.: FF 85 00 00 0031


Admissible Load on Cellar Deck Pancake 53

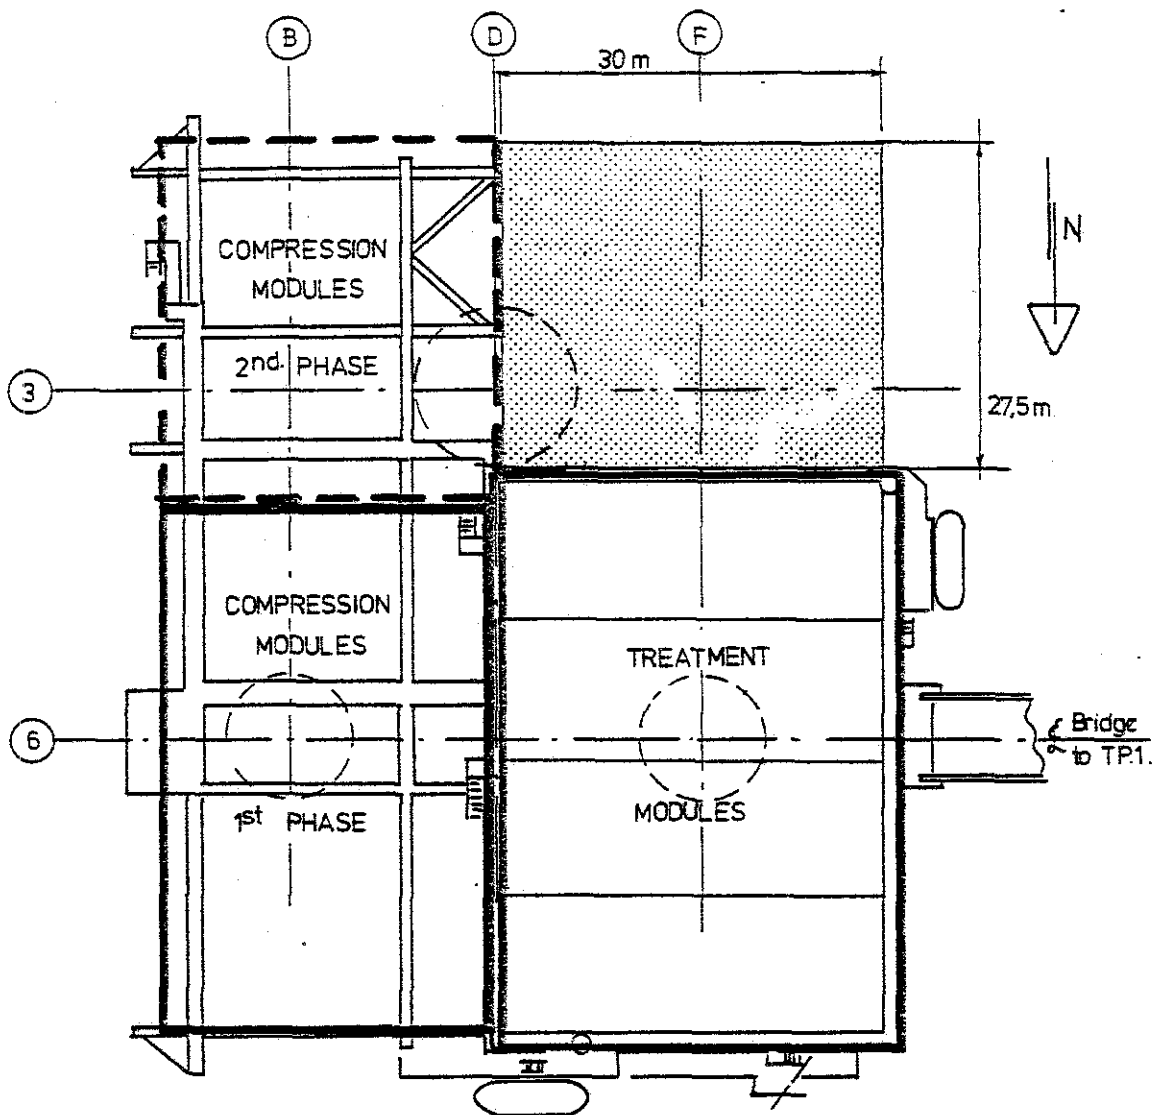

A 825 m² area is available in the South West corner of Main deck (level: +35m) in the alignment of the existing Treatment modules.

TOTAL LOAD : 1800MT.

		elf		Installation TCP2 System	
		aquitaine		Job no.	
		norge a/s		Scale	
0 4.12.79 First issue		p.o.box 168 4001 Stavanger		AVAILABLE AREA MAIN DECK	
Rev.	Date	DESCRIPTION	by	app.	Drwg. no.
Contractor					FF 85 00 00 0030
				FRIGG FIELD	Rev. Sheet
					0 /

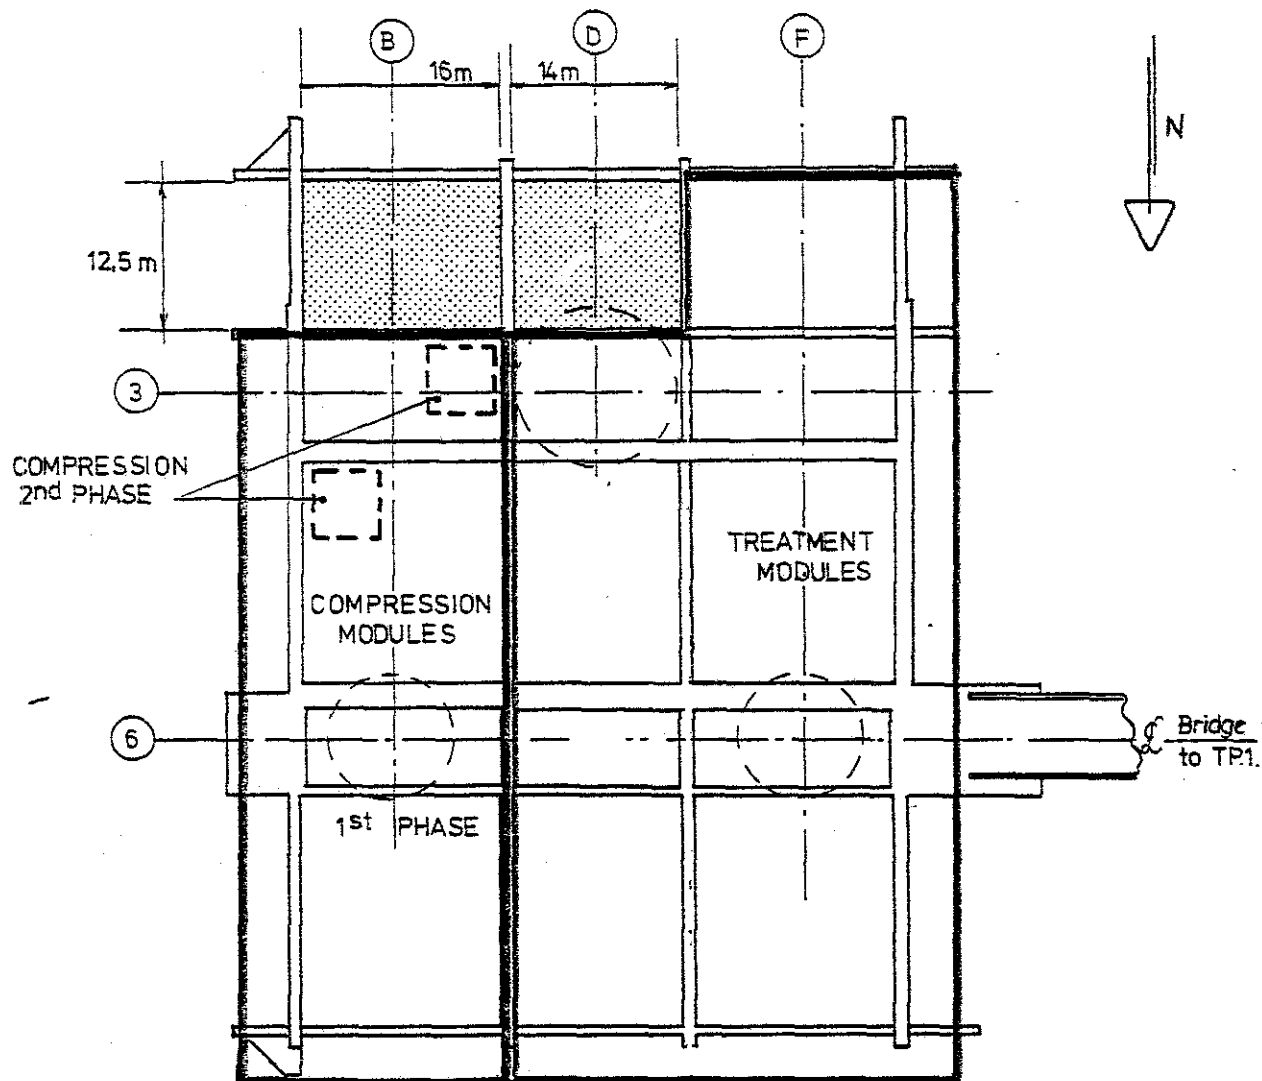

A 375 m² area is available in the South East corner of the Cellar deck (level +27m) included in the Support frame structure.

TOTAL LOAD : 1000 MT.

						Installation TCP 2		System	
0 4.12.79		First issue		S.B. H.P.		Job no.		AVAILABLE AREA CELLAR DECK.	
Rev.		Date		DESCRIPTION		Scale			
Contractor						Drwg. no.		Rev.	
						FF B5 00 00 0031		Sheet /	
						FRIGG FIELD			

elf
aquitaine
norge a/s

p.o. box 168
4001 Stavanger



FRIGG FIELD

FF 88 20 00 7300 - Tie In Piping Arrangement Cellar Deck -
El. 100.000. (Figure 1.8)

- FF 88 20 00 7305 - Tie In Piping Arrangement Main Deck -
El. 108.850. (Figure 1.9)
- FF 88 20 00 7307 - Tie In Piping Arrangement Upper Deck -
El. 116.350. (Figure 1.10)
- FF 83 20 00 8860 - General Arrangement of DP-2 Package of
Methanolated Water Injections. (Figure 1.11)

These drawings give mainly an outline of the piping and mechanical installations.

A major part of the electrical and instrumentation work is integration into existing systems for safety, process operations, shut down system and power distribution in TCP-2 area M32 and P13 and on QP platform.

FIGURE 1.6

Drawing No.: FF 88 20 00 0101

Pancake 53 - Plot Plan

FIGURE 1.7

Drawing No.: FF 88 20 00 0105

Static Module 50 - Plot Plan

FIGURE 1.8

Drawing No.: FF 88 20 00 7300

Tie-In Piping Arrangement Cellar Deck

FIGURE 1.9

Drawing No.: FF 88 20 00 7305

Tie-In Piping Arrangement Main Deck

FIGURE 1.10


Drawing No.: FF 88 20 00 7307

Tie-In Piping Arrangement Upper Deck

FIGURE 1.11

Drawing No.: FF 83 20 00 8860

General Arrangement of DP-2 Package of Methanolated Water Injections

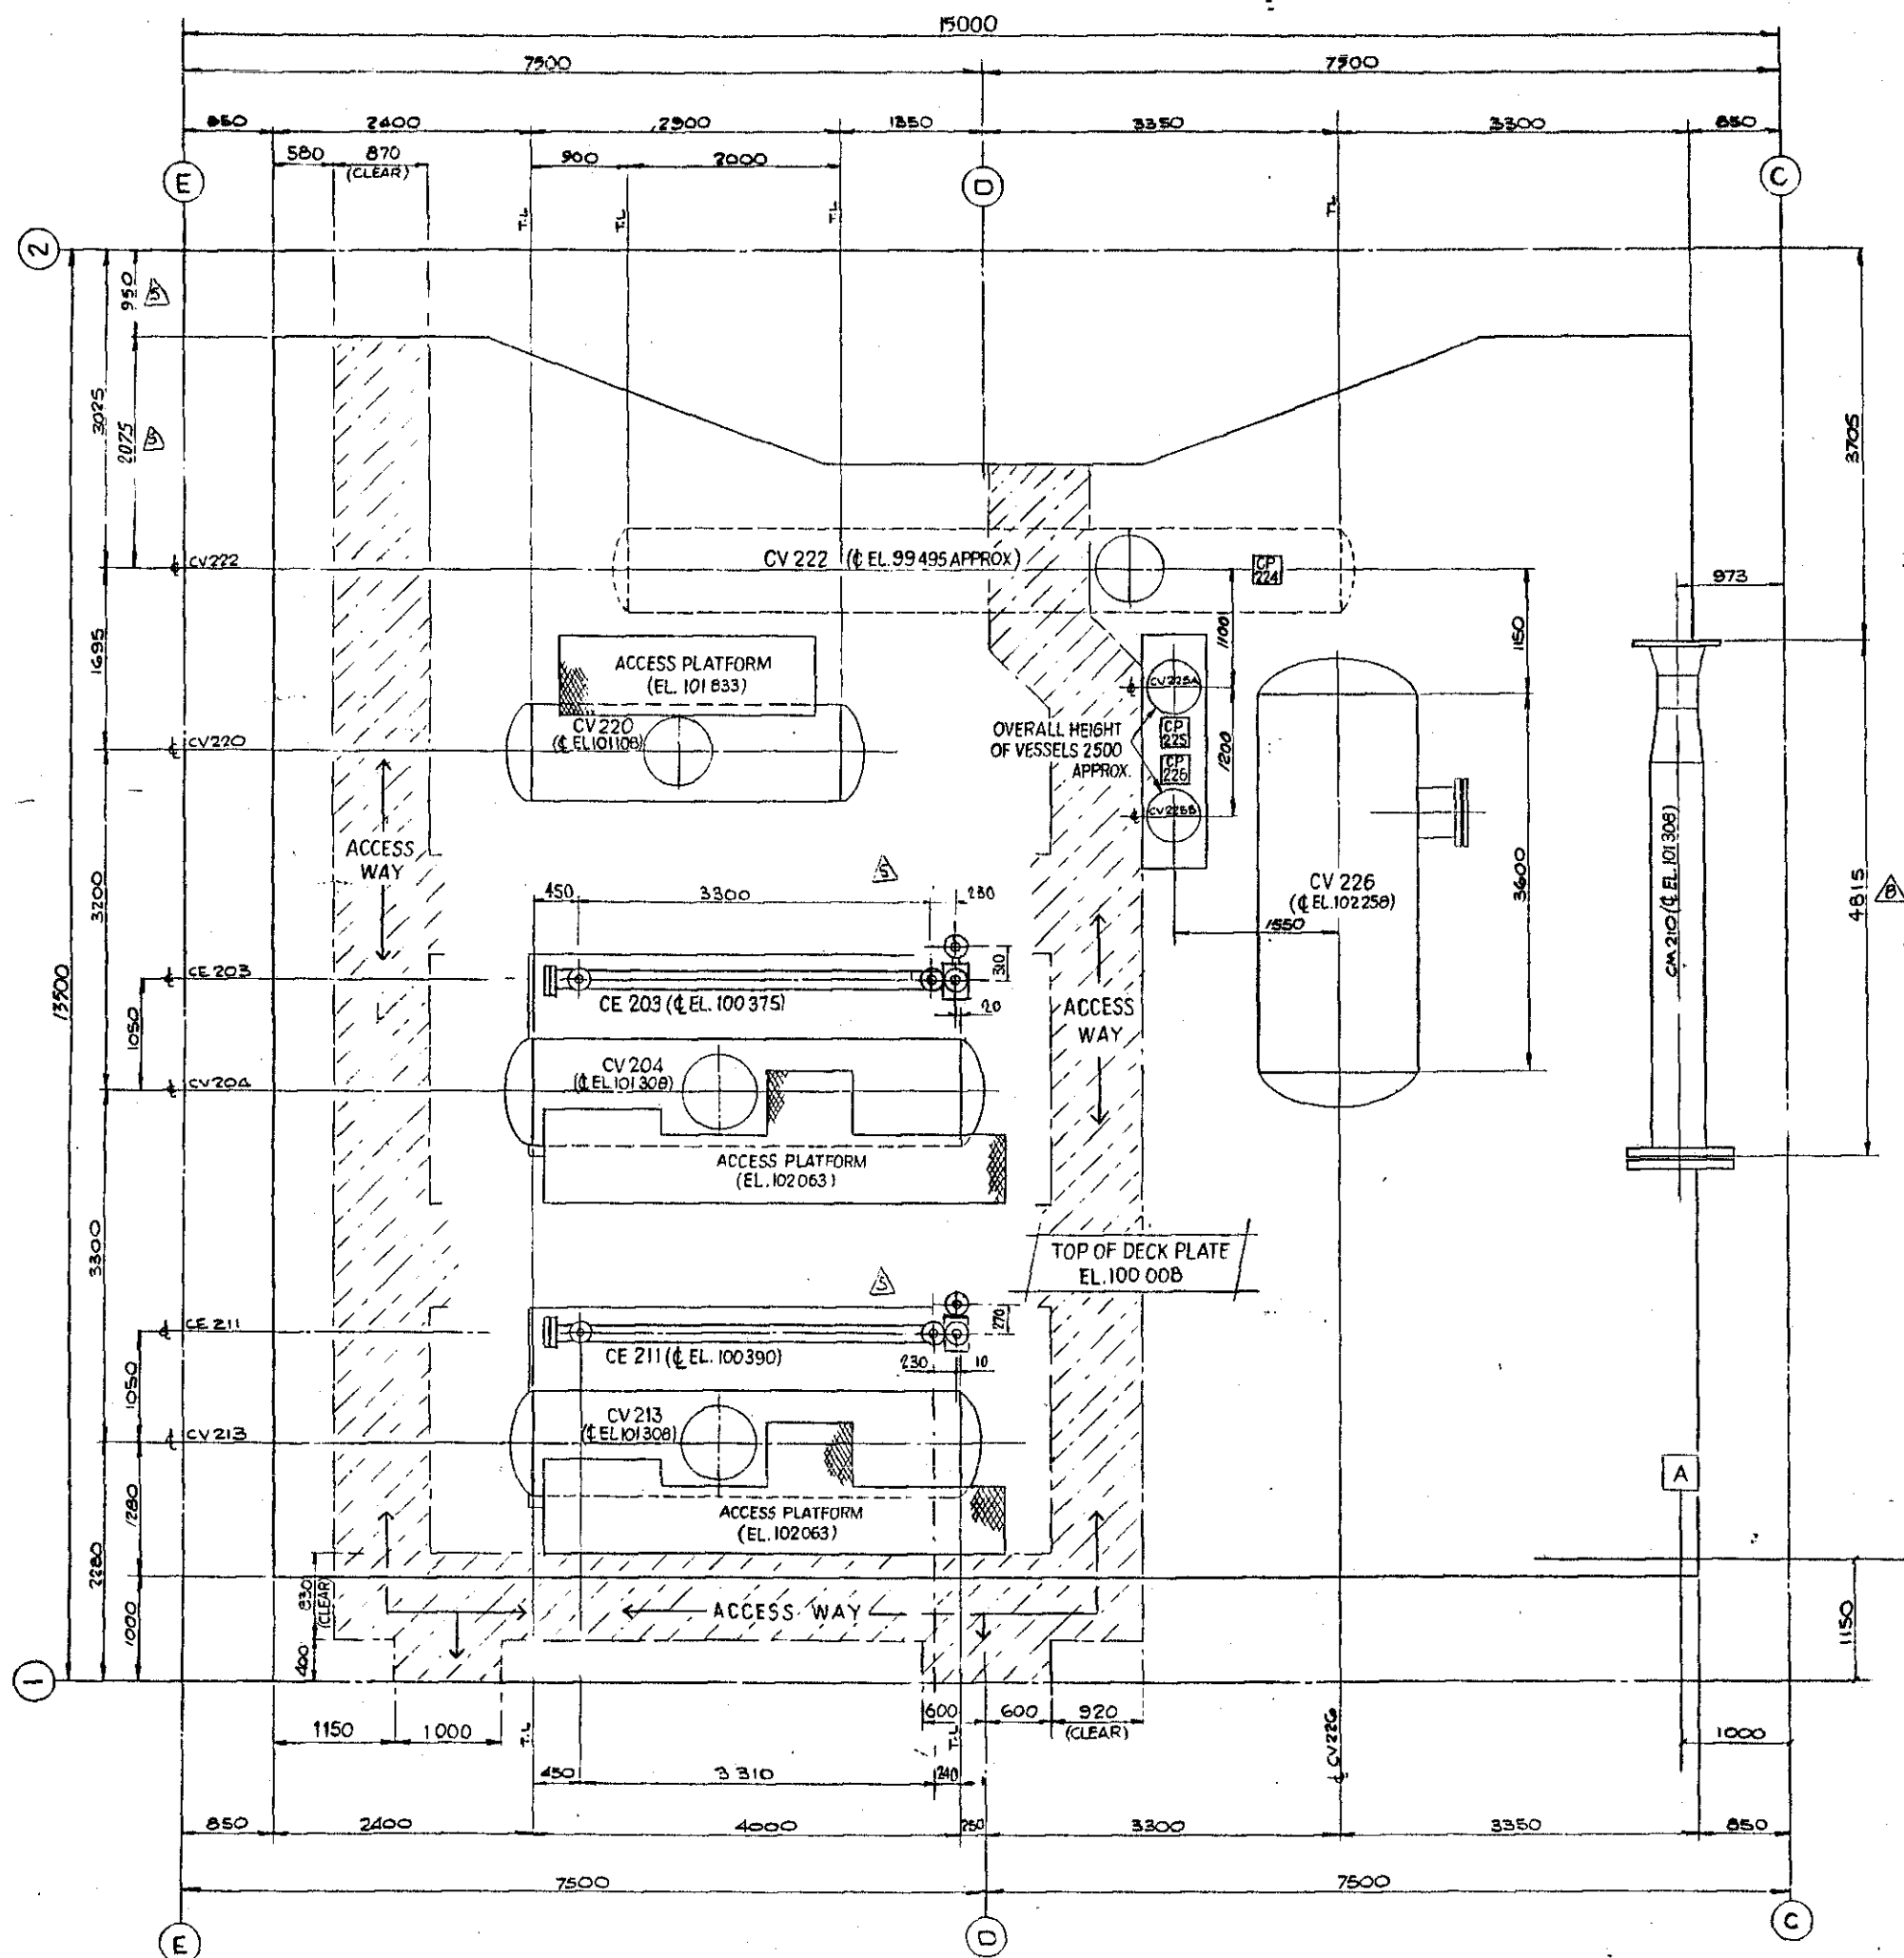


ITEM	DESIGNATION	DRY WEIGHT	OPER WEIGHT	TEST WEIGHT	REMARKS
CE 203	JOIN CONDENSATE HEATER	18	15	15	
CV 204	JOIN CONDENSATE METHANOL SEPARATOR	25	45	60	
CE 211	NEF CONDENSATE HEATER	13	15	15	
CV 213	NEF CONDENSATE METHANOL SEPARATOR	25	45	60	
CV 220	METHANOLATED WATER FLASH DRUM	17	48	48	
CV 222	METHANOLATED WATER DRAINAGE TANK	20	45	50	REMOVABLE
CP 224	(WITH PUMP)				
CV 225A, CV 225B, CP 225, CP 226	INHIBITOR DRUMS (WITH PUMPS)	10	16	16	
CV 226	L.T. RELIEF SCRUBBER	45	75	120	
CM 210	NEF PIG RECEIVER	55	60	70	TEMPORARY

(LOADS IN KILONEWTONS)

off aquitaine norge a/s
APPROVED FOR
HOOK-UP

TCP2 EXTENSION
HOOK UP
AS BUILT
DRAWING

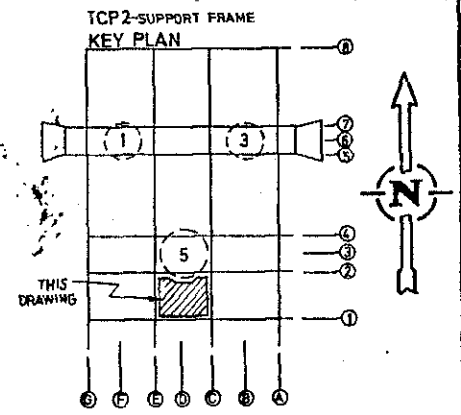


off aquitaine norge a/s
APPROVED FOR
CONSTRUCTION

NO	DATE	DESCRIPTION	BY	CHKD
10	21.08	AS BUILT		
9	18.03	APPROVED FOR HOOK-UP		
8	10.08	LENGTH OF CM 210 WAS 4565	EL	
7	17.02	LENGTH OF CM 210 WAS 4562	EL	
6	22.02	ISSUE FOR CONSTRUCTION APPROVAL	EL	
5	10.01	CE 203 - CE 211 REDRAWN	EL	
4	10.01	ISSUE FOR YARD TENDER	EL	
3	10.01	REDRAWN TO LARGER SCALE	EL	
2	10.01	REVISED IN ACCORDANCE WITH E&N REQUIREMENTS	EL	
1	21.01	REVISED IN ACCORDANCE WITH E&N COMMENTS	EL	
0	10.01	First issue	EL	


off aquitaine norge a/s DRWG. NO.: PP 04 P53 1008

TCP 2 EXTENSION


off aquitaine norge a/s P.O. Box 100 - 4000 Stavanger	
A1	TCP 2 GENERAL
PANCAKE 53	
PLOT PLAN	
Job no: F 087	Scale: 1:33%
FRIGG FIELD	Drawn by: FF 08 20 00 0101

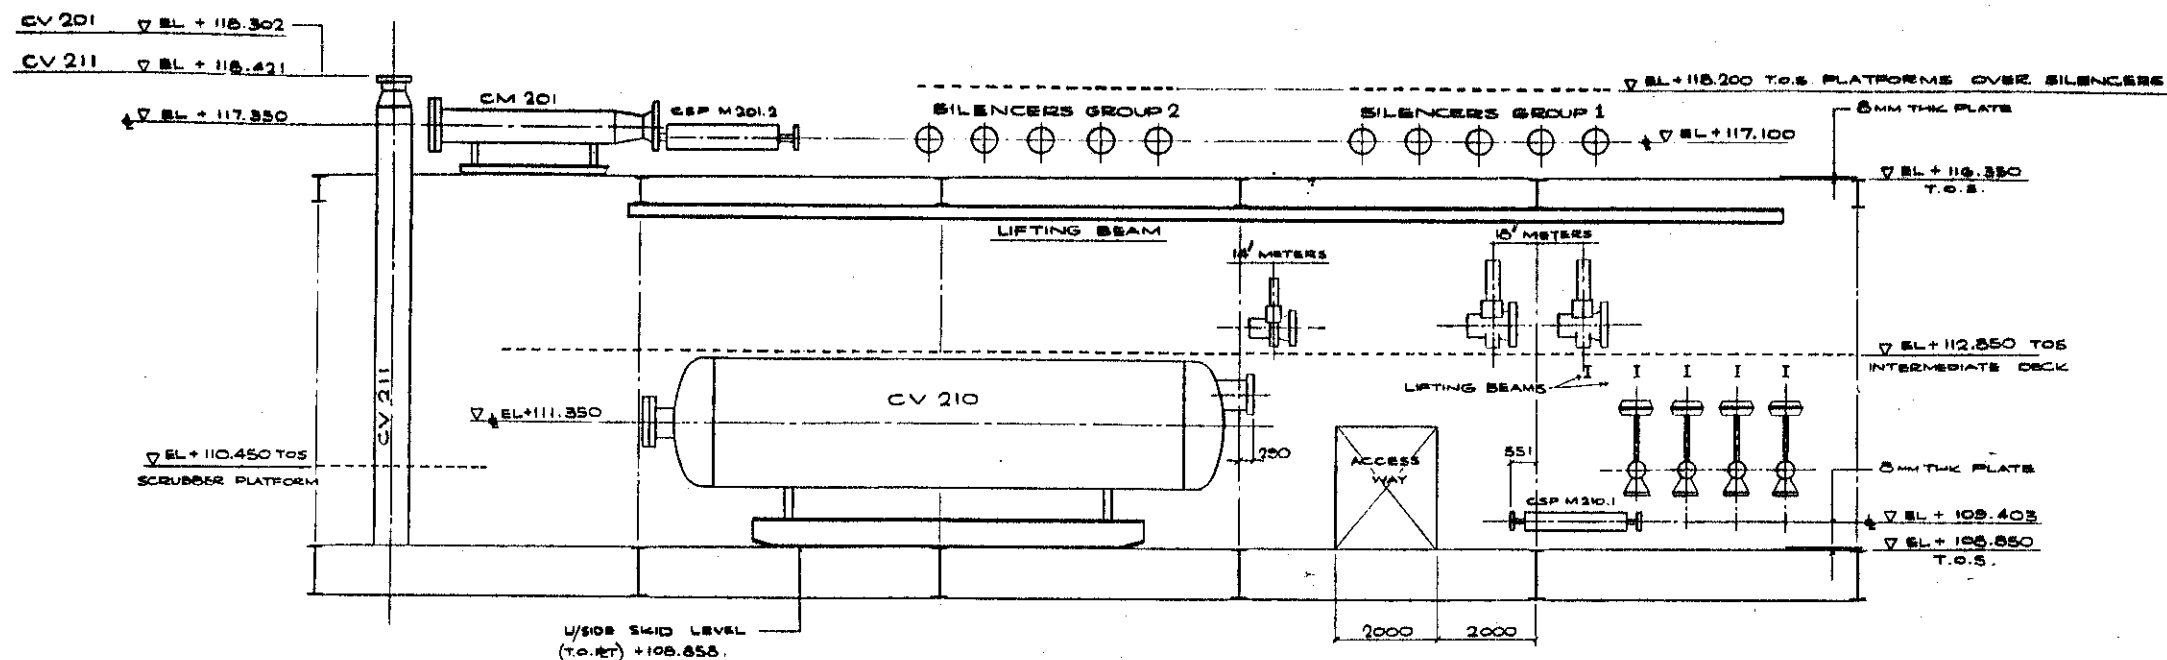


ELEVATION LOOKING NORTH

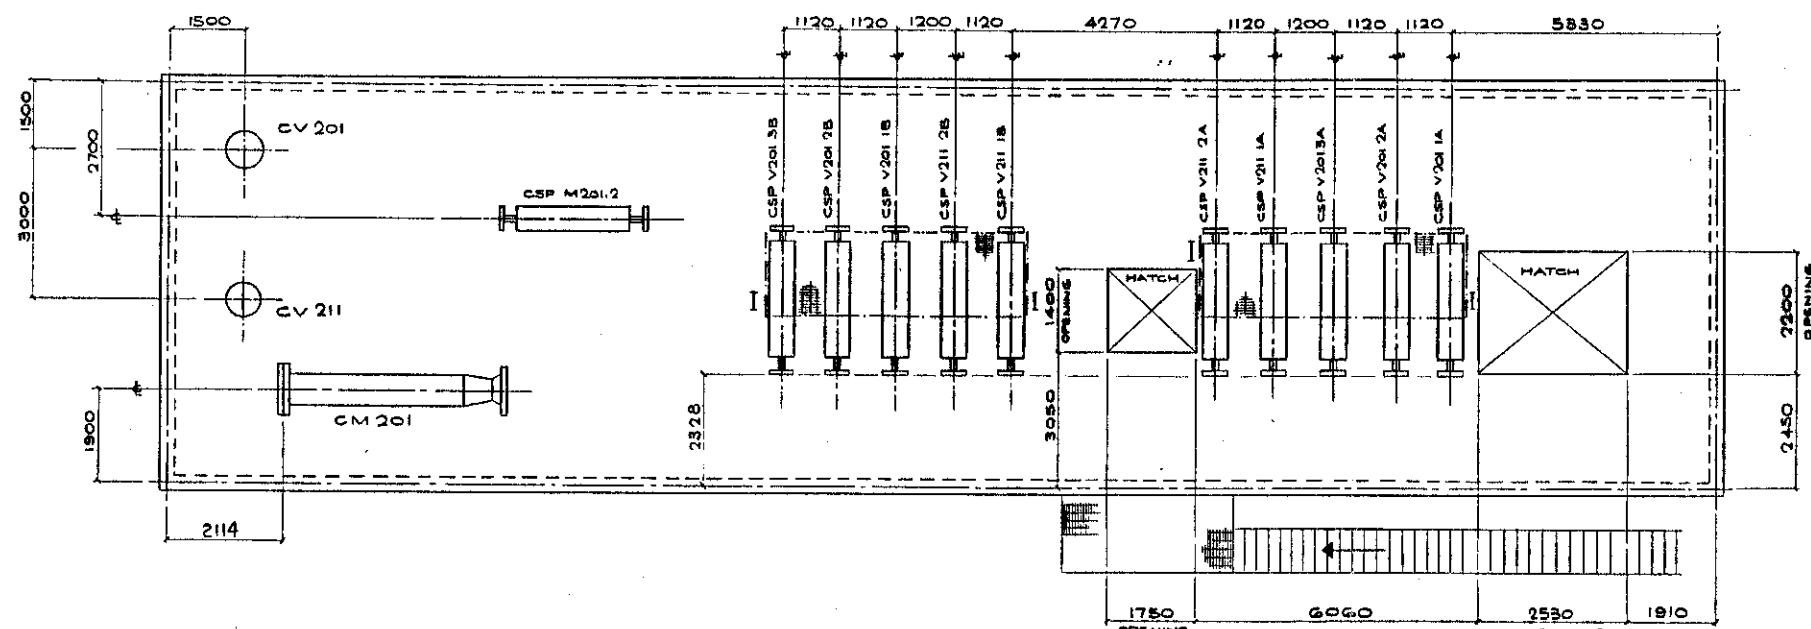

PLAN ON DECK @ 116.350 LVL

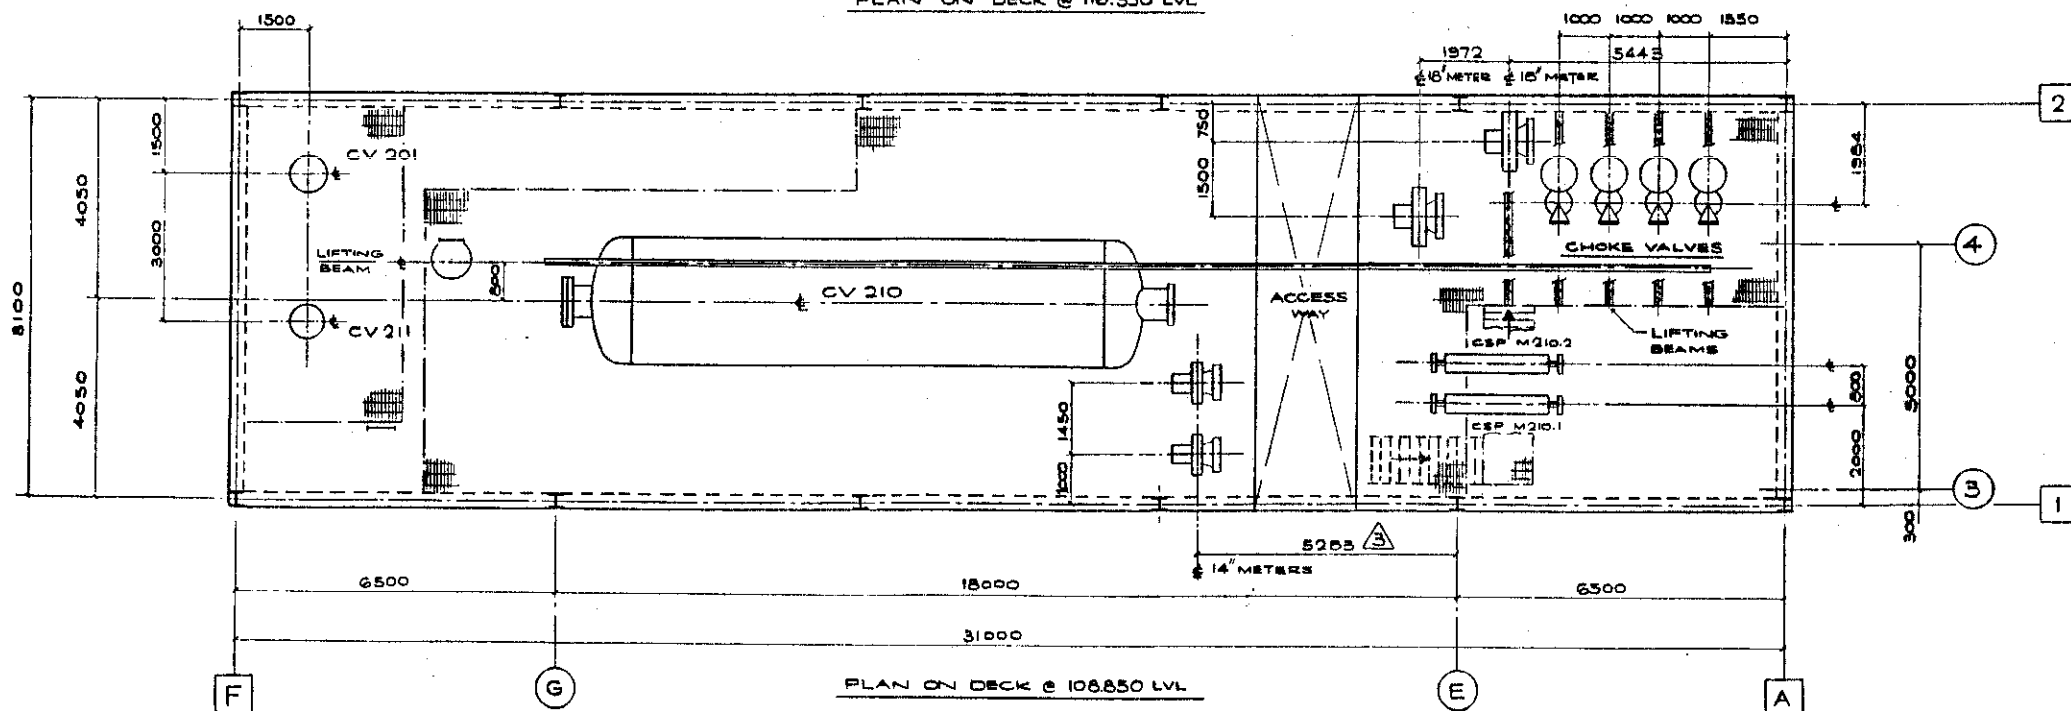

PLAN ON DECK @ 108.850 LVL

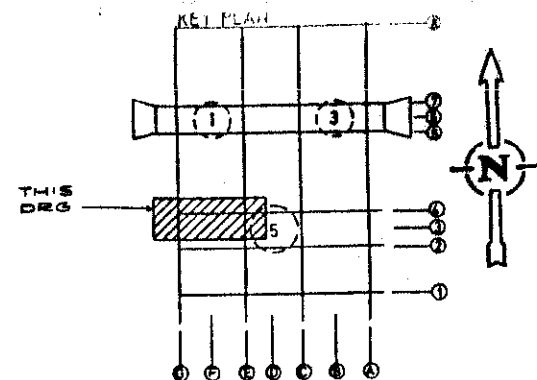

ITEM	DESIGNATION	LOADS IN KN			REMARKS
		DRY WT	OPER WT	TEST WT	
CM 201	ODIN PIG RECEIVER	75	80	90	WITH SUPPORTS
CV 201	ODIN GAS SCRUBBER	90	105	110	WITH SUPPORTS
CV 211	NEF GAS SCRUBBER	70	80	85	WITH SUPPORTS
CV 210	NEF SLUG CATCHER	1000	1450	1520	WITH SUPPORTS & SKID
	18' METER 'DANIEL'	40	40	41	
	14' METER 'DANIEL'	30	30	31	
CSP M201.2	SILENCER	10	10	10	
CSP M210.1	SILENCER	10	10	10	
CSP M210.2	SILENCER	10	10	10	
	SILENCERS GROUP 1.	75	75	75	
	SILENCERS GROUP 2.	75	75	75	

TCP EXTENSION
HOOK UP
AS BUILT
DRAWING


off aquitaine norge a/s
APPROVED FOR
HOOK-UP



off aquitaine norge a/s
APPROVED FOR
CONSTRUCTION

8	01/28/88	AS BUILT	KG	37
7	08/03/88	APPROVED FOR HOOK-UP	KG	37
6	11/4/87	2114 WAS 2314	P.C.	
5	22/02/87	ISSUED FOR CONSTRUCTION APPROVAL	P.R. KLL	DE
4	30/08/86	ISSUE FOR YARD TENDER	HJ	SE
3	30/08/86	DIMENSION AMENDED	HJ	SE
2	22/08/86	RE DRAWN	HJ	SE
1	13/08/86	ISSUED FOR COMMENTS	SP	TEL
0	23/08/86	Final Issue	SP	TEL
REV	DATE	DESCRIPTION	BY	APP. TOWER

off aquitaine norge a/s DRWG. NO: PP. 04. M50.01052

TCP 2 EXTENSION

	elf aquitaine norge a/s P.O. Box 105 - 4051 Sandness			
	A1	Installation	System	GENERAL
		STATIC MODULE 50		
	Job no F0687	PLOT PLAN		
	Revis 1:75			
FRIGG FIELD	Drwg. no	FF 88 20 00 0105	Rev.	8
				1/

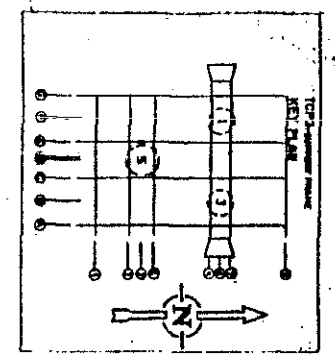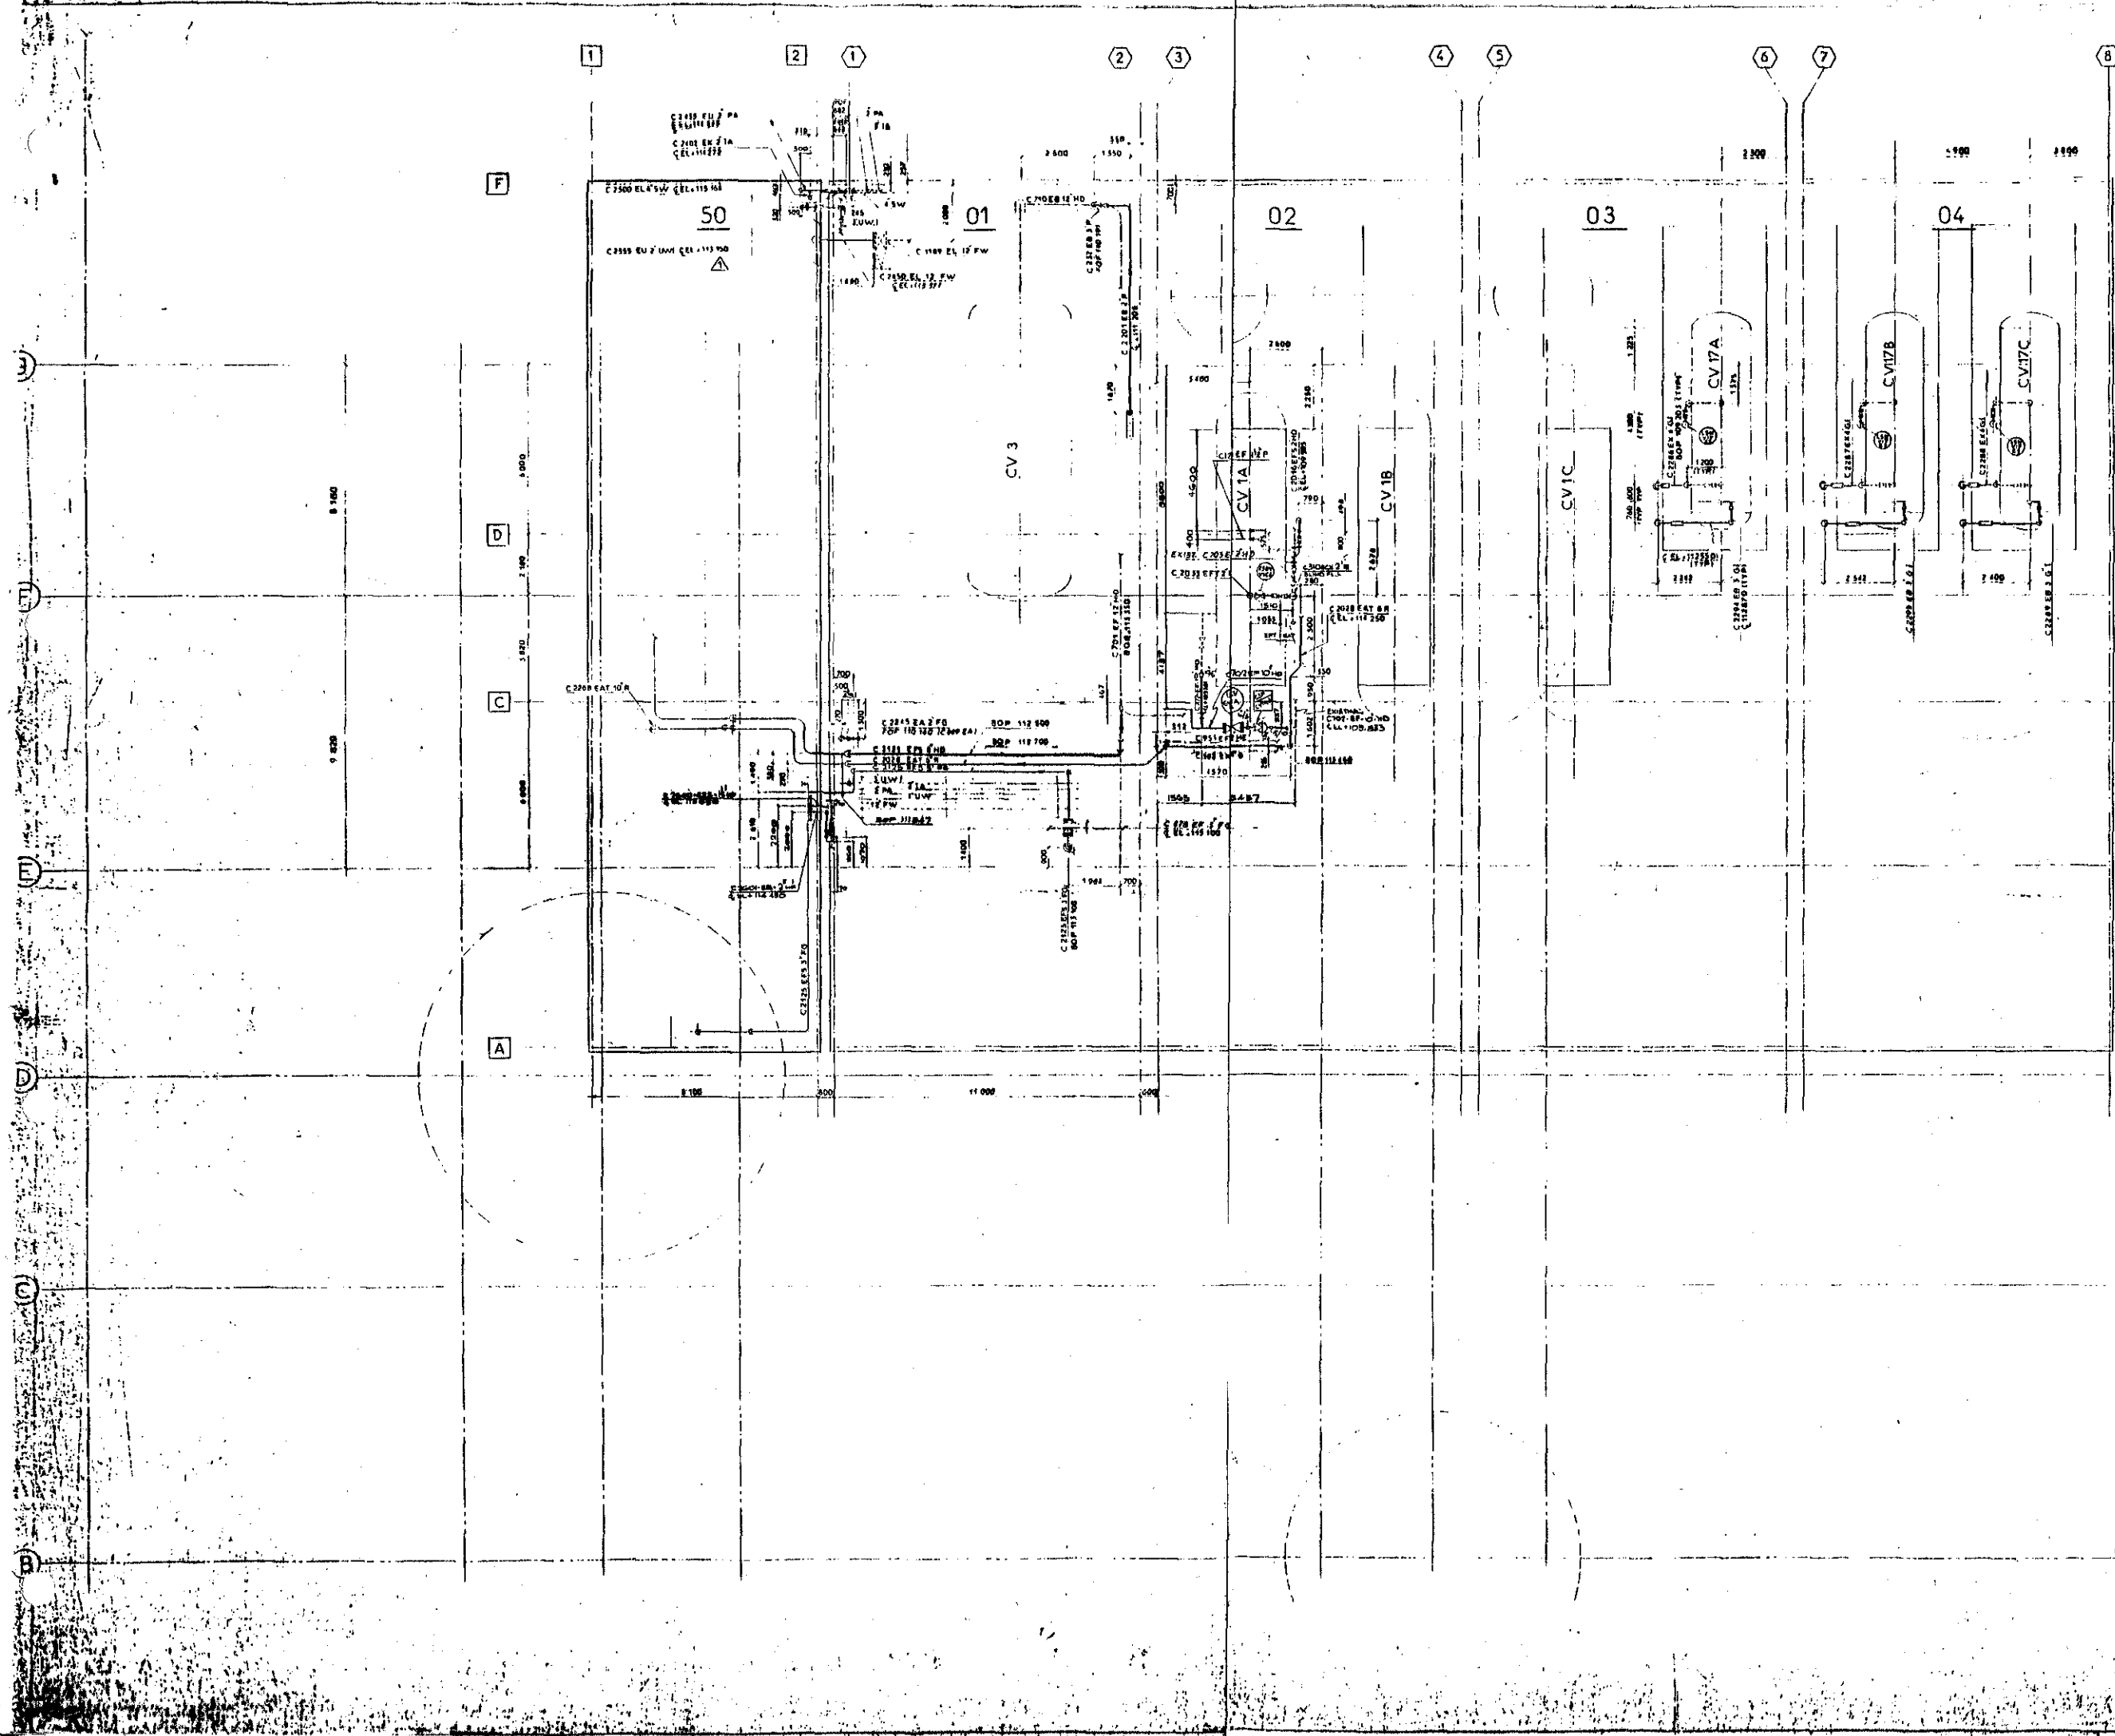

TCP 2 EXTENSION
 WORK UP
AS BUILT
 DRAWING

APPROVED FOR
 HOOR-UP

APPROVED FOR
 CONSTRUCTION


TCP 2 EXTENSION



WORK UP

AS BUILT


MAIN DECK

EL. 100

1000

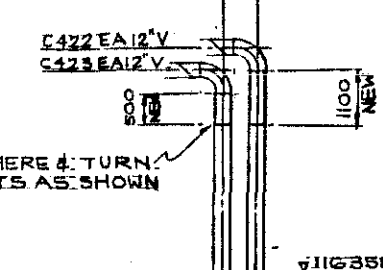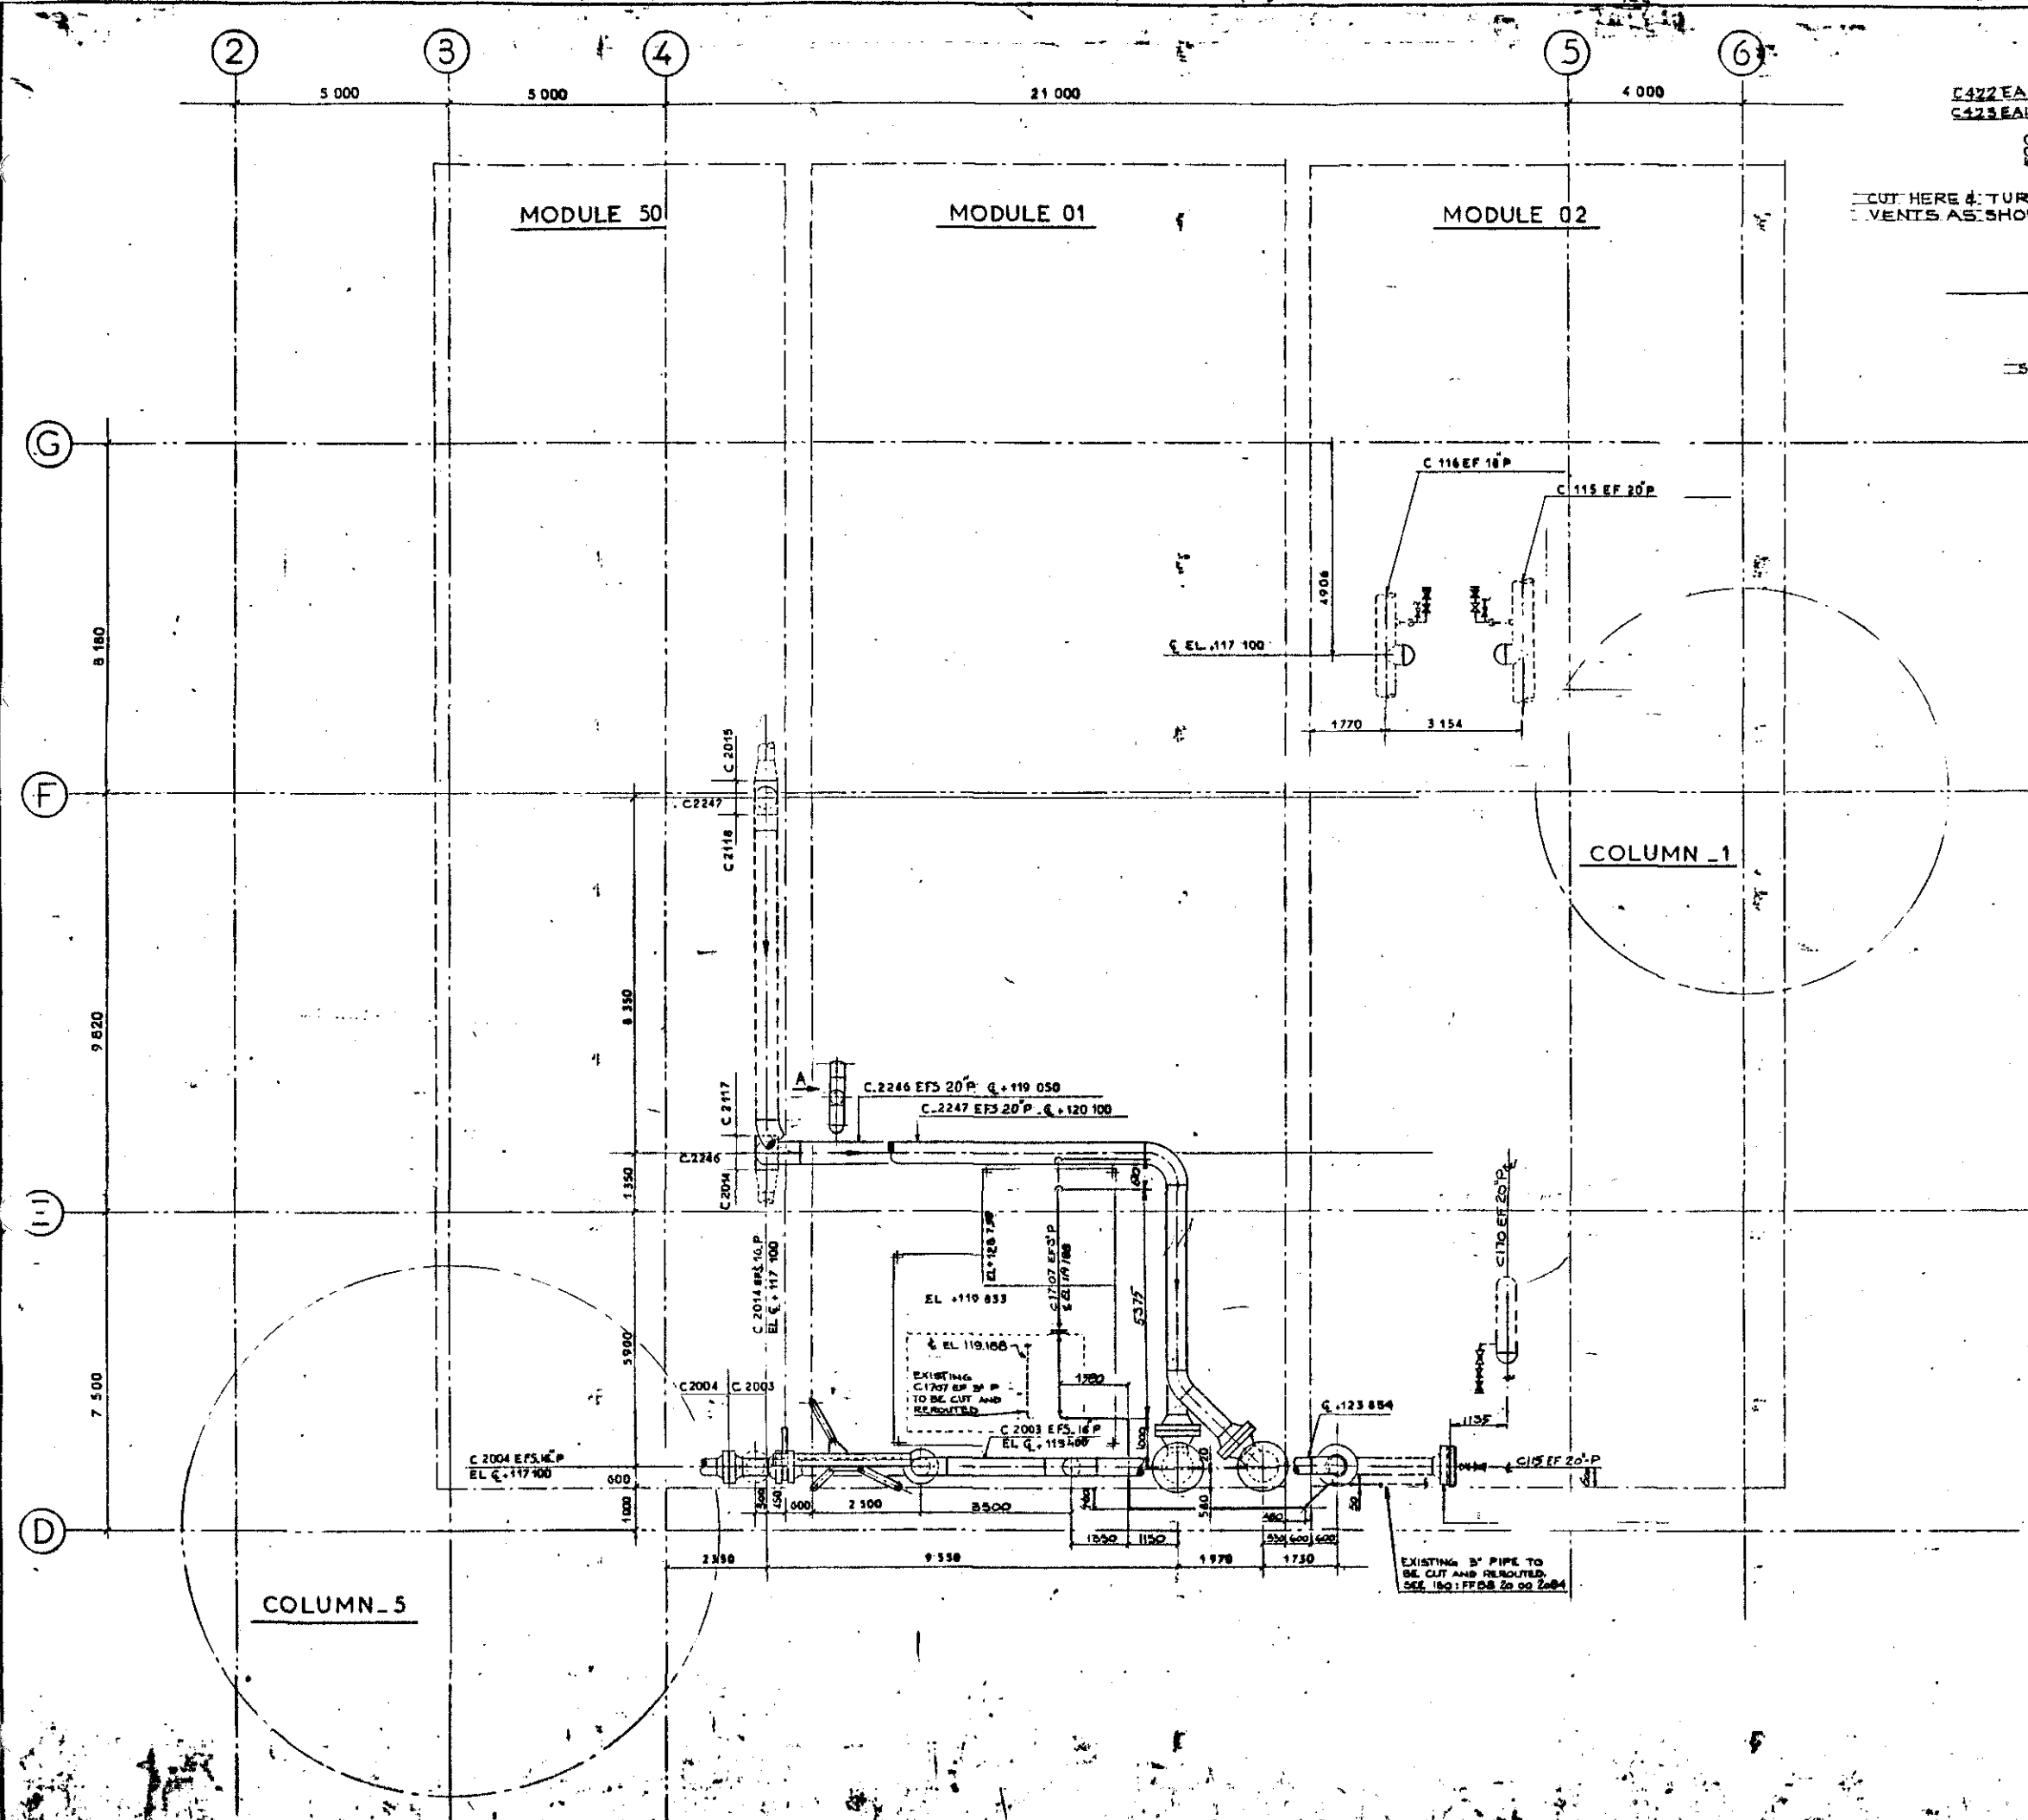

VIEW ON A
SHOWING MODS TO EXIST VENTS

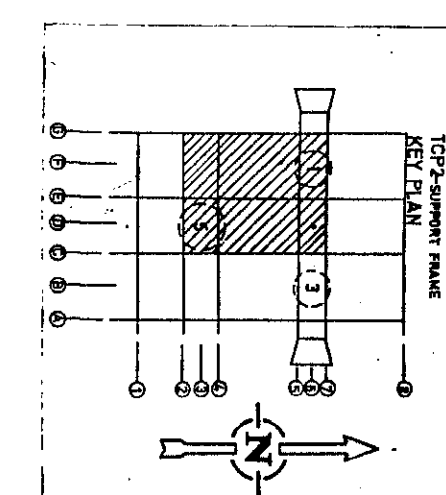

TCP2 EXTENSION
HOOK UP
AS BUILT
DRAWING

self aquitaine norge AS
APPROVED FOR
CONSTRUCTION

8	2.3.83	APPROVED FOR HOOK-UP			RL	
7	12.12.82	EXISTING 3" PIPE REQUESTED			RL	
6	22.2.82	ISSUED FOR CONSTRUCTION APPROVAL			DE	
5	15.2.82	MODS AS NOTED $\Delta \times 4$			R.R	
4	13.1.82	REVISION AS NOTED $\Delta \times 1$			HJ	
3	13.1.81	GENERAL REVISION			HJ	
2	30.4.81	ISSUE FOR YARD TENDRLE			HJ	
1	2.2.81	AS BUILT TO NRO C&D'S FROM HDG & PREW			EG	
					GA	
					8/79	
					AP	
REV.	DATE	DESCRIPTION			BY	APP. CLERK

self aquitaine norge AS DRWG. NO.: L0_04 000 0307

TCP 2 EXTENSION

self aquitaine norge AS P.A. Des 102 - 4001 Manager

GENERALITIES:



TCP2

PIPING ARRANGEMENT

UPPER DECK TENS

EL. 116 350

PROJ. FIELD

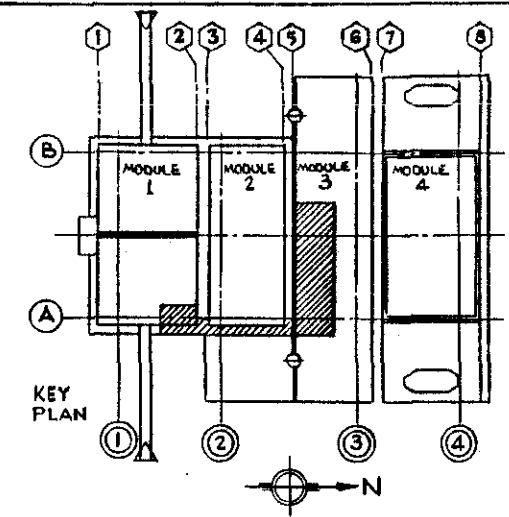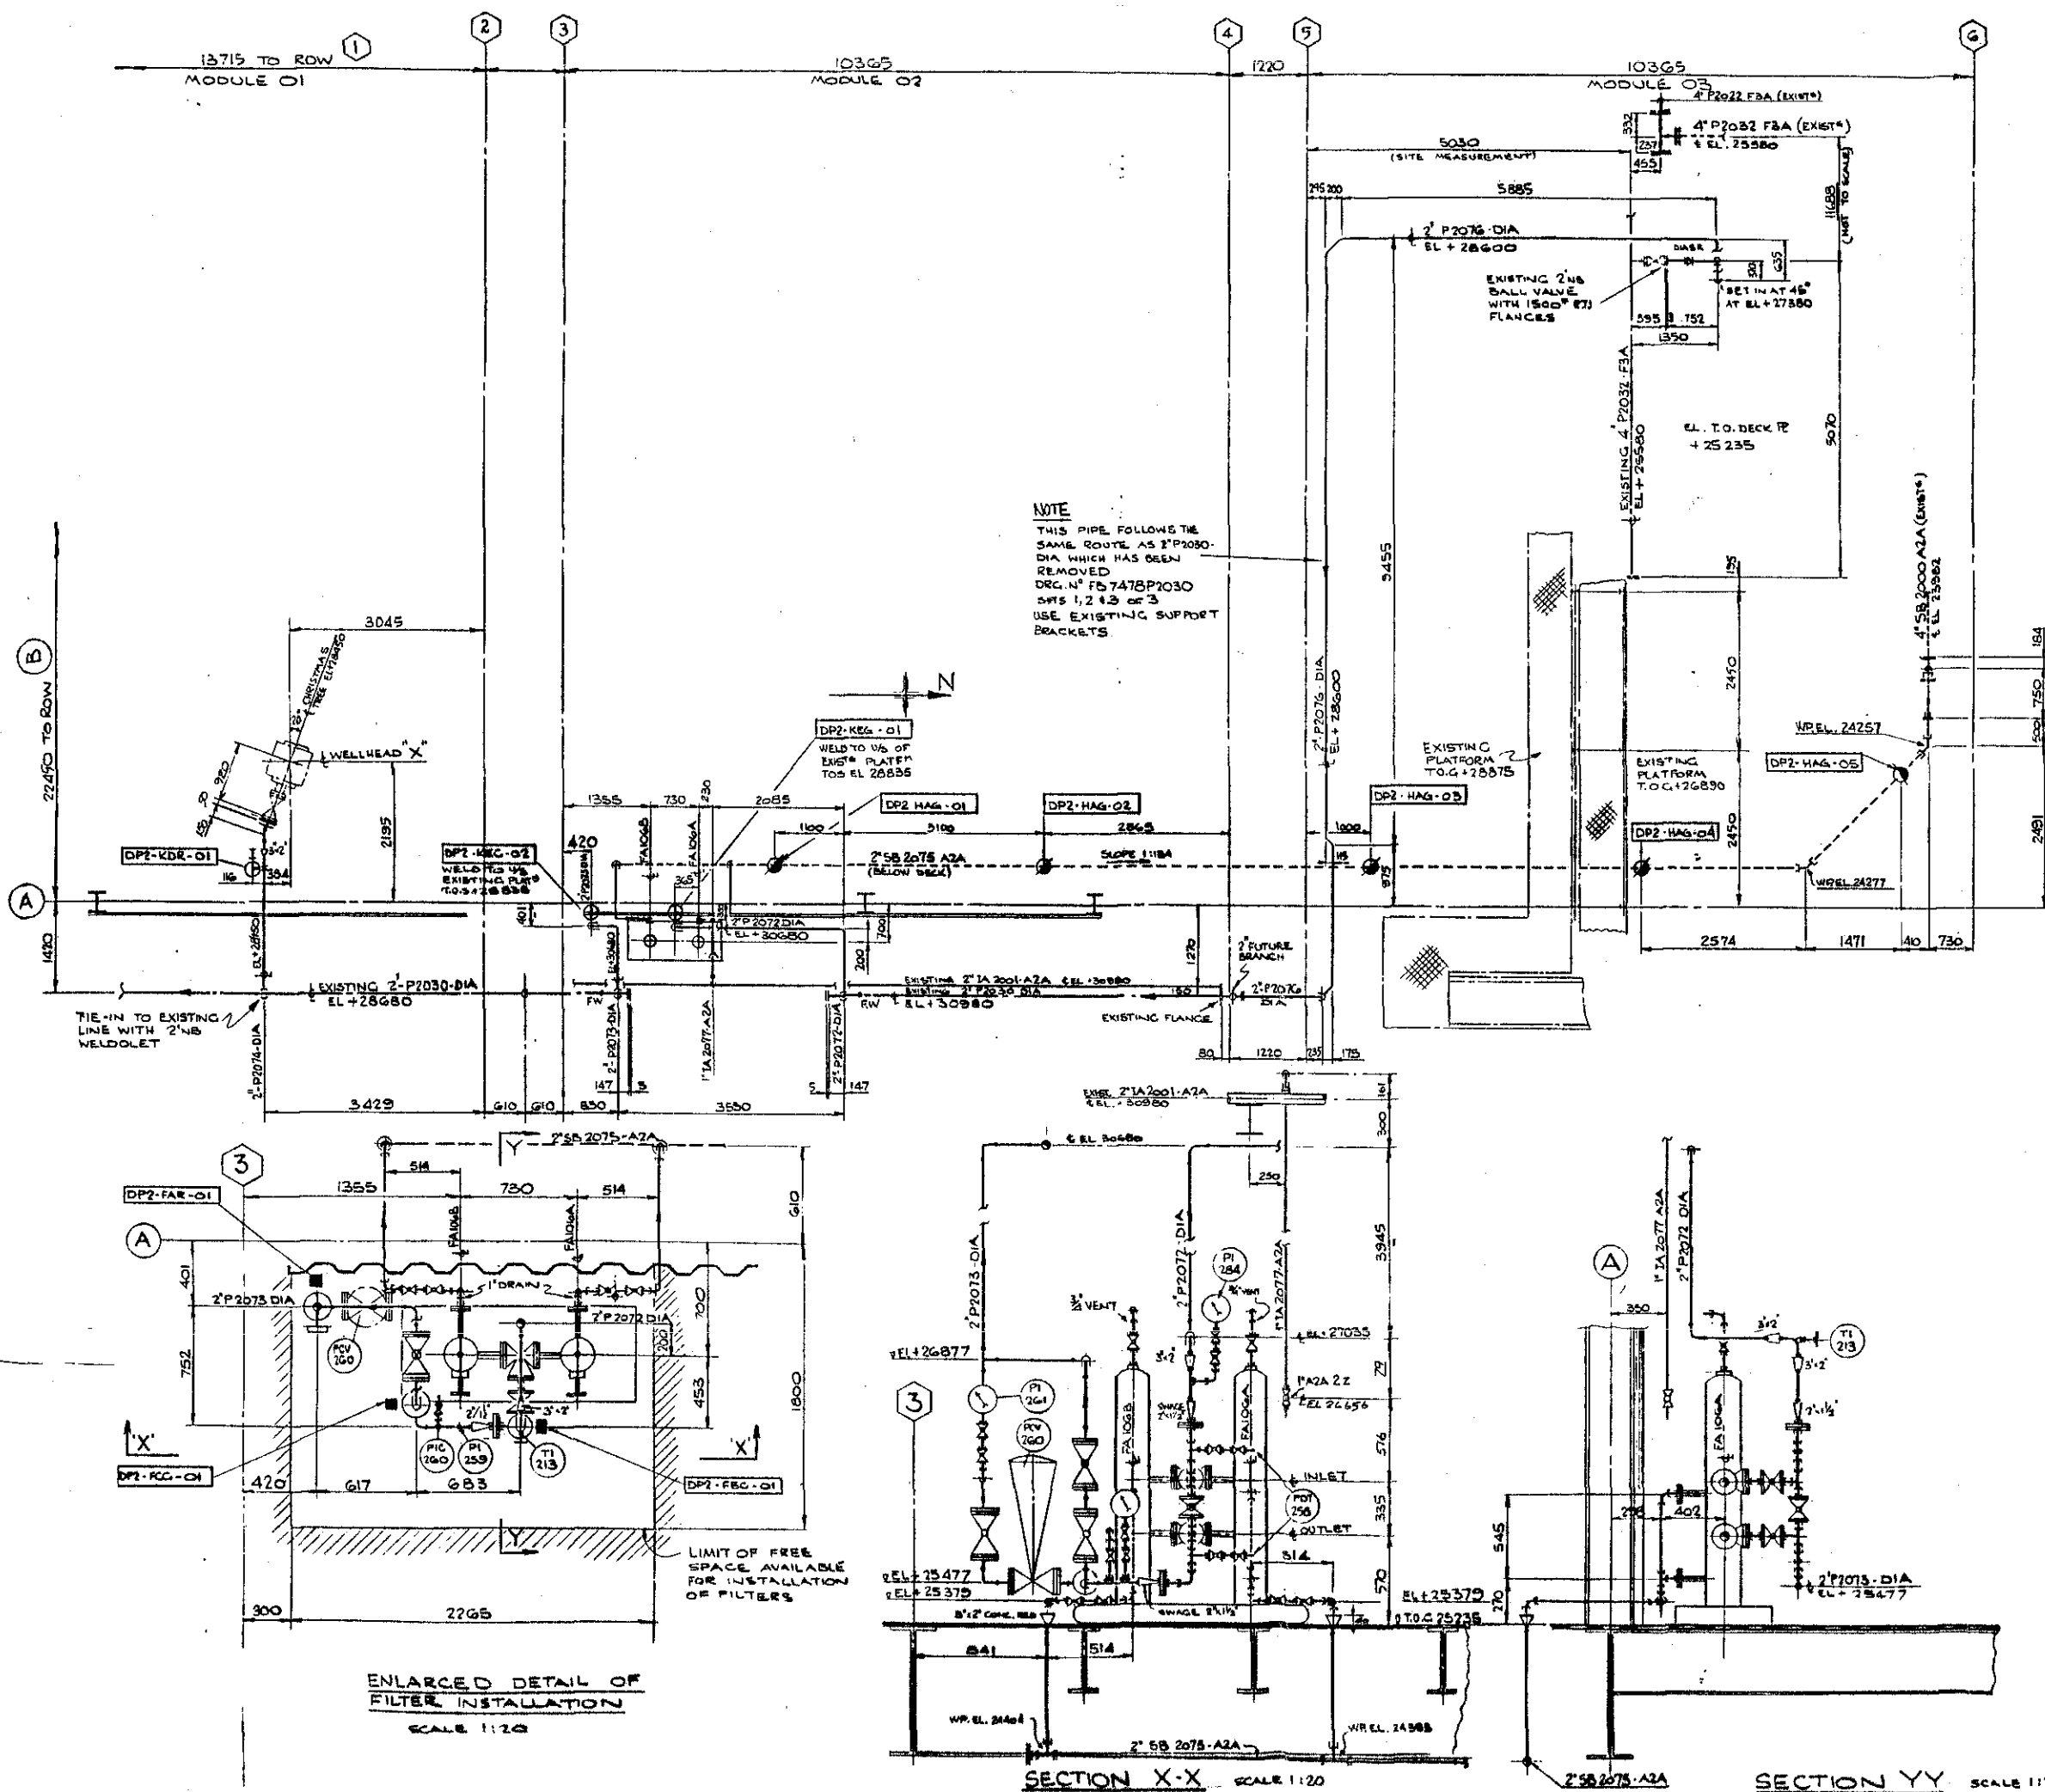

TCP 2 EXTENSION
HOOK UP
AS BUILT
DRAWING

off aquitaine norge a/s
APPROVED FOR
HOOK-UP.

6	21.03	AS BUILT TO INFO REC'D FROM HOG 4 PCELL	K2	CA	
5	14.08	C. UP ISSUE	-	CA	28
4	21.03	LINE 2'S 2075A2A, 1' 1" P2022 FSA ADDED		CA	
3	2.03.01	APPROVED FOR WORK-UP			21
2	28.08.02	LINE 2' 1A2001A2A & 1' 1A2017A2A ADDED		CA	
1	28.08.02	REVISED TO EAN COMMENTS	RP		
0	4-02	FINAL ISSUE	200	CA	
REV	DATE	DESCRIPTION	BY	APP	CHECK

FRIGG FIELD

DRWG. NO.: GA.04.DP2.06002

TCP 2 EXTENSION

off aquitaine norge a/s P.O. Box 100 - 4051 Stavanger

AI	DP2	System
		METHANOLATED WATER

GENERAL ARRANGEMENT
OF DP2 PACKAGE OF
METHANOLATED WATER
INJECTION

Scale: 1:50

FF 03.10.02.0860

6

1.4 PROCESS DESCRIPTION

1.4.1 Introduction

The purpose of the new installation on the TCP-2 platform is to:

- Treat the gas coming from the NORTH EAST FRIGG (NEF) and ODIN fields.
- Recover the condensate
- Meter the treated gases and the condensates
- Inject the gases into the FRIGG gas production system for gas compression and glycol dehydration and further transportation to Scotland.
- Inject the condensates into the FRIGG condensate system.

Methanol will be injected in the ODIN and NEF field streams at the wellhead to prevent hydrate formation in the sea line. The methanolated water facilities on TCP-2 are common to both fields.

The ODIN and NEF gases may eventually have to be compressed in the future. This depends on the reservoir pressure decline. There are two possibilities for each field:

- Slow pressure decline (corresponding to a water drive in the reservoir)
- Steep pressure decline (corresponding to no water drive in the reservoir)

NEF gas composition, reservoir pressure and production profile is given in Appendix 1.

ODIN gas composition, reservoir pressure and production profile is given in Appendix 2.

In the case of water drive, no compression of ODIN and NEF is required to raise the pressure up to FRIGG gas pressure. In the case of no water drive, compression is required.

A hydrocarbon material balance has been carried out for the sizing case, which corresponds to the start-up year and no water drive in the reservoir. This balance was based on computer simulations for the Slug Catchers CV 1A/CV 210 and for the Condensate/Methanol Separators CV 204/CV 213.

The sizing case for ODIN methanol/water material balance corresponds to year 1987 and no water drive in the reservoir, while the same material balance for NEF corresponds to year 1984 and no water drive.

The Process Flow Diagrams showing the material balance are attached in Appendix 3.

1.4.2 Description

1.4.2.1 NEF Gas Treatment (Ref. drawing FF 88 00 00 5031 - Appendix 3)

The 16" sea line from NEF which is 17.4 km long, will contain gas, hydrocarbon liquid and methanolated water. The design flowrate is 7.7 MSCM/D, which corresponds to the start-up year and no water drive in the reservoir. The purpose of the methanol, is to prevent hydrate formation in the sea line.

At the arrival on TCP-2, the gas pressure is adjusted by four choke valves (HIC M 210 A/B/C/D), before the fluid enters vessel CV 210 which is the NEF Slug Catcher.

A Pig Receiver, CM 210,, will be used for start-up purposes during dewatering of the sea line. After the start-up period is over, this Pig Receiver will be disconnected and removed.

In vessel CV 210, the gas is separated from the condensate and methanolated water. The operating pressure in the vessel, will vary between the values 14 - 136 bara depending on the reservoir pressure decline and on the time elapsed after start-up. The fluid enters vessel CV 210 which is designed for a pressure of 177.5 bara at 5°C.

In order to get a good separation, the vessel contains internals as inlet diffuser, dixon plates and mist extractor. The diffuser is an inlet device which is mainly used as deflector. Here the primary separation of the liquid and gas takes place. The dixon plates arrangement over the settling section eliminates agitation of the separated liquid. This greatly reduces chances of foaming and the possibility of revaporizing any of the liquid into the gas phase.

Liquid droplets that will not settle out of the gas stream due to little or no gravity difference between them and the gas phase, will be entrained and carried out of the Slug Catcher with the gas. This is the reason why a mist extractor has been installed near the gas outlet. Small liquid droplets will coalesce and collect and form larger droplets, which will by gravity be drained back into the liquid phase. Thereby the liquid carry over in the gas phase is limited to complete removal of liquid droplets entrainment in the 20 micron range.

The Slug Catcher effluent gas is sent to the NEF Metering Scrubber CV 211, which will later become the compression outlet scrubber if NEF gas compression is required (ref. chapter 1.4.1).

The purpose of this scrubber is to make sure that the gas is maintained in single phase at the metering station.

This vessel will therefore prevent residual water and condensate carry over in the downstream gas line. In addition the scrubber is provided with a wire mesh located at the gas outlet. The liquid content in the gas is thereby reduced such that 95% of the droplets will not exceed 10 micron at the outlet of the vessel.

The gas is further sent to the metering station which is located upstream the flow control valves. Here the gas line is split into two separate lines:

One going to compression module A or C, while
other goes to compression module B or C.

In order to have a good flow control rangeability, the flow control valves are connected in split range for each of the lines. The normal operation condition for this station, will be one line on manual control, and one line on either pressure or flow control. One thereby obtain a constant pressure for the metering tubes which is important for the metering accuracy. This set up is in conformity with the existing facilities on FRIGG TCP-2 platform.

During normal operating conditions the set point for the flow control valves are such that the flow is equally distributed in the two parallel lines. The reason for this is to have an even distribution of the flow to the main FRIGG compressors 11K01 A/B/C. Normal operating conditions corresponds to compressors 11K01 A/B working, while 11K01 C is used as stand-by.

It may happen, however, that only one of the metering tubes is used, i.e. in case of maintance, calibration etc. Then the total flow will have to go through just one of the tubes, which means that they will have to be designed for a flow rate of 6.4 MSCM/D, which is equal to the average daily production rate.

The liquid hydrocarbons and the methanolated water which is separated from the gas in vessels CV 210 and CV 211, are sent under level control to the condensate separation system (ref. chapter 1.4.2.3). This corresponds to normal operating conditions. In addition the vessel CV 210 is provided with an automatic flush.

Equipment Design Data

CV 210 NEF Slug Catcher

Design pressure	177.5 bara
Design temperature	50°C / -28°C
Capacity	7.7 MSCM/D
Dimensions	2400 ID x 9140 T/T

CV 211 NEF Metering Scrubber

Design pressure	177.5 bara
Design temperature	65°C / -28°C NOTE 1
Capacity	7.7 MSCM/D

NEF gas composition, reservoir pressure and production flow rates are given in Appendix 1.

NOTE 1:

The reason why CV 211 has a design temperature of +65°C and not +50°C, is because the vessel will become the compression outlet scrubber if NEF gas compression is required. Thus the vessel will be part of the future gas compression treatment and must therefore follow the design conditions given for future compressions.

1.4.2.2 ODIN Gas Treatment (Ref. drawing FF 88 00 00 5030 - Appendix 3)

The 20" sea line from ODIN field is 22 km long and will contain gas, condensate and methanolated water. The design flowrate is 11.2 MSCM/D, which corresponds to the start-up year and no water drive in the reservoir. The purpose of the methanol, is to prevent hydrate formation in the sea line.

At design flow this fluid enters the ODIN Slug Catcher CV 1A, which is the existing FRIGG FWKO vessel at 149 bara and 50°C. The operating pressure will, however, vary between the values 11 - 149 bara depending on reservoir pressure decline and time elapsed after start-up. Upstream this Slug Catcher a permanent Pig Receiver CM 201 is provided for the pigs which will be launched from the ODIN platform.

In vessel CV 1A, the gas is separated from the condensate and methanolated water.

In order to get a good separation, the vessel contains internals as angle iron, baffle plates and mist extractor. The angle iron is an inlet device which is mainly used as deflector. Here the primary separation of the liquid and gas takes place. The baffle arrangements over the settling section eliminates agitation of the separated liquid. This greatly reduces changes of foaming and the possibility of revaporizing any of the liquid into the gas phase.

Liquid droplets that will not settle out of the gas stream due to little or no gravity difference between them and the gas phase, will be entrained and carried out of the Slug Catcher with the gas. This is the reason why a mist extractor has been installed near the gas outlet. Small liquid droplets will coalesce and collect and form larger droplets which will by gravity be drained back into the liquid phase. Thereby the liquid carry over in the gas phase is limited to complete removal of liquid droplets entrainment in the 20 micron range.

The overhead gas is sent to the ODIN Metering Scrubber CV 201, which will later become the compression outlet scrubber if ODIN gas compression is required (ref. chapter 1.4.1).

The purpose of this scrubber is to make sure that the gas is maintained in single phase at the metering station.

This vessel will therefore prevent residual water and condensate carry over in the downstream gas line. In addition the scrubber is provided with a wire mesh located at the gas outlet. The liquid content in the gas is thereby reduced such that 95% of the droplets will not exceed 10 micron at the outlet of the vessel.

The gas is further sent to the metering station which is located upstream the flow control valves. Here the gas line is split into two separate lines:

- One going to compression module A or C while
- other is going to compression module B or C.

In order to have a good flow control rangeability, the flow control valves are connected in split range for each of the lines. The normal operation condition for this station, will be one line of manual control, and one line on either pressure or flow control. One thereby obtain a constant pressure for the metering tubes which is important for the metering accuracy. This set up is in conformity with the existing facilities on FRIGG TCP-2 platform.

During normal operation conditions the set point for the flow control valves are such that the flow is equally distributed in the two parallel lines. The reason for this is to have an even distribution of the flow to the main FRIGG compressors 11K01 A/B/C. Normal operating conditions corresponds to compressors 11K01 A/S working, while 11K01 C is used as stand-by.

It may happen, however, that only one of the metering tubes is used, i.e. in case of maintenance, calibration etc. Then the total flow will have to go through just one of the tubes, which means that they will have to be designed for a flow rate of 10.2 MSCM/D, which is equal to the average daily production rate.

The liquid hydrocarbons and the methanloated water which is separated from the gas in vessels CV 1A and CV 201, are sent under level control to the condensate separation system (ref. chapter 1.4.2.3). This corresponds to normal operation conditions. In addition the vessel CV 1A is provided with an automatic flush valve (LCV V 1A.5), which will open if the liquid level increases to a high level as could be in the case if liquid slug enters the vessel (ref. chapter 1.4.2.10).

Equipment Design Data

CV 1A ODIN Slug Catcher

Design pressure	177.5 bara
Design temperature	50°C/ -28°C
Capacity	11.2 MSCM/D
Dimensions	2388 ID x 9144 T/T

CV 201 ODIN Metering Scrubber

Design pressure	177.5 bara
Design temperature	65°C/ -28°C Note 1
Capacity	11.2 MSCM/D

ODIN gas composition, reservoir pressure and production flow rates are given in Appendix 2.

NOTE 1:

The reason why CV 211 has a design temperature of +65°C and not +50°C, is because the vessel will become the compression outlet scrubber if ODIN gas compression is required. This the vessel will be part of the future gas compression treatment and must therefore follow the design conditions given for future compression.

1.4.2.3 Condensate Separation (Ref. drawing FF 88 00 11 5032 - Appendix 3)

The condensate separation system consists of two independent treatment streams, one for NEF and one for ODIN. The treatment is, however, identical for the two streams.

The liquid effluent from vessel CV1A and CV 201 - having passed through level control valves LCV V1A.1 and LCV V201.1 respectively - feeds the heat exchanger CE 203 at a weight flowrate equal to 3382 kh/hr. In the same manner the liquid effluent from vessel CV 210 and CV 211 - having passed through level control valves LCV V210.1 and LCV V211.1 respectively - feeds the heat exchanger CE 211 at a weight flowrate equal to 2177 kg/hr.

CE 203 is the Condensate Heater for the ODIN stream and CE 211 is the Condensate Heater for the NEF stream. Here the liquid - which is a mixture of condensate and methanolated water - is heated up from 2°C to 20°C at 20 bara. Triethylene glycol (TEG) solution is used as heating medium (ref. chapter 1.4.2.5).

The condensate heaters are shell and tube heat exchanger, where condensate and methanolated water are going on the tube side and TEG on the shell side. The reason for the heaters, is to speed up the rate of separation between the gas and liquid in the three phase separators downstream the heat exchangers.

The ODIN liquid stream is further sent to Condensate/Methanol Separator CV 204, and the NEF stream is sent to Condensate/Methanol Separator CV 213, operating at 20°C and 20 bara. The hydrocarbon condensate and the methanolated water are separated. The effluent gas which is produced due to the pressure drop across level control valves LCV V1A.1 and LCV V 210.1 respectively, is sent to the LP vent system under pressure control (ref. chapter 1.4.2.8).

The vessels are provided with wire mesh at the gas outlet to remove liquid droplets in the 20 micron range.

The condensate is sent under level control to the existing vessels CV 3 or V 3 after being metered, before it is injected into the main FRIGG gas, transportation system. Total flow of condensate equals 4.2 m³/hr. The metering device is located just upstream the level control valves LCV V 204.4/LCV 213.4

Since the condensate from ODIN/NEF fields is being mixed with that from the existing production facilities, it will be necessary to provide acceptably accurate metering systems on the condensate outlet lines from CV 204 and CV 213, so that the condensate production of each field can be determined. The accuracy of these systems must be at least equal to that of the existing systems installed on TCP-2. This is necessary because the condensate production from the Frigg Field will be determined by subtracting the ODIN and NEF quantities from the total flow injected into the pipe line.

Each condensate stream will consist of three meters. Two of these will be installed such that the flow may be passed through either meter. The third meter will be installed down stream of these two meters. Each meter will be installed with isolating block valves and drain/bleed valves to enable a meter to be removed without a complete shut down. The series meter will be fit with a bypass loop to enable it to be removed for servicing or checking.

The methanolated water from vessel CV 204 and CV 213 - which is located at a lower level than the condensate due to the difference in specific gravity - ties into one common line and is sent to the methanolated water system (ref. chapter 1.4.2.4).

Fuel gas injection is provided as blanketing gas in order to prevent a pressure decrease in the vessels (ref. chapter 1.4.2.9.1).

Equipment Design Conditions

CE 203 ODIN Condensate Heater

Shell side	Design pressure	25 bara
	Design temperature	107°C
Tube side	Design pressure	177.5 bara
	Design temperature	107°C

CE 211 NEF Condensate Heater

Shell side	Design pressure	25 bara
	Design temperature	107°C
Tube side	Design pressure	177.5 bara
	Design temperature	107°C

CV 204 ODIN Condensate / Methanol Separator

Design pressure	25 bara
Design temperature	50°C
Capacity	3.1 m ³
Dimensions	1000 ID x 4000 T/T

CV 213 NEF Condensate / Methanol Separator

Identical to vessel CV 204

1.4.2.4. Methanolated Water System (Ref. drawings FF 88 00 10 5033
FF 83 00 54 5101
FF 88 00 00 5034 -
Appendix 3)

The methanolated water disposal system is common to NEF and ODIN. This methanolated water which has been separated from the condensate in vessels CV 204/CV 213, is sent to the Methanolated Water Flash Drum CV 220 which operates at 10 bara and 20°C.

The actual liquid flowrate corresponds to 2.2 m³/hr. The flash gas which is created due to the pressure decrease, goes to the LP vent system under pressure control. A wire mesh is installed at the gas outlet to remove liquid droplets in the 20 micron range. Fuel gas is used as blanketing gas in case of a pressure decrease in the vessel.

The methanolated water which contains about 14 litres of liquid condensate per hour, is skimmed in vessel CV 220. The flash drum is divided into two independent chambers, one for the methanolated water and one for the condensate. The condensate which has the lowest specific gravity will be located above the methanolated water phase and flows to the condensate part of the vessel. The liquid hydrocarbon is further sent by a level control valve to the oil skimmer CV 5, which is part of the existing condensate recovery system.

The methanolated water is flowing under level control from vessel CV 220 to DP-2 in a 4" existing sea line. A metering device is located just upstream the LCV V 220.1 on TCP-2 platform. The liquid enters the DP-2 platform at 4 bara and passes through a 10 micron filter bag before it is injected into well No. 22.

Just downstream these filters (FA 106 A/B) a pressure control valve PCV 260 is installed. This valve controls the backpressure in the system, and protects the upstream pipeline and sealine from having vacuum conditions due to siphoning in the downflow piping. Downstream the pressure control valve, the minimum pressure could be equal to the vapour pressure of methanolated water at 5°C which is 0.008 bara.

This pressure could also exist in the filters if the well is not shut off when the injection is stopped. The filters have, however, been designed for this minimum pressure.

In addition to the above mentioned protections, a pressure switch PSL M 9.3 is installed on TCP-2. This switch will close valve ESDV M 9.2 on TCP-2 and ROV 223 on DP-2, thereby isolating the sea line upon low pressure in this line (i.e. in case of a rupture in the sea line).

If the injection well is closed, in case of work over, shut down etc., the ESDV M 9.2 will be closed and the liquid is sent to the CV 9 Methanolated Water Storage Tank. This tank has earlier been used as a triethylene glycol (TEG) storage tank, but the connections with the glycol facilities will be obsolete and disconnected.

The capacity of the storage tank, which is 100 m^3 , is suitable for approx. 45 hours production at normal flowrate ($2.2 \text{ m}^3/\text{hr}$).

When injection into well No. 22 becomes possible, the methanolated water is pumped from CV 9 to DP-2, using Methanolated Water Injection Pumps CP 222 A/B. This line ties into the 2" line from vessel CV 220 downstream the metering device FQ V 220.1 A/B.

Inhibitor injection into the methanolated water line going to DP-2 is possible using Inhibitor Pumps CP 225 A/B. These pumps take suction from Inhibitor Drums CV 225 A/B which are operating at atmospheric conditions. The inhibitor is injected upstream the ESDV M 9.2.

Equipment Design Conditions

CV 220 Methanolated Water Flash Drum

Design pressure	16.2 bara
Design temperature	50°C
Capacity	3.05 M^3
Dimensions	900 ID x 2900 T/T

1.4.2.5 Triethylene Glycol (TEG) System (Ref. drawing FF 88 00 00 5034 - Appendix 3)

Hot TEG loop will be used to increase the temperature of the condensate and methanolated water from 2°C to 20°C. The hot glycol is pumped through TEG Circulation Pumps CP 220 A/B/C. These pumps takes suction from Glycol Surge Tanks CV 17 A, B or C, which are existing vessels operating at 2.0 bara, and the glycol is returned back to the same vessel. The reason for this is to have control with the liquid level in the tank, thus preventing it from being overfilled. In addition a level switch is installed which will give an alarm in the control room, upon high liquid level in the vessel.

During normal operating conditions, the glycol inlet temperature to CV 17 from the reboiler section is 80°C. The surge drum that is heating condensate and methanolated water, will however have an equilibrium tempeature of 58°C.

This hot glycol passes through the heat exchangers CE 203/CE 211 on the shell side and exchange heat with the liquid which is on the tube side. The temperature for the TEG solution decreases from 58°C to 52°C, and is sent back to the surge tank CV 17.

As vessel CV 9 will be used as methanolated water storage tank (ref. chapter 1.4.2.4), it will not be possible to send TEG from CV 9 to CV 17 A/B/C using the glycol fill header. This function is achieved using Glycol Fill Pumps P 13 A/B which takes suction from Glycol Storage Tank V 9 located on TP-1.

If it is required to empty any of the glycol surge drums (in case of accident, work-over, etc.) the vessel will be drained using Glycol Fill Pumps CP 13 A/B. The load of these pumps are provided by the liquid height in the glycol drain header. The pumps are manually stopped according to the level in CV 17. The remaining TEG is drained by gravity to the Methanolated Water Drainage Tank CV 222.

Equipment Design Conditions

CP 220 A/B/C TEG Circulation Pumps

Design pressure 25 bara
Design temperature 107°C

CP 13 A/B Glycol Fill Pumps

Design 113.6 l/min. at 3.08 bara

CV 17 A/B/C Glycol Surge Tank

Design pressure	3.05 bara
Design temperature	107.2°C
Capacity	21.6 m ³
Dimensions	1980 ID x 6400 T/T

1.4.2.6 Methanol Injection System (Ref. drawing FF 88 00 09 5036 - Appendix 3)

1.4.2.6.1 General

Methanol injection is provided in the ODIN and NEF field streams at the wellhead exit to prevent hydrate formation in the sea lines.

The gas which is separated from the condensate and methanolated water in vessels CV 1A and CV 210, is not any longer in contact with liquid methanol. A small amount of water condensation could therefore initiate formation of hydrates. In order to prevent such a risk, provisions are made for future methanol injection into the gas stream at the outlet of the slug catcher.

1.4.2.6.2 Injection to the Articulated Column on Field Control Station (FCS) for NEF Field.

The methanol stored in Methanol Storage Tank CV 23 - which is an existing tank operating at atmospheric conditions - is sent to NEF articulated platform through a 1 1/2" line using Methanol Injection Pumps CV 12 A/B (already existing). The pump flow rate is manually adjusted according to the needs from the FCS located on NEF.

The flowrate will vary within the following limits:

	<u>Flow rate</u> <u>litres/hr.</u>	<u>m³/day</u>	<u>Discharge pressure</u> <u>bara</u>
Mini	8	2.0	-
Normal	275	6.6	7
Max	1000	24.0	22

The capacity of the storage tank CV 23 - which is 100 m³ - is suitable for 15 days of production at normal flow conditions.

The maximum flow rate, used only for special conditions and during short periods could be provided by the two pumps working in parallel.

1.4.2.6.3 Injection Downstream ODIN and NEF Slug Catchers

Two reciprocating pumps CP 223 A/B - Methanol Injection Pumps - can be used to inject methanol in gas lines downstream the Slug Catchers CV 1A/CV 210. These pumps will also take suction from CV 23. This package will be provided later if necessary. Necessary piping stubs are provided for future connections.

Equipment Design Conditions

CV 23 Methanol Storage Tank

Design pressure 1.35 bara at 21°C
Capacity 100 M³
Dimensions 7300 L x 3550 W x 4000 H

CP 12 A/B Methanol Injection Pumps

0-10³ l/hr at 153 bars ΔP

CP 223 Methanol Injection Pumps

Design pressure 177.5 bara
Design temperature 21°C.

1.4.2.7 Process Drainage System (Ref. drawing FF 88 00 10 5100 - Appendix 3)

The drainage of the pressure vessels (NEF and ODIN gas treatment) is connected to the existing process drainage on TCP-2.

A methanolated water drainage system is added to drain all low pressure vessels containing methanolated water, i.e. CV 220 - Methanolated Water Flash Drum, CV 204 and CV 213 - Condensate/Methanol Separator. Also the glycol drain header at the suction of the pumps CP 13 A/B - Glycol Fill Pumps - is connected to this system (ref. chapter 1.4.2.5). The drains are gathered into a header going to the Methanolated Water Drainage Tank CV 222. The drainage volume of this tank equals 3.05 m³.

A drainage Tank Pump CP 224, is located on the top of the drainage tank. If a high methanolated water level is reached in CV 222, a high level switch LSH V 222.2 will start the pump automatically. This pump discharges into vessel CV 220. In the same manner the pump will be stopped by low level switch LSL V 222.1. In addition the pump can be started and stopped manually.

If the level in the drainage tank should increase to a very high level, the level switch LSHH V 222.3 will give an alarm in the control room for the operator to take the necessary steps to prevent the drainage tank from being overfilled.

The pumping design capacity is equal to 3 m³/hr. The time required to empty the vessel (i.e. going from high to low liquid level) will be in the order of 1 hour.

As the volume of vessel CV 220 is equal to the volume of the drainage tank, the following protection has been made to prevent the flash drum from being overfilled: A level switch LSH V 220.6 will automatically stop the pump CP 224, if the level in vessel CV 220 increases to a very high level.

Equipment Design Conditions

CV 222	Methanolated Water Drainage Tank
Design pressure	3 bara
Design temperature	50°C
Capacity	3.05 M ³
Dimensions	800 ID x 6000 T/T
CP 224	Drainage Tank Pump
Design pressure	16 bara
Design temperature	50°C.

1.4.2.8 Flare System (Ref. drawing FF 88 00 04 5090 - Appendix 3)

1.4.2.8.1 General

The flare system for NEF and ODIN consists of:

- Low pressure relief system (LP system)
- High pressure relief system (HP system)
- Low temperature relief system (LT system)

The temperature downstream of the blowdown valves can be as low as -75°C with an initial upstream temperature of 5°C. Consequently a new flare system is required which can tolerate very low temperatures.

1.4.2.8.2 LP System

The gas release to this system originates from pressure safety valves or breather control valves on equipment containing low pressure process gas or liquid i.e. from:

CV 204 - ODIN Condensate/Methanol Separator
CV 220 - Methanolated Water Flash Drum
CV 213 - NEF Condensate/Methanol Separator
Density Transmitter - Gas Metering.

Maximum relief rate is 0.348 MSCM/D, which corresponds to fire exposure on Pancake 53. The existing LP vent system, having the following design conditions:

max gas relief - 0.503 MSCM/D
design relief - 1.30 MSCM/D

will have sufficient capacity to handle the relief flow rates from low pressure vessels for TCP-2 Extension.

The vents from the above equipment tie into a 10" header which is connected to the existing header C 446 EA 14" V going to LP Vent Scrubber CV 7. Here the liquid phase is sent - via effluent water treatment unit - to the sump caisson under level control and the gas phase is released to the LP vent stack.

1.4.2.8.3 HP System

The gas release to this system originates from fire safety valves on CV 1A - ODIN Slug Catcher, and from depressurization of NEF sea line (ref. chapter 1.4.2.10.2).

The system is existing. The high pressure gases from TCP-2 which have to be flared are collected in the HP headers and sent to CV 24 - HP Relief Scrubber.

The liquid phase is sent - via effluent water treatment unit - to the sump caisson under level control. The gas is sent to the articulated flare.

1.4.2.8.4 LT System

The emergency release to this system originate from:

- Blow down valves on equipment containing high pressure process gas
- Fire safety valves on equipment containing high pressure process gas (except CV 1A)
- Depressurization of ODIN and NEF sea lines.

The flare gas from the different equipment and lines are collected in a 10" header feeding CV 226 LT Relief Scrubber located in Pancake 53. The maximum relief rate is 2.8 MSCM/D, which corresponds to depressurization of the sea lines. Any liquid that may be collected in the Scrubber, is sent under level control to the process drainage system (ref. chapter 1.4.2.7).

The gas evacuates in a 12" line and ties into the existing compression LP vent stack located in Module 33. The capacity in this stack is sufficient to handle the maximum relief rates for the LT Relief System (3.8 MSCM/D and 2.8 MSCM/D respectively).

Equipment Design Conditions

CV 7 LP Vent Scrubber

Design pressure	4.46 bara
Design temperature	100°C
Capacity	1.3 MSCM/D
Dimensions	1829 ID x 2483 T/T

CV 24 HP Relief Scrubber - TCP-2

Design pressure	59.3 bara
Design temperature	-55°C
Capacity	34 MSCM/D
Dimensions	1662 ID x 4050 T/T

CV 226 LT Relief Scrubber

Design pressure	14.2 bara
Design temperature	-75°C/100°C
Capacity	2.8 MSCM/D
Dimensions	1500 ID x 3600 T/T

1.4.2.9 Fuel Gas System (Ref. drawing FF 88 00 02 5040 - Appendix 3)

1.4.2.9.1 Fuel Gas for Blanketing

Fuel gas used as blanketing gas in case of vessel pressure decrease, is provided for the following equipment:

CV 204 - ODIN Condensate/Methanolated Water Separator
CV 213 - NEF Condensate/Methanolated Water Separator
CV 220 - Methanolated Water Flash Drum.

The fuel gas is taken from the existing fuel gas supply header C 867 EA 4" FG; which comes from the glycol contactors outlet. This fuel gas is treated in the existing cold fraction unit in order to obtain the required dew point. Then it is sent to the CV 17 glycol surge tank, where it is heated up from -25°C to 50°C.

1.4.2.9.2 Fuel Gas Used AS Start Up Gas

The ODIN sea line pressurization will be performed from the ODIN field production platform by progressive opening of one or two choke-valves.

This process cannot be used to pressurize NEF sea line because of the submarine wells which imply that the choke valves have to be located on TCP-2.

A high pressure start up gas line is provided for this purpose.

This gas is taken from the existing fuel gas supply heater C852-EF3"FG (which comes from glycol contactors outlet).

1.4.2.10 Upset Operating Conditions

1.4.2.10.1 Slug Formation

A slug disposal system is provided to handle any slug that enters the TCP-2 platform through the ODIN and NEF sea lines. The Slug Catchers CV 1A/CV 210 level controller is operating with a minimum condensate inventory in order to have a maximum slug receiving capacity.

When a liquid slug enters the slug catchers the liquid level will start increase. Upon high level in the vessels an automatic flush valve LCV V1A.5/LCV V 210.5 will open and send condensate to the condensate slops header which is feeding the existing vessel CV3 operating at 15 bara and 30°C.

The total slug receiving capacity is 31 m³ for ODIN and 43 m³ for NEF.

If the liquid level is further increased the slug catchers are provided with very high level switches (LSHH V1A.8 and LSHH V210.8 respectively), which will close the inlets to vessels thus preventing them from being overfilled.

1.4.2.10.2 Depressurization

High pressure process equipment located in Module 50, is sectionalized by means of ESD valves. In case of an emergency (fire etc.) these valves can be closed upon signal from the control room.

After isolation of the various sections, it is possible to depressurize manually one section (local action on the valve or the whole gas treatment plant (level 2 shut down from QP Central Control Room). Such blowdown valves are installed on the slug catchers CV 1A and CV 210, on the scrubbers CV 201 and CV 211 and on the feed lines upstream the slug catchers.

Total blowdown rate is equal to 1.874 MSCM/D, which is below the design capacity of the LT relief system (3.8 MSCM/D). By depressurizing in this way, one thereby reduces the pressure by removal of gases from high pressure vessels, which elsewhere would be weakened by excessive heating when exposed to fire.

NEF Sea Line Depressurization (Ref. P & ID FF 88 00 00 5031 - Appendix 3)

The NEF sea line blowdown is performed using both the LT relief system and the HP relief system. During the initial blowdown period, i.e. when the pressure in the sea line is greater than 100 bara, the gas will have to be released through the LT relief system. The reason for this is the low temperature of the gas downstream the blowdown valve due to the great pressure drop across the valve. (Temperature down to -75°C can be reached when the gas is depressurized from 160 bara and down to near atmospheric pressure.

In this stage depressurization valve FCV M 210.1 and the manual operated isolation valve HV M 210.3 will be open, while depressurization valve FCV M 210.2 and the manual operated isolation valve HV M 210.4 will be closed. The gas will then pass through to the LT relief system and is further vented to atmosphere in the existing cold vent stack.

A flow switch located at the outlet of the LT relief scrubber CV 226, will prevent the flow rate in the system from exceeding the design flow which is 2.8 MSCM/D.

As the pressure in the sea line decreases to below 100 bara, the temperature downstream of the blowdown valves is such that it is possible to tie into the HP relief system. This is done by opening the depressurization valve FCV M 210.2 and isolation valve HV M 210.4, while the corresponding valves for the LT relief system will be closing. The gas then passes through to the HP relief system and ties into the existing 24" relief header just upstream vessel CV 24 - HP Relief Scrubber.

A temperature switch (TSL M 210.2) and a pressure switch (PS M 210.5) will protect the HP relief system in such a way that it is not possible to change from LT relief to HP relief before the temperature and the pressure are satisfactory (i.e. the pressure upstream of depressurization valves should be equal or lower than 100 bara and the temperature downstream of the isolating valve HV M 210.4 should be equal or higher than -46°C).

The advantage of depressurizing in this way, is that the gas will be flared instead of vented and that the blowdown flow rate can be increased due to the design conditions for the HP relief system (HP relief system is designed for a flaring flow rate equal to 34 MSCM/D).

When the HP relief system is used for depressurization of NEF sea line, the max. flow rate equals 8.4 MSCM/D.

The reason for the value 8.4 MSCM/D is due to limitations on the criteria of flare pipe sizing, which is:

$$\rho v^2 \leq 100\,000 \text{ kgm/s}^2$$

and gas Velocity ≤ 0.45 Mach

A differential pressure transmitter PDT M 210.1 and a differential pressure recorder PDR M 210.1 gives the flaring flow rate.

Initial conditions:

System	:	LT relief
Pressure	:	160 - 100 bara
Flow rate	:	2.8 MSCM/D (at 160 bara)

Final conditions:

System	:	HP relief
Pressure	:	100 bara -->

ODIN sea line depressurization (Ref. P & ID FF 88 00 00 5030 -
Appendix 3)

The ODIN sea line will be depressurized from the ODIN platform. Provisions have however been made to depressurize partially the ODIN pipeline from TCP-2 in case of plugging of the line by pigs or other unusual situations.

The blowdown is performed by opening of the choke valve CSP M 201.3. This valve has been calculated to deliver a depressurization flow rate of 2.8 MSCM/D at 160 bara.

As for the NEF blowdown line, the flaring flowrate is measured using a PD-transmitter and a PD-recorder. PDT M 201.1/PDR M 201.1.

1.5 DESCRIPTION OF PROCESS SAFETY SYSTEMS

1.5.1 General Description of Process Safety Systems

All vessels, heat exchangers, pumps and the following lines:

- Incoming sealines from NEF/ODIN fields
- Methanol injection line to NEF articulated column
- Methanolated water well injection to DP-2

are protected against undesirable events as described in API Recommended Practice 14C.

For analysis of the process safety systems, references are made to the following documents:

CH-FF 88 00 00 4142 - Safety Analysis Table (SAT)
TCP-2 Extension. (Appendix 4)

CH-FF 88 16 00 4143 - TCP-2 Extension - Safety Analysis
Function Evaluation Chart Gas and
Liquid Treatment. (Appendix 5)

It should be noted that the only exception from API RP 14C, is the fuel gas system. Fuel gas will be used as blanketing gas for vessels CV 204, CV 213 and CV 220 to prevent a pressure decrease. These vessels are protected against leakage by PSL sensors that will shut off incoming feed line, which is a mixture of gas, condensate and methanolated water. The fuel gas inlet to the vessels will however not be shut off by this PSL. The reason for this is that the fuel gas system is protected in the following way:

i) In case of very large leakage:

- 1) Primary protection - Gas detectors will initiate a 3rd level shutdown which will stop fuel gas supply.
- 2) Secondary protection - The pressure will fall in existing vessel CV 6 - Fuel Gas Scrubber and PSL V6.9 will close fuel gas supply.

ii) In case of small leakage:

- 1) Primary protection - As above.
- 2) Secondary protection - A PSL sensor actuator and ESDV valve closing the fuel gas supply would be inactive. This is because the fuel gas will try to balance the leakage in order to prevent the pressure from decreasing.

For a functional description of the ESD system ref. is made to document No.: S-FF 88 16 08 9520 attached in Appendix 6. For a description of the process safety system, ref. is made to document No.: S-FF 88 16 08 9521 attached in Appendix 7.

1.5.2 Fire Protection

1.5.2.1 Introduction

All vessels are protected against fire exposure by pressure safety valves.

The calculation assumptions are in accordance with API RP 520 and API RP 521.

1.5.3 Protection Against Process Over Pressure

1.5.3.1 Protection for High Pressure Gas Vessels CV 1A, CV 210, CV 201 and CV 211.

No protection for blocked lines is required for NEF Slug Catcher and Metering Scrubbers.

The reason is that the MAWP, which is 177.5 bara, is higher than the maximum static well head pressure.

For the ODIN Slug Catcher, protection against over pressure will be provided in accordance with the final rerating on CV 1A.

1.5.3.2 ODIN Condensate Lines Downstream the ESDV V1A.2 and ESDV V201.3

During normal operating conditions, the pressure in these lines will be 20 bara. In case of high process pressure downstream these ESD valves, the primary protection is the PSH V 204.5. This PSH will close the valves ESDV V1A.2 and ESDV V201.3.

The secondary protection is the PSV V204.1 or PSV V204.2 with a set pressure of 25 bara. These protections are located on the Condensate/Methanol Separator CV 204.

The over pressure sizing case is caused by an uncontrolled flow from the condensate line. The flow rate is calculated based upon full opening of the manual globe valve which bypasses the level control valve LCV V1A.1.

The upstream liquid is supposed to be condensate without methanolated water and the valve calculation gives a volumetric flow rate of 186.1 USGPM or 42.3 m³/hr. This corresponds to a mass flow rate of 2870 kg/hr.

This fluid enters vessel CV 204, where the vapour released is evacuated through PSV V204.1/2, and further sent to LP Vent Scrubber CV 7 which is an existing equipment.

The PSV valves have been sized for max. release, which is in case of fire.

1.5.3.3 NEF Condensate Lines Downstream the ESDV V210.2 and ESDV V211.3

The preceding description for the ODIN safety protection against over pressure applies to NEF liquid treatment. The assumptions are the same, but the instrument tag numbers are to be changed to:

ESDV V210.2
ESDV V211.3
PSH V213.5
PSV V213.1
PSV V213.2
LCV V210.1

1.5.3.4 Protection of Methanolated Water System

Protection of Vessel CV 220 - Methanolated Water Flash Drum

At normal conditions, the operating pressure in the vessel is equal to 10 bara. If the pressure by accident increases (as could happen in case of blocked outlet from the vessel or an uncontrolled flow into the vessel), the primary protection is a PSH V220.3 closing the inlet to the vessel. The secondary protection is the PSV V220.1/2 having a set pressure equal to 16.2 bara.

These PSV valves have been sized for max. release which is in case of fire.

Protection of Vessel CV 222 - Methanolated Water Drainage Tank

This vessel is not in continuous service and will only be used for drainage of vessels CV 204, CV 213 and CV 220 (the suction of glycol pumps CP 13 A/B also ties into this system).

The vessel is protected against process over pressure by a vent going to atmosphere. The drainage tank is

Methanolated Water Storage Tank CV 9

The CV 9 - Methanolated water storage tank which is designed at 1.35 bara, was previously used as a glycol storage tank. The protection of this vessel has been modified to take into account the function as methanolated water storage.

This safety protection will be identical to the existing vessel CV 33.

This includes:

- PSV V 9.3 - Emergency vent and manhole to relieve internal pressure of the vessel.
- PSV V 9.2 A/B - Pressure and vacuum breather valves to relieve internal pressure and vacuum of the vessel during filling or emptying.

1.5.4 Thermal Expansion in CE 203/CE 211

The condensate / methanolated water is heated using the exchangers CE 203/CE 211. At normal conditions the temperature at the outlet of the heaters will be 20°C.

If the temperature of the fluid is increased to a certain value (the value to be defined later), a temperature switch (TSH E 203.5 and TSH E 211.5) will shut off the heating medium which is the TEG solution. These switches are located just downstream the heaters.

Such an excess heat input could happen if the condensate/ methanolated water is allowed to stay within the pipe without being withdrawn. Any pressure built up in the system because of vapour released due to heating, will be evacuated through the pressure control valves PCV V204.2 for the ODIN separator and PCV V213.2 for the NEF separator.

These valves are connected to the LP vent system.

1.5.5 Protection on Shell Side of Condensate Heaters, TEG Lines and Glycol Surge Drums CV 17 A/B/C.

The design pressure on the shell side of the condensate heaters CV 203/CE 211 is 25 bara. The tube side of these heaters are protected by a PSH and two PSVs set at 25 bara, located at downstream components CV 204 and CV 213.

In case of tube side failure, the three phases condensate, gas and methanolated water will leak into the shell side, because the operating pressure is lower than on the tube side (5 bara and 20 bara respectively). From the shell, the fluid enters the glycol piping, which is designed at 25 bara.

The glycol return line will be used as relief system. The condensate, gas and methanolated water are sent to existing vessels CV 17 A/B/C. The gas is evacuated through a 2" existing breather line which leads to the LP vent system. The glycol surge drum design pressure which is 3.05 bara, will not be reached.

Since the only isolation device between the heat exchangers and the vessels are manually block valves which will be locked open, the exchanger and vessel are considered as one unit regarding safety on the process side. A PSV on the shell side of the heaters and on the glycol piping, is therefore not required. The safety protection is made by the existing vent lines C 434/435/436-EA-2"-V.

1.5.6 Pumps Discharge

All outlets of reciprocating pumps are protected by pressure safety valves.

The protection of the outlets of centrifugal pump is not necessary, since the maximum discharge pressure will not exceed the rated working pressure of the piping.

1.6 DESCRIPTION OF GAS RELIEF SYSTEM

1.6.1 General

The flare and relief system consists of:

- A low pressure vent system (LP vent system)
- A high pressure relief system (HP relief system)
- A low temperature relief system (LT relief system)

The LP vent system and the HP relief system are existing systems already installed on the Frigg Field.

For the high pressure vessels, the temperature downstream of the blow down valves can reach as low temperature as -75°C with an initial upstream temperature of 5°C .

Consequently it is necessary to connect the relief system to the low temperature system.

1.6.2 Basis of Design

1. The LP vent system, HP and LT relief system have been designed in agreement with the guidelines in:

- API Recommended Practice 14C
- API Recommended Practice 520
- API Recommended Practice 521

2. The criteria for the flare pipe sizing have been:

- a) HP and LT relief lines and headers:

$$\rho V^2 \leq 100\,000 \text{ kg/ms}^2$$

$$\text{gas velocity} \leq 0.45 \text{ Mach}$$

where

$$\rho = \text{gas density kg/m}^3$$

$$V = \text{gas velocity m/s}$$

- b) LP vent lines and headers:

to be designed for low pressure drop.

1.6.3 Description of the Relief / Vent Systems

1.6.3.1 Low Pressure Vent System

The gas release to this system originates from pressure safety valves or breather control valves on equipment containing low pressure process gas or liquid. The relief gases are collected in a 10" LP vent header. This line is connected to the existing header C 466 EA 14" V, and sent to the LP vent scrubber CV 7.

The liquid phase from this vessel flows to the process drainage system under level control, and the gas phase is released into the existing LP vent stack.


A schematic diagram of this system is given on figure 1.12.

Design Data

Maximum back pressure	:	2.6 bara
Piping class EA, flange rating	:	150 lb
CV 7 scrubber - design pressure	:	4.6 bara
- design temperature	:	100°C

Relief Rates TCP-2 Treatment

Max. continuous relief	:	0.059 MSCM/D
Max. gas relief	:	0.53 MSCM/D
Design relief flow rate	:	1.3 MSCM/D

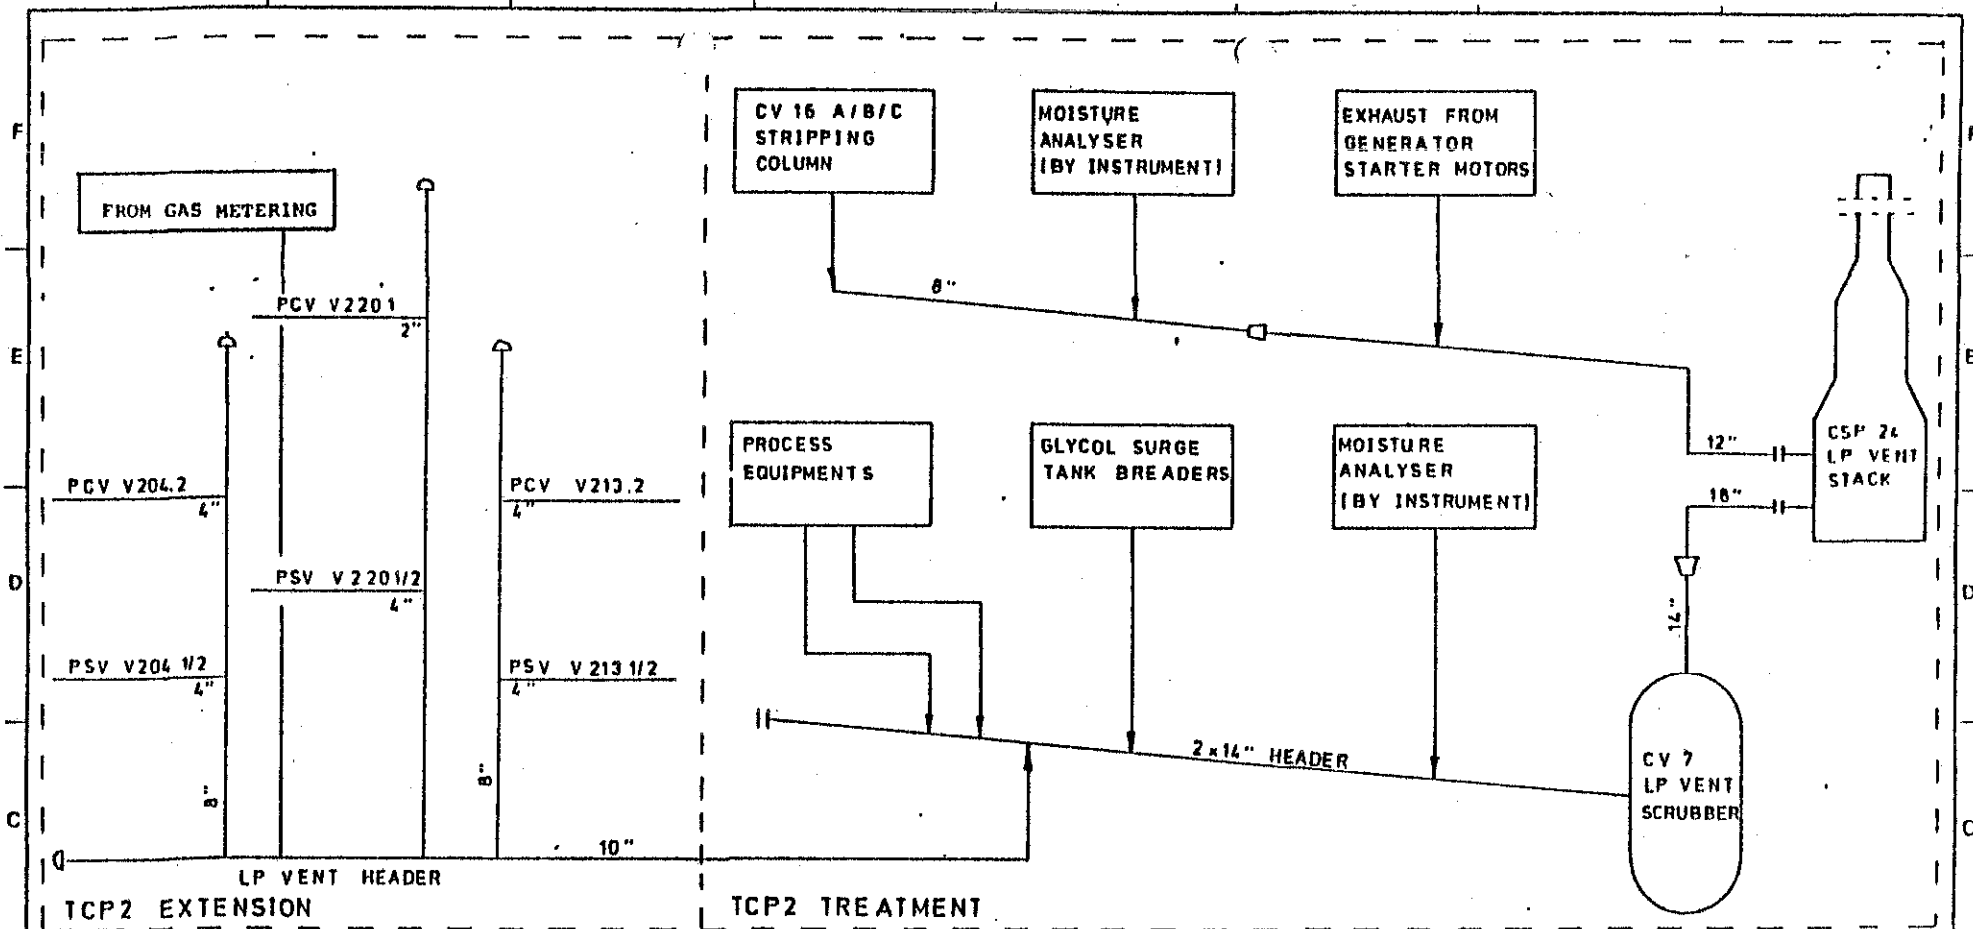

LP VENT SYSTEM SCHEMATIC DIAGRAM

FIGURE 1.12

REVNO	REVISION	DATE	BY	APPR	APPR BY CLIENT
CLIENT					
DATE	CONSTR.	APPR.	SCALE		
TITLE					
				APPR BY CLIENT	
				DATE SIGN	
				ORWG NO	

Relief Rates TCP-2 Extension (Summary)

The relief flow rates are summarized in the following table:

PRESSURE RELIEF RATES (MSCM/D) - TCP-2 EXTENSION

	FIRE EXPOSURE PANCAKE	FROM BREATHER CONTROL VALVES
		Note 1
PSV V204.1/2	0.134	
PSV V213.1/2	0.134	
PSV V220.1/2	0.080	
PCV V204.2		0.0063
PCV V213.2		0.0033
PCV V220.1		0.0010
TOTAL RELEASE	0.348	0.0106

Note 1 : Continuous flow rates.

The maximum relief rate corresponds to fire exposure on the pancake, i.e. 0.348 MSCM/D.

Reference is made to chapters 1.6.5 and 1.6.6 for detailed calculations and to Appendix 8 for back pressure calculations.

1.6.3.2 High Pressure Relief System

The gas release to this system originates from fire safety valves on ODIN Slug Catcher CV 1A, and from depressurization of NEF Sea Line (ref. chapter 1.6.4.2.2). The high pressure relief system is existing.

The gases from TCP-2 which have to be flared are collected in the HP headers and sent to the HP Relief Scrubber CV 24.

The liquid phase from CV 24 is sent via an effluent water treatment unit, to the sump caisson under level control.

Gases from CV 24 and V 24 are mixed and further sent to the articulated flare.

Design Data

TCP-2 HP Relief System:

Theoretical maximum back pressure 45 bara at PSV outlet
Piping: class ECX Flange rating: 600 lbs
 temperature: -55°C

CV 24 Scrubber:

design pressure: 59.3 bara
design temperature: -55°C

TP-1 HP Relief System:

Piping: class EC Flange rating: 300 lbs

V 24 Scrubber:

design pressure: 49.3 bara
design temperature: -50°C

Common Header to Flare:

Sea line to articulated flare: Class ECS

Design Flow Rates:

Articulated flare: 34 MSCM/D

Relief rates TCP-2 Extension:

Fire exposure on vessel CV 1A : 0.45 MSCM/D
Depressurization of NEF sea line : 8.40 MSCM/D
Maximum back pressure : 17.4 bara

Reference is made to chapters 1.6.4 and 1.6.5 for detailed calculations and Appendix 9 for back calculations.

Regarding heat radiation and dispersion calculations, vibration and noise calculations reference is made to the following documents:

Elf Aquitaine Norge A/S FRIGG FIELD
311E ENG 80/134/TEH/ej HIGH PRESSURE FLARE SYSTEM

SR 99012 INCREASING OF FLARE CAPACITY UP TO
 37 MMSCM/D

A schematic diagram of the HP flare system is shown on figure 1.13.

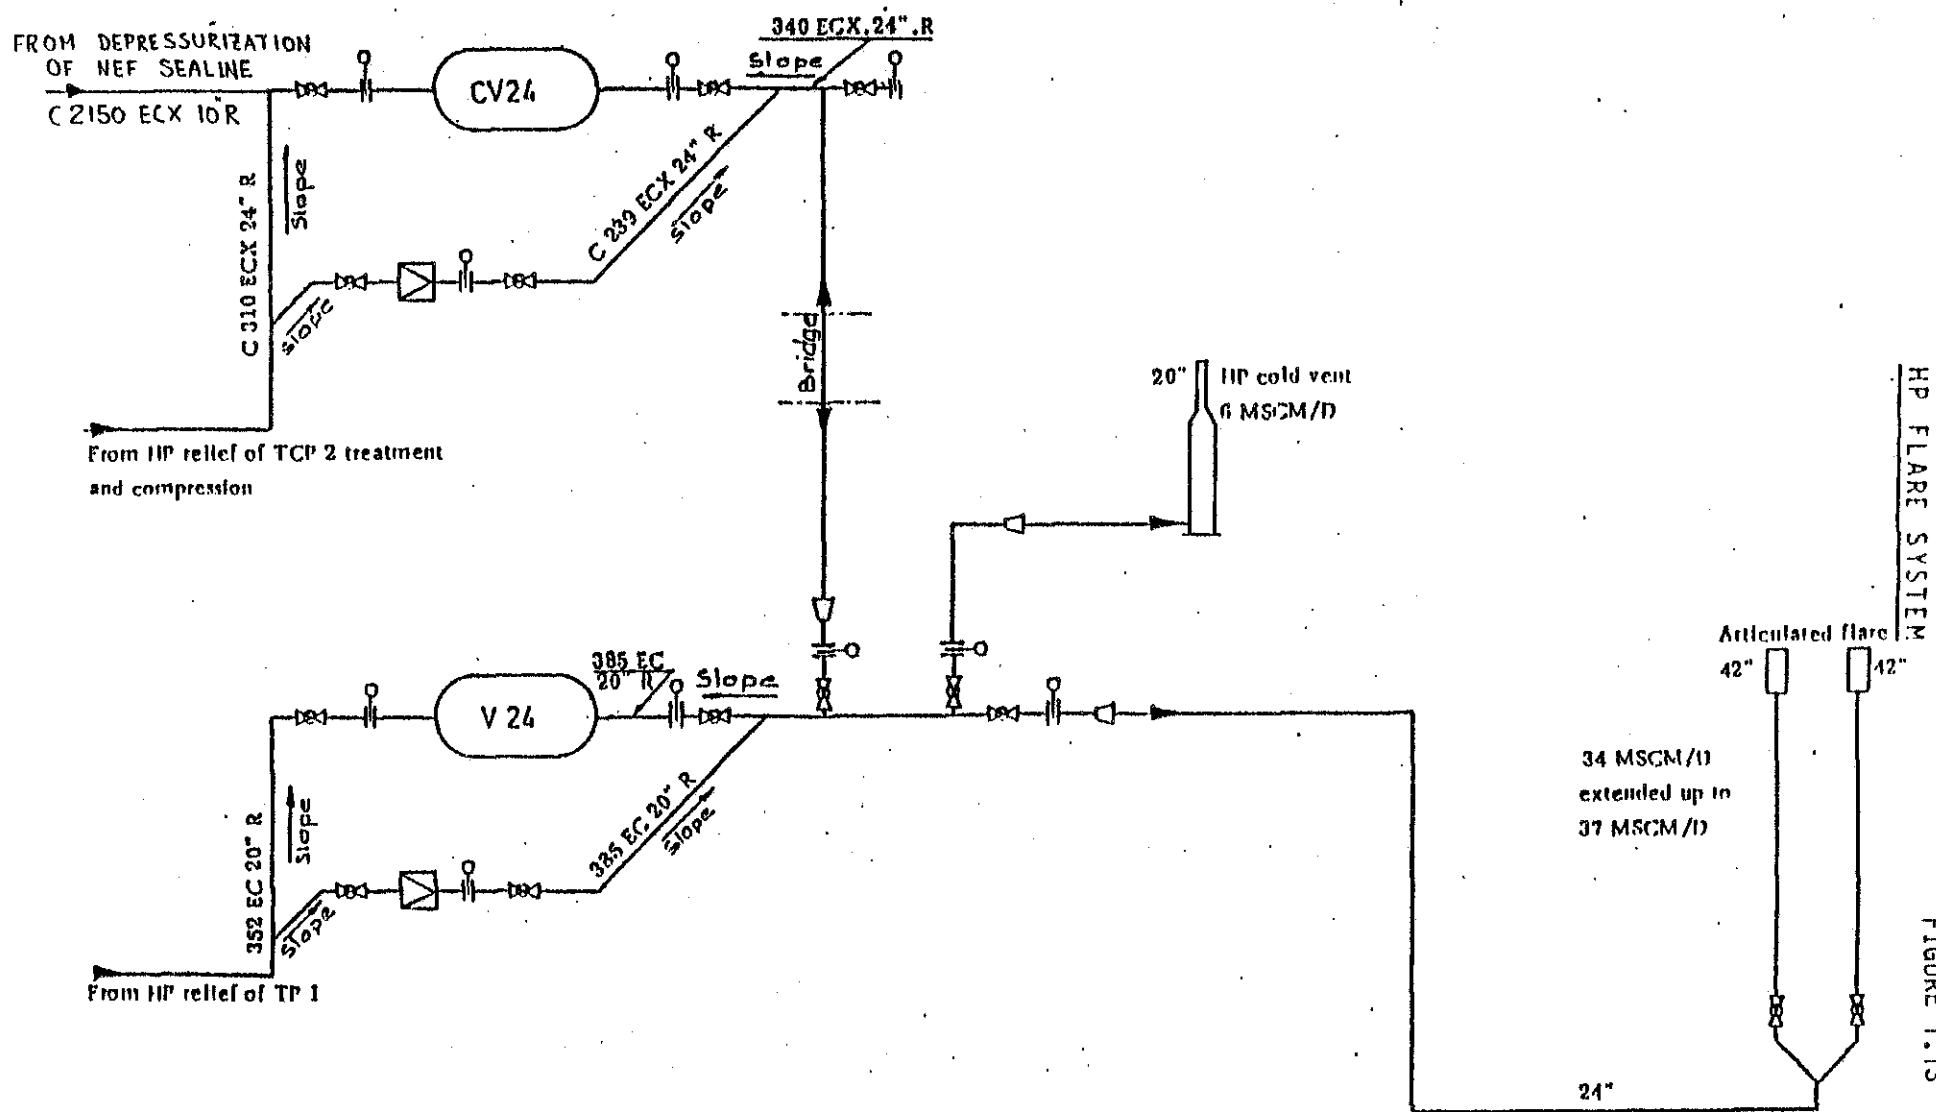


FIGURE 1.13

1.6.3.3 Low Temperature Relief System

1.6.3.3.1 System Description

The emergency releases to this system originate from:

- Blow down valves on equipment containing high pressure process gas.
- Fire safety valves on equipment containing high pressure process gas (except for vessel CV 1A).

For piping simplification it has been chosen to connect the two above systems into the same low temperature relief header.

This 10" header feeds the CV 226 scrubber located in Pancake 53. The liquid from this vessel is sent to the drainage system under level control, and the gas is released through a 12" pipeline into the existing LP vent stack for TCP-2 Compression, located in Module 33.

A schematic diagram of this system is shown on figure 1.14.

Design Data

Maximum back pressure:	5.7 bara
Piping: Class EAT Flange rating:	150 lbs
CV 226 Scrubber - design pressure :	14.2 bara
design temperature:	100°C to - 75°C

LT RELIEF SYSTEM - SCHEMATIC DIAGRAM

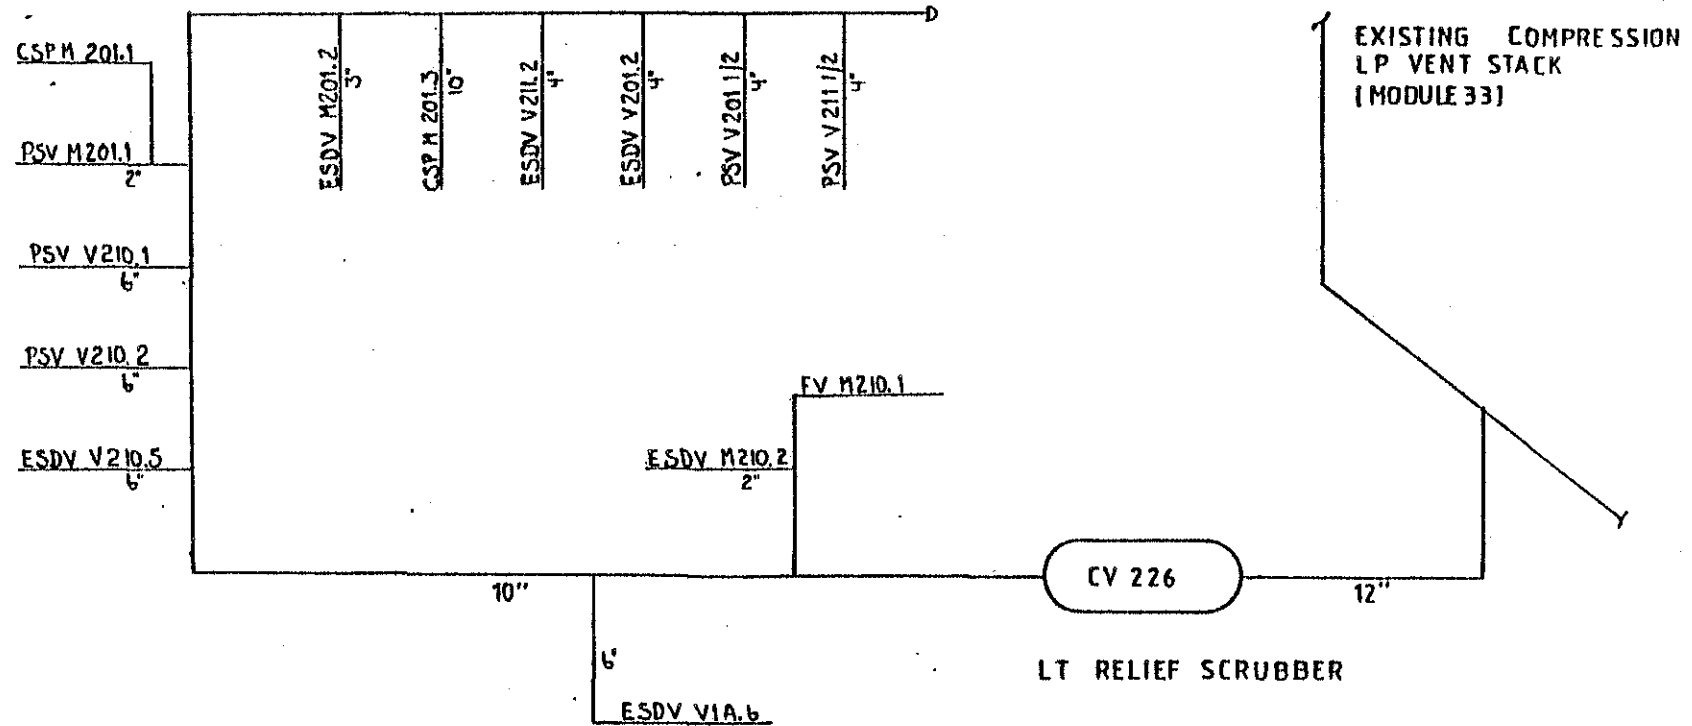



FIGURE 1.14

REVNO	REVISION	DATE	BY	APPR	APPR BY CLIENT
CLIENT					
DATE	CONSTR.	APPR.	SCALE		
TITLE				 solresid norge a.s.	
				APPR. BY CLIENT	
				DATE SIGN	
				DRWG NO	

Relief Rates (Summary)

- No continuous flow rate.
- Flaring flow rates are summarized in the following table:

PRESSURE RELIEF RATES (MSCM/D) - TCP-2 EXTENSION

	ODIN Fire Exposure	NEF Fire Exposure	Blow Down Group W	ODIN Sea Line Depressurization	NEF Sea Line Depressurization
PSV V201.1/2	.656 (1)				
PSV V210.1/2		.489			
PSV V211.1/2		.319 (1)			
PSV M201.1	.050				
ESDV M201.2			.203		
ESDV M210.2			.064		
ESDV V1A6			.546		
ESDV V201.2			.246		
ESDV V210.5			.546		
ESDV V211.2			.269		
CSP M201.3				2.8 (1)	
FV M210.1					2.8 (1)
TOTAL RELEASE	.706	.808	1.874	2.8	2.8

The maximum relief rate corresponds to depressurization of the sea lines.

Design relief rate : 2.8 MSCM/D

1.6.3.3.2 Calculation Summary


A calculation summary for the LT relief system, is shown on table 1.15. It gives the pressure, gas velocity, Mach number and ρV^2 at different locations in the system.

Reference is made to chapters 1.6.4, 1.6.5 and 1.6.6 for detailed calculations. Back pressure calculations are given in Appendix 9.

Regarding heat radiation and dispersion calculations, vibration and noise calculations, reference is made to the following document:

Elf Aquitaine Norge A/S TCP-2 Compression
311E ENG 80/407/TEH/1h RELIEF AND FLARE SYSTEM

LT SYSTEM CALCULATION

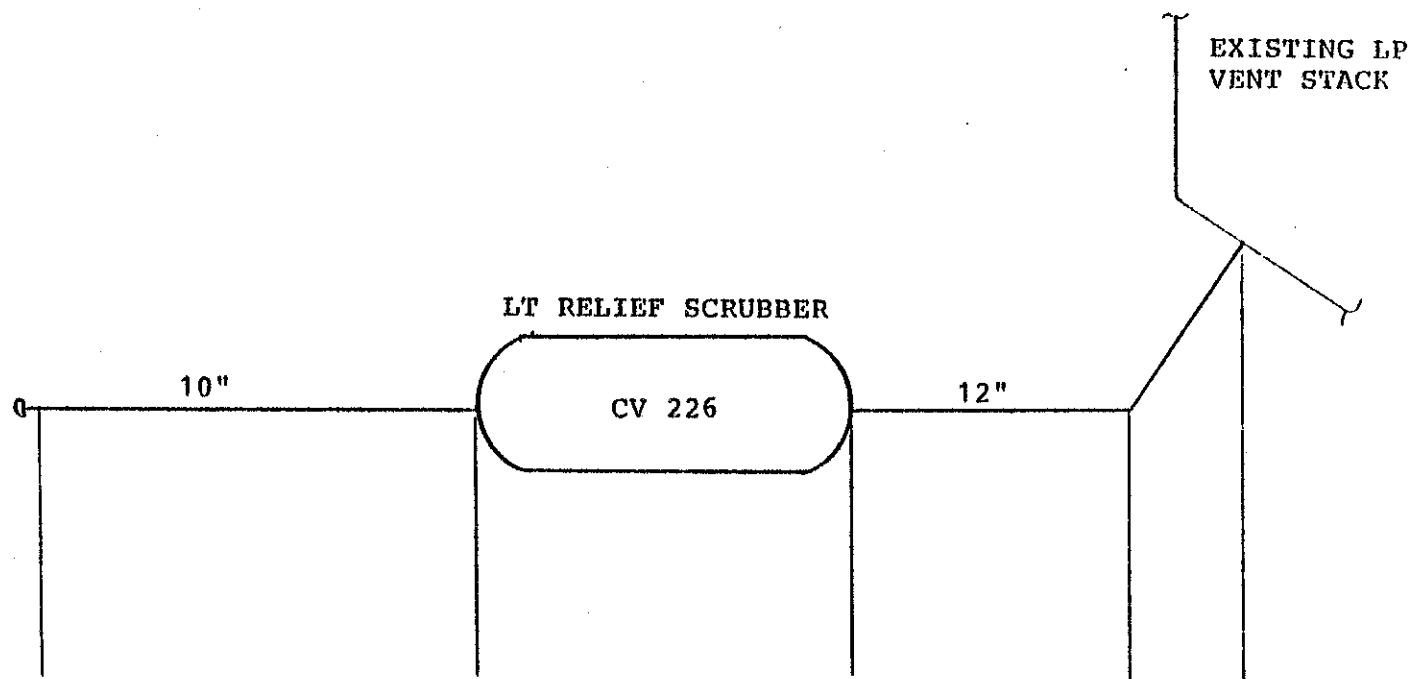

Flaring flow rate: 2.8 MSCM/D and discharge temperature - 55°C (actual need)

Pressure bara	5.23	3.3	3.07	2.0	1.373
Gas velocity, m/s	86	136	104	159	232
Mach number	0.23	0.364	0.277	0.424	0.62
ρV^2 kg/ms ²	36163	57308	30884	47023	69006

FIGURE 1.15

1.6.4 Depressurization of High Pressure Vessels, Lines and Sea Lines

1.6.4.1 Depressurization of High Pressure Vessels and Lines

1.6.4.1.1 Introduction

High pressure process equipment located in Module 50, are sectionalized by means of ESD valves.

In case of an emergency (fire etc.) these valves can be closed upon signal from the control room.

After isolation of the various sections, it is possible to depressurize manually these sections or the whole treatment plant from the control room.

By doing this, one thereby reduce the pressure by removal of gases from the high pressure vessels and lines. This equipment would elsewhere be weakened by excessive heating when exposed to fire.

All blow down valves are connected to the LT relief system.

1.6.4.1.2 Basis for Calculations

A. Blow Down Flow Rates

The calculation method is based on the fact that:

- The back pressure is low enough to ensure a critical flow rate through the blow down valves.
- The change of the temperature and the compressibility factor inside the equipment during the decompression period is not considered.

The blow down formula is:

$$W_o = P_o \frac{MW \times V}{ZRT} \frac{1}{t_f} \ln \frac{P_o}{P_f}$$

W _o :	Initial flow rate	kg/hr
P _o :	Initial pressure	160 bara
P _f :	Residual pressure	8 bara (100 psig)
t _f :	Depressurization time	hr
MW :	Molecular weight	16.9 kg/kmole
Z :	Compressibility factor	0.73 (at 160 bara 5°C)
T :	Initial vessel temperature	278°K
R :	.0831 with bara, m ³ , °K, kmole	kg
V :	System volume	m ³

B. Temperature Downstream of the Blow Down Valves

The method used to calculate the temperature downstream of the blow down valves, is based upon the guidelines given in GPSA Engineering Data Book, Section 17.

The assumptions made are as follows:

Upstream pressure 160 bara
Downstream pressure 2 bara
Upstream temperature 5°C
ODIN gas is taken as the relief composition

Calculation results are given in Appendix 10.
Here it can be concluded that the temperature downstream of the blow down valves will be -75°C.

1.6.4.1.3 Calculation Results

The valves below are connected to the ESD system and depressurize the high pressure lines and vessels.

Depressurization time (1) : 1.5 hrs (90 mins)

ITEM (1)	System Volume m ³ (2)	Initial Blow Down Flow	
		kg/hr	MSCM/D
ESDV M201.2	19	6.083	.203
ESDV V1A.6	51	16.330	.546
ESDV V201.2	23	7.364	.246
ESDV M210.2	6	1.921	.064
ESDV M210.5	51	16.330	.546
ESDV V211.2	13	8.062	.269

(1) Identical to TCP-2 Treatment Plant

(2) System Volume = Vessel Volume + Line Volume between ESDV

Total initial blow down rate : 1.874 MSCM/D

1.6.4.2 Sea Line Depressurization

1.6.4.2.1 Introduction

The sea lines blow down is not connected to the ESD system. This blow down is a voluntary action which is performed when the operating conditions and valve positions are satisfied, and which can be stopped at any time if necessary.

1.6.4.2.2 NEF Sea Line Depressurization (Ref. P & ID FF 88 00 00 5031 - Appendix 3)

The NEF sea line blow down is performed using both the LT relief system and the HP relief system. During the initial blow down period, i.e. when the pressure in the sea line is greater than 100 bara, the gas will have to be released through the LT relief system. The reason for this is the low temperature of the gas downstream the blow down valve due to the great pressure drop across the valve. (Temperature down to -75°C can be reached when the gas is depressurized from 160 bara and down to near atmospheric pressure).

In this stage depressurization valve FCV M210.1 and the manual operated isolation valve HV M210.3 will be open, while depressurization valve FCV M210.2 and the manual operated isolation valve HV M210.4 will be closed. The gas will then pass through to the LT relief system and is further vented to atmosphere in the existing cold vent stack.

A flow switch located at the outlet of the LT relief scrubber CV 226, will prevent the flow rate in the system from exceeding the design flow which is 2.8 MSCM/D.

As the pressure in the sea line decreases to below 100 bara, the temperature downstream of the blow down valves is such that it is possible to tie into the HP relief system. This is done by opening the depressurization valve FCV M210.2 and isolation valve HV M210.4, while corresponding valves for the LT relief system will be closing. The gas then passes through to the HP relief system and ties into the existing 24" relief header just upstream vessel CV 24 - HP Relief Scrubber.

A temperature switch (TSL M210.2) and a pressure switch (PSL M210.5) will protect the HP relief system in such a way that it is not possible to change from LT relief to HP relief before the temperature and the pressure are satisfactory (i.e. the pressure upstream of depressurization valves should be equal or lower than 100 bara and the temperature downstream of the isolating valve HV M210.4 should be equal or higher than -40°C).

The advantage of depressurizing in this way, is that the gas will be flared instead of vented and that the blow down flow rate can be increased due to the design conditions for the HP relief system (HP relief system is designed for a flaring flow rate equal to 34 MSCM/D).

When the HP relief system is used for depressurization of NEF sea line, the max. flow rate equals 8.4 MSCM/D from TCP-2 Extension area. The reason for this value is due to limitation on the criteria of flare pipe sizing, which is:

$$\rho v^2 \leq 100\,000 \text{ kgm/s}^2$$

and gas velocity ≤ 0.45 Mach

A differential pressure transmitter PDT M210.1, and a differential pressure recorder PDR M210.1 gives the flaring flow rate.

Initial conditions:

System : LT relief
Pressure : 160 - 100 bara
Flow rate : 2.8 MSCM/D

Final conditions:

System : HP relief
Pressure : 100 bara and below
Flow rate : 8.4 MSCM/D

System Protection

Protection during blow down of NEF sea line is achieved as follows:

Before any depressurization of NEF sea line is possible, an authorization signal will have to be given from CCR. Protection during blow down of this sea line is achieved as follows:

During the initial stage of blow down when the LT relief system is used, the released gas will be through valve FCV M210.1. This depressurization valve is opened by HIC M210.1 which is locally located, and it has been sized to pass 2.8 MSCM/D at 110 bara inlet pressure with 90% lift.

The flow to the LT relief, is measured by two annubar elements located downstream of vessel CV 226. Protection against excessive flow is by means of FSH V226.2, which will be set at design flow, i.e. 2.8 MSCM/D. If the flow by some means should exceed the design flow, the FSH will close valve FCV M210.1, thereby stopping the blow down of sea line. Before depressurization again is possible, a new authorization signal will have to be given from CCR.

Once the sea line pressure is at 100 bara, the PSL M210.5 provides permissive signal which together with a CCR authorization to use the HP flare system, enables the FCV M210.2 to be opened by HIC M210.2. This HIC is locally mounted. FCV M210.2 is sized for 8.4 MSCM/D at 100 bara inlet and 60% lift. Protection against malfunction of the HP relief system is:

- 1) PSL M210.5 which will not pass any gas through to the HP relief before the pressure is less or equal to 100 bara.
- 2) TSL M210.2 protects the HP relief piping (class ECX) from too low a temperature. This means that FCV M210.2 will close if the temperature in the piping system is less than -40°C.

Further protection is given by the overreading authorization signal from CCR. This applies to both systems. The flow to either system is measured by means of a pitot tube in line C2131 EFT 6" R. The status of the system will be monitored by means of position switches on the manual isolating valves HV M210.3 and HV M210.4, which will give indication in the CCR about which system that is in operation.

1.6.4.2.3 ODIN Sea Line Depressurization (Ref. PID FF 88 00 00 5030 - Appendix 3)

The ODIN Sea Line will be depressurized from the ODIN platform. Provisions have however been made to depressurize partially the ODIN pipeline from TCP-2 in case of plugging of the line by pigs or other unusual situations.

The blow down is performed by opening of the choke valve CSPM 201.3. This valve has been calculated to deliver a depressurization flow rate of 2.8 MSCM/D at 160 bara.

As for the NEF blow down line, the flaring flow rate is measured using a PD-transmitter and a PD-recorder:

PDT M201.1/PDR M201.1

1.6.5 Fire Protection

1.6.5.1 Introduction

All vessels are protected against fire exposure by pressure safety valves.

The calculation assumptions are in accordance with API RP 520 and API RP 521.

1.6.5.2 Liquid Vapourization Risk

Main assumptions:

- Vessels are not insulated which means that $F = 1$ in the formula:

$$Q = 2100 \times F \times A^{0.82}$$

Q = total heat absorption (input) to the wetted surface

A = total wetted surface

- The maximum liquid level (LSHH) is used to calculate the wetted surface.
- The total heat input is used as latent heat of vapourization.
- The condensate heat of vapourization is 72 kcal/kg and the relieved vapour is gas of molecular weight 16.9.
- The calculations for the vessels are shown in Appendix 11.

1.6.5.3 Gas Expansion Risk

The following calculations are applicable to CV 201 and CV 211.

They consider a total exposed area which includes the vessel itself plus surrounding pipe lines.

The calculations of the gas flow rates to be relieved are in accordance with the API 520:

The calculations are shown in Appendix 11.

1.6.5.4 Calculation Results

Table 1.16 summarizes the flaring flow rates due to fire exposure.

TABLE 1.16

FIRE PROTECTION

3) Relief Device	1) Fire Risk	Wetted Area m ²	Total Exposed area m ²	Total Heat Absorption Kcal/Hr	Mass Flow Rate Kg/Hr	Standard Flow Rate MSCM/D	2) Flare System
PSV CV 1A 6/7	L.V.	51		970.200	13.475	0.450	H.P.
PSV CV 201 1/2 1)	G.E.	-	104		19.506	0.656	L.T.
PSV CV 204 1/2	L.V.	11.8	-	286.500	3.978	0.134	L.P.
PSV CV 210 1/2	L.V.	60	-	1.048.000	14.550	0.489	L.T.
PSV CV 211 1/2 1)	G.E.	-	51		9.482	0.319	L.T.
PSV CV 213 1/2	L.V.	11.8	-	286.500	3.978	0.134	L.P.
PSV CV 220 1/2	L.V.	6.6	-	174.400	2.424	0.080	L.P.
PSV CM 201 1	L.V.	3.5	-	102.600	1.425	0.050	L.T.

(1) Fire Risk L.V. = Liquid vapourization
 G.E. = Gas expansion

(2) Flare System L.P. = Low pressure
 L.T. = Low temperature
 H.P. = High pressure

(3) The PSV CV 1A 6/7 are existing equipment.

FIRE PROTECTION - CONTINUED

Relief Device	Set Pressure barg	Relieving Pressure bara (Note 1)	Temp. Upstream Valve °C (Note 2)	Temp. Drop across Valve °C	Max. Back Pressure barg.
PSV CV 1A 6/7	176.5	195.15	94	64	44
PSV CV 201 1/2	176.5	195.15	94	64	4.7
PSV CV 204 1/2	24.0	27.4	149	14	1.0
PSV CV 210 1/2	176.5	195.15	129	49	4.7
PSV CV 211 1/2	176.5	195.15	129	49	4.7
PSV CV 213 1/2	24.0	27.4	149	14	1.0
PSV CV 220 1/2	15.2	17.72	246 (2)	8	1.0
PSV CM 201 1	176.5	195.15	94	64	4.7

Note 1 : Relieve pressure = set pressure + over pressure + 1
where over pressure equals 10% of set pressure.

P_1

Note 2 : Temp. upstream valve is determined from the relationship $T_1 = \frac{P_1}{P_n} \cdot T_n$

where P_1 = relieve pressure, bara

T_1 = relieve temperature, °K

P_n = normal operating pressure, bara

T_n = normal operating temperature, °K

1.6.6 Protection Against Process Over Pressure

1.6.6.1 Protection for High Pressure Gas Vessels CV 1A, CV 210, CV 201 and CV 211

No protection for blocked lines is required for NEF Slug Catcher and Metering Scrubbers.

The reason is that the MAWP, which is 177.5 bara, is higher than the maximum static well head pressure.

For the ODIN Slug Catcher, protection against over pressure will be provided in accordance with the final rerating on CV 1A.

1.6.6.2 ODIN Condensate Lines Downstream the ESDV V1A.2 and ESDV V201.3

1.6.6.2.1 Description

During normal operating conditions, the pressure in these lines will be 20 bara. In case of high process pressure downstream these ESD valves, the primary protection is the PSH V204.5. The PSH will close the valves ESDV V1A.2 and ESDV V201.3.

The secondary protection is the PSV V204.1 or PSV V204.2 with a set pressure of 25 bara. These protections are located on the Condensate/Methanol Separator CV 204.

The over pressure sizing case is caused by an uncontrolled flow from the condensate line. The flow rate is calculated based upon full opening of the manual globe valve which bypasses the level control valve LCV V1A.1.

1.6.6.2.2 Calculation Results

Basis Calculation Formula:

$$Q = CV \sqrt{\Delta P / G}$$

Q = Flow rate, USGPM

CV = Liquid sizing coefficient

P = Max. allowable differential pressure, psi

G = Specific gravity (water = 1.0)

Bypass valve (1" globe valve) :	CV = 3.5
Upstream pressure :	149 bara
Downstream pressure :	20 bara
Specific gravity :	0.662

The upstream liquid is supposed to be condensate without methanolated water and the valve calculation gives a volumetric flow rate of 186.1 USGPM or 42.3 m³/hr. This corresponds to a mass flow rate of 28070 kg/hr.

This fluid enters vessel CV 204, where the vapour released is evacuated through PSV V204.1/2. Maximum vapour flow rate is 2378 kg/hr, which is found by taking the ratio of normal operating gas flow to normal operating gas plus liquid condensate flow and multiply by 28070. This maximum gas flow is less than the figure given in Chapter 5 for Fire Exposure, which is 3978 kg/hr.

The gas is further sent to LP Vent Scrubber CV 7, which is an existing equipment (Ref. Schematic Diagram in Chapter 1.6.3).

1.6.6.3 NEF Condensate Lines Downstream the ESDV V210.2 and ESDV V211.3

1.6.6.3.1 Description

The preceeding description of the ODIN safety protection against over pressure applies to NEF liquid treatment. The assumptions are the same, but the instrument tag numbers are to be changed to:

ESDV V210.2
ESDV V211.3
PSH V213.5
PSV V213.1
PSV V213.2
LCV V210.1

1.6.6.3.2 Calculation Results

Basis

Bypass valve (1" globe valve)	: CV 3.5
Upstream pressure	: 136 bara
Downstream pressure	: 20 bara
Specific gravity	: 0.663

This corresponds to a mass flow rate of 26550 kg/hr.

The vapour released through PSV V213.1/2 is 2063 kg/hr, which is less than the gas released in case of fire exposure, which is 3978 kg/hr. (Ref. is made to chapter 1.6.5).

1.6.6.4 Thermal Expansion in CE 203 / CE 211

The condensate/methanolated water is heated using the exchangers CE 203/CE 211. At normal conditions the temperature at the outlet of the heaters will be 20°C.

If the temperature of the fluid is increased to a certain value (the value to be defined later), a temperature switch (TSH E203.5 and TSH E211.5) will shut off the heating medium which is the TEG solution. These switches are located just downstream the heaters.

Such an excess heat input could happen if the condensate/methanolated water is allowed to stay within the pipe without being withdrawn. Any pressure built up in the system because of vapour released due to heating, will be evacuated through the pressure control valves PCV V204.2 for the ODIN separator and PCV V213.2 for the NEF separator.

These valves are connected to the LP vent system.

1.6.6.5 Protection of Methanolated Water System

1.6.6.5.1 Protection of Vessel CV 220 - Methanolated Water Flash Drum

At normal conditions, the operating pressure in the vessel is equal to 10 bara. If the pressure by accident increases (as could happen in case of blocked outlet from the vessel or an uncontrolled flow into the vessel), the primary protection is a PSH V220.3. closing the inlet to the vessel. The secondary protection is the PSV V220.1/2 having a set pressure equal to 16.2 bara.

These PSV valves have been sized for max. release which is in case of fire (Ref. chapter 1.6.5).

1.6.6.5.2 Protection of Vessel CV 222 - Methanolated Water Drainage Tank

This vessel is not in continuous service and will only be used for drainage of vessels CV 204, CV 213 and CV 220 (the suction of glycol pumps CP 13 A/B also ties into this system).

The vessel is protected against process over pressure by a vent going to atmosphere. The drainage tank is operated at atmospheric conditions.

1.6.6.6 Protection on Shell Side of Condensate Heaters, TEG Lines and Glycol Surge Drums CV 17 A/B/C

The design pressure on the shell side of the condensate heaters CV 203/CE 211 is 25 bara. The tube side of these heaters are protected by a PSH and two PSVs set at 25 bara, located at downstream components CV 204 and CV 213.

In case of tube side failure, the three phases condensate, gas and methanolated water will leak into the shell side, because the operating pressure is lower than the tube side (5 bara and 20 bara respectively). From the shell, the fluid enters the glycol piping, which is designed at 25 bara.

The glycol return line will be used as relief system. The condensate, gas and methanolated water are sent to existing vessels CV 17 A/B/C. The gas is evacuated through a 2" existing breather line which leads to the LP vent system. The glycol surge drum design pressure which is 3.05 bara, will not be reached (Ref. Appendix 12).

Since the only isolation device between the heat exchanger and the vessels are manually block valves which will be locked open, the exchanger and vessel are considered as one unit regarding safety on the process side. A PSV on the shell side of the heaters and on the glycol piping, is therefore not required. The safety protection is made by the existing vent lines C 434/435/436-EA-2"-V.

1.6.6.7 Methanolated Water Storage Tank CV 9

The CV 9 - Methanolated water storage tank which is designed at 1.35 bara, was previously used as a glycol storage tank. The protection of this vessel has been modified to take into account the function as methanolated water storage.

This safety protection will be identical to the existing vessel CV 33.

This includes:

PSV V9.3 : - Emergency vent and manhole to relieve internal pressure of the vessel.

PSV V9.2 A/B : - Pressure and vacuum breather valves to relieve internal pressure and vacuum of the vessel during filling or emptying.

1.6.6.8 Pumps Discharge

All the outlets of reciprocating pumps are protected by pressure safety valves.

The protection of the outlets of centrifugal pump is not necessary, since the maximum discharge pressure will not exceed the rated working pressure of the piping.

1.7 GENERAL DRAWING LIST

1.7.1 General Drawings

The main Process Flowsheets, P. & I.D.s and Plot Plans/General Arrangement drawings are:

1.7.1.1 Process Flowsheets - Schematic Drawings

FF 88 00 00 0102	Schematic Process Diagram
FF 88 00 00 5100	Process Flowsheet - Gas Treatment
FF 88 00 00 5101	Process Flowsheet - Liquid Treatment
FF 88 00 00 0901	NEF and ODIN ESDV and Flare Systems Schematic Diagram

1.7.1.2 Process / Utilities Drawings - PIDs

FF 88 00 00 5030	Odin Gas Treatment - Separation
FF 88 00 00 5031	North East Frigg Gas Treatment - Separation
FF 88 00 11 5032	NEF and ODIN Liquid Treatment - Condensate Separation
FF 88 00 10 5033	NEF and ODIN Liquid Treatment - Methanolated Water
FF 88 00 00 5034	NEF and ODIN Liquid Treatment - TEG and MW Facilities
FF 88 00 54 5101	NEF and ODIN Liquid Treatment - Methanolated Water Injection DP-2
FF 88 00 04 5090	NEF and ODIN Treatment - Flare System
FF 88 00 09 5036	NEF and ODIN Treatment - Methanol Injections
FF 88 00 10 5100	NEF and ODIN Treatment - Process Drainage System
FF 88 00 02 5040	NEF and ODIN Treatment - Fuel Gas System
FF 88 00 00 0300	NEF and ODIN Treatment - Condensate and Gas Tie Ins
FF 88 00 10 5046	Deck Drainage System - Utility Flow Sheet
FF 88 00 00 5043	Utility Water - Utility Flow Sheet
FF 88 00 01 5041	Instrument Air, Plant Air - Utility Flow Sheet.

FF 88 00 17 5044

Fire Water and Washdown Piping -
Utility Flow Sheet

FF 88 00 08 5045

Hydraulic Power Distribution

FF 88 00 00 5555

Legend for Piping and Instrument
Diagrams Sheet No. 1.

1.7.1.3 Plot Plans - Arrangement Drawings

FF 88 20 00 0105

Static Module M50 - Plot Plan.

FF 88 20 00 0101

Pancake 53 - Plot Plan

FF 88 20 00 7300

Tie In Piping Arrangement
Cellar Deck - El. 100.000

FF 88 20 00 7305

Tie-In Piping Arrangement Main Deck
El. 108.850

FF 88 20 00 7307

Tie-In Piping Arrangement Upper Deck
El. 116.350

FF 88 20 00 8860

General Arrangement of DP 2 Package
of Methanolated Water Injections.

2 PRINCIPLE OF ENGINEERING DESIGN

2.1 ENVIRONMENTAL CONDITIONS

2.1.1 Wind

2.1.1.1 Wind Profile

The wind speed has been calculated as a function of height above the mean water level and averaging time interval by the power law.

$$V = V_{1hr, 10} \left(\frac{Z}{10} \right)^{\beta}$$

Where:

V_{tz} is the wind speed averaged over a time interval as defined by a and β , Z metres above the mean water level.

$V_{1hr, 10}$ The wind speed averaged over one hour, 10 metres above the mean water level.

a gust factor; referenced to

β height exponent

2.1.1.2 Factors in the Power Law for Wind Profile

AVERAGE TIME INTERVAL						
	1 hr	10 min.	1 min.	15 sec.	5 sec.	3 sec.
a	1.000	1.060	1.180	1.300	1.370	1.390
β	0.150	0.130	0.113	0.106	0.102	0.100

2.1.1.3 Reference Wind Speed

The reference wind speed has been taken as the averaged wind speed over one hour, 10 metres above the mean water level, and with a 100 years return period.

$$V_{1hr} = 42.45 \text{ m/s.}$$

2.1.1.4 Prevailing Winds

Prevailing winds are from W S W to N W sector.

2.1.1.5 Storm Wind Direction

Storm winds on Frigg Field vary in direction throughout the year according to prevailing directions stated below.

Storm wind \geq 10 BEAUFORT (25 m/s).

MONTHS	SEPT	OCT	NOV	DEC	JAN	FEB	MAR	APR	MAY
NW & N	44	40	35	27	19	12	28	18	51
W & SW	35	47	40	35	37	31	28	28	33
S & SE	18	13	20	34	40	57	43	54	16
E & NE	3	<1	5	4	4	<1	1	<1	<1
	100	100	100	100	100	100	100	100	100

2.1.2 Ambient Air Conditions

2.1.2.1 Ambient Air Temperature

The expected extreme daily averaged temperatures are:

Minimum - 9°C
Maximum +22°C.

2.1.2.2 Ambient Air Relative Humidity

Maximum 99 %
Minimum 35 %

and saliferous atmosphere.

2.1.2.3 Rainfall

Rainfall yearly average 990 mm

Maximum 24 hours 86 mm

Average number of rainy days: 195 days/year.

2.1.2.4 Atmospheric Pressure

Mean pressure monthly average at sea level:

753 mm/Hg (Dec)

761 mm/Hg (June).

2.1.2.5 Snow and Ice Accumulation

Snow and ice accumulation has not been considered in the overall calculation.

2.1.3 Sea Water Characteristics

2.1.3.1 Sea Water Temperature

Extreme temperatures at the sea surface:

Minimum + 4°C

Maximum + 17°C

Extreme temperatures at - 50 m LAT:

Minimum + 5°C

Maximum + 12°C

Extreme temperatures at - 100 m LAT: (Sea bottom)

Minimum + 4.8°C

Maximum + 9.5°C.

2.1.3.2 Sea Water Salinity

The extreme value of the sea water salinity expressed in weight percentage is:

at the sea surface : minimum 31.27 o/oo
maximum 35.40 o/oo

Current velocity at 30
metres above sea bottom 0.70 m/s

Current velocity at sea
bottom 0.30 m/s.

at - 50 metres LAT : minimum 34.02 o/oo
maximum 35.41 o/oo

at - 100 metres LAT : minimum 34.30 o/oo
: maximum 35.48 o/oo

2.1.3.3 Sea Water Oxygen Content

The sea water oxygen contents based upon a monthly average is:

at the sea surface : minimum 5.69 ml/l
: maximum 7.16 ml/l

at - 50 metres LAT : minimum 5.51 ml/l
: maximum 6.89 ml/l

at - 100 metres LAT : minimum 5.56 ml/l
: maximum 6.60 ml/l

2.1.4 Water Depth - Sea Level

2.1.4.1 Water Depth

On the site of TCP-2 Platform, the sea water depth is 103 metres from the LAT (Lower Astronomical Tide).

2.1.4.2 Tide in Storm Conditions

Maximum astronomical tide range above LAT 1.70 m
Maximum wind drift surge 0.30 m

2.1.4.3 Tide in Operating Conditions

Maximum astronomical tide range above LAT 1.70 m
Maximum wind drift surge 0.30 m

2.1.5 Waves and Current

2.1.5.1 Storm Conditions

Wave height 29 m

Wave period 16 s

Current velocity
at surface 1.35 m/s

2.1.5.2 Operating Conditions

Wave height	17.4 m
Wave period	12 s
Current velocity at surface	1.00 m/s
Current velocity at 30 m above sea bottom	0.58 m/s
Current velocity at sea bottom	0.30 m/s.

2.1.5.3 Prevailing Wave Direction

See 2.1.1.5 - "Storm Wind Direction".

It has to be noted that storms from W and SW, and especially from NE and E have a short fetch which limits the wave height.

The waves which are liable to present the maximum height are from:

NW to N

SE to S.

2.2 DOCUMENT NUMBERING, DISTRIBUTION AND ROUTING

2.2.1 Foreword

This document is based upon the Annex C of the F.087 contract.

2.2.2 Units of Measurements

The System International (SI) system has been used for all the project documents except for pipe nominal diameters, schedules and flange rating for which English units apply.

2.2.3 Numbering System

2.2.3.1 Numbering Equipment

A) Numbering of Main Equipment

All significant items of equipment have been given an equipment number that comprises a prefix and suffix.
The indices of prefixes are as follows:

CV	Vessels, Filters
CP	Pumps
CC	Compressors
CT	Turbines
CE	Heat Exchangers, Air Coolers
CH	Heaters
CQ	Glycol Regeneration Units and Package Units
CM	Pig Launchers and Receivers, Miscellaneous Mechanical Equipment
CPS	Miscellaneous Piping (Strainers, Silencers, Choke Valves).

The suffixes are assigned sequentially for each item of equipment starting at:

200 for ODIN equipment
210 for North East Frigg equipment
220 for equipment common to North East Frigg and ODIN effluents treatment.

In the event of two or more identical items of equipment existing, a further suffix A, B, C etc. is assigned.

i.e. CV 5A
CV 5B
etc.

B) Line Identification (for Piping only)

The line identification consists of six parts, and the following is an illustration:

	C	2026	EC	10"	P	1	
	:	:	:	:	:	:	
Platform TCP-2-----	:	:	:	:	:	:	
Line Number-----	:	:	:	:	:	:	--Type of
Pipe Specification-----	:	:	:	:	:	:	Insulation
Nominal Line Size-----	:	:	:	:	:	:	
							-----Commodity
							in Line

B.1 Platform : TCP-2 = C

B.2 Line number : For the TCP-2 Extension the following series were used:

ODIN Lines	:	2000 to 2099
NEF Lines	:	2100 to 2199
Lines common to ODIN & NEF	:	2200 to 2399
Utility Lines	:	2400 to 2599

B.3 Pipe Specification

Specification identification is defined in the piping specification S-FF 88 20 5406.

B.4 Commodity in Line

The following identification was be used:

Commodity	Commodity Identification
Process	P
Relief	R
Vents	B
Process and Deck Drains	DR
Glycol	G
Hydrocarbon Dump	HD
Fuel Gas	FG
Diesel Oil	DO
Methanol Air	ME
Instrument Air	IA
Plant Air	PA
Fire Water	FW
Sea Water	SW
Utility Water	UW
Hydraulic Fluid	HF
Mud	M
Potable Water	PW

B.5 Type of Insulation

1. Calcium silicate
2. Cellular Glass

C. Structural Identification

Welding symbols are according to AWS D1.0 and AWS D1.

D. Electrical Identification

The IEC 117 graphical symbols are used.

E. Instrument Identification

The I.S.A: - S5.1, Instrumentation, Symbols and Identification were for tagging of instruments.

2.2.3.2 Numbering of Engineering Drawings (Including Isometrics)

A. General

The drawings were coded as follows:

- 2 letters for site identification (1)
- 2 digits for the installation (2)
- 2 digits for the speciality (3)
- 2 digits for the system (4)
- 4 digits for the chronological number (5)
- 2 digits for the revision index (6)

Example:

	FF	88	20	11	5137	04
	:	:	:	:	:	:
(1) Site (Frigg Field)-----	:	:	:	:	:	:
(2) Installation (TCP-2 Ext.)----	:	:	:	:	:	:
(3) Speciality (Piping)-----	:	:	:	:	:	:
(4) System (Corrosion inhibitor-----	:	:	:	:	:	:
injection)	:	:	:	:	:	:
(5) Chronological-----	:	:	:	:	:	:
(6) Revision-----	:	:	:	:	:	:

B. Codification of Site

All new developed drawings had a site identification:

FF (series 88).

The originals from the Frigg existing installations which were modified (for integration works) were coded FE (Frigg Extension) until the As Built stage. At that time the "FE" code was replaced by the original one. Through all stages the other numbers except the revision number remained the same.

C. Codification of Installation

00. If more than one main class is concerned.

10. Standards

60. North-East Frigg Development

61. Field Control Station

62. Sub-sea Wells

63. Pipeline

64.

65.

66. Experimental Equipment

67.

68.

69.

70. Frigg Field Line and Cable Connection

80. Frigg Field Development Phase 2

81.

82.

83. DP-2 = Drilling Platform No. 2

84. Wells DP-2

85. TCP-2 = Treatment and Compression Platform No.2
(Treatment)

- 86.
- 87. Compression Facilities of TCP-2
- 88. TCP-2 Extension
- 90. Frigg Field Development Phase 1
- 91. CDP-1 = Concrete Drilling Platform No. 1.
- 92.
- 93. DP-1 = Drilling Platform No. 1.
- 94. Wells CDP-1
- 95. TP-1 = Treatment Platform No. 1.
- 96. QP = Quarters Platform
- 97.
- 98.
- 99. FP = Flare Platform

D. Codification of Speciality

- 00 - General document if more than one speciality concerned (P and I Diagrams).

Including - General view of installation.

- Plot plan
- Area classification
- Architectural
- Safety Plot Plan

- 16 - Instrumentation
- 20 - Piping, Casing
- 21 - Steel Structures (except jacket and support frame)
- 22 - Offshore Platform (jacket, support frame)
- 23 - Electricity
- 24 - Civil Work (concrete structure)
- 26 - Mechanical
- 30 - Process
- 36 - Underwater Intervention Equipment
- 37 - Sea Fastening, Temporary Equipment, Erection

E. System Identification

The equipment identification system is different from platform to platform.

E.1 Installation : DP-2 (83)

Index of systems

System No.:	Designations
00	<u>Generalities</u>
01	<u>Air System</u> Air Compressors Dryers Nitrogen System Plant Air (10 bars) Instrument Air (3 bars) Instrument Outlet Signals
02	<u>Electrical System (5.5kV</u> Distribution System inside Module A).
03	<u>Electrical System (380 V and</u> 220 V Distribution) MCC and Distribution Interlocks Normal Lighting Generator Earthing
04	<u>Electrical System (48 V</u> Distribution) Battery and Chargers Switchboard 48 V DC and Distribution
05	<u>Detection System</u> Smoke Fusible Plugs Gas Detectors Fire Detection Panel
06	<u>Protection System</u> Deluge System Halon System CO ₂ Firepumps (SPP) Monitor Hose Extinguishers Remote Start Fire Pumps ESD DSD Emergency Lighting 24 hrs Emergency Lighting 1 hr

07	<u>Evacuation</u> Lifeboats (Two Lifeboats only in Module 4) Escape Routes Lifesaving Equipment Life Raft Supports on Module Framing
08	<u>Warning</u> Alarm Horn (for DSD Fire) Public Address Telephone Cable Pulling
09	<u>Beaconing</u> Navigation aids Warning Lights Horn
10	Soft Water System
11	Utility Sea Water System
12	Gas Oil System
13	Ventilation - Air Conditioning - Pressurization
14	Test Separator and Flare
15	Gas Circuit by Well
16	Gas Outlet Scrubbers (inside Modules)
17	Vent System
18	Condensate System (inside Modules)
19	Kill Lines (inside Modules)
20	Methanol System
21	Corrosion Inhibitor System
22	Hydraulic Pneumatic and Electrical System for Valves.
23	Hydraulic Pneumatic and Electrical System for ROV Valves (except ROVs 201-202 and 203) West Cluster East Cluster
24	Slop Line (inside Modules)
25	Drain System (inside Modules and Support Frame).

26	Lifting Devices (inside Modules)
27	Living Quarters
28	Steel Structures
29	Chlorination Lines
30	Offshore Work Site Handling Mobilization of Site Installation Site Administration Demobilization of Site Installation
35	Miscellaneous
50	Life Rafts
51	Telephone Installation
52	Geotechnical and Mechanical Syminex Syntef Comsip
54	Methanolated Water Disposal

E.2 Installation : QP (96)

Index of Systems

System No.:	Designation:
01	Firewater and Fire
Detection	
02	Potable Water
03	Utility Water
04	Transformer and Emergency Generator
05	Drainage and Condensate
06	Instrument and Plant Air
07	Safety Systems
08	Diesel Oil
09	Washdown Water
10	Air Conditioning
11	Telecommunications
13	Incineration - Fuel Gas
14	Control Room
15	Aviation Fuel
16	Sewage
17	Electrical
18	Steel Structure and Module
19	Geotechnical and Mechanical
20	Oceano - Meteo Equipment
25	Miscellaneous
26	Cathodic Protection
27	Computer

E.3 Installation : TCP-2 Extension (88)

- only 2 digits are used for numbering of engineering drawings.
- subsystems coded as A, B, C, etc... were used later on for progress, planning, commissioning and start-up purposes.
- some systems are deleted as they do not correspond to any function in the TCP-2 Extension project.

INDEX OF SYSTEMS

00	Generalities, Loop Diagram
01	Instrument and Plant Air Supply <ul style="list-style-type: none">a) Instrument Air Distributionb) Service Air Distribution
02	Fuel Gas
03	Electrical Systems <ul style="list-style-type: none">a) Cable Traysb) 380 V Power Distributionc) Normal Lightingd) Emergency Lightinge) Emergency Power (220 V No Break)f) 24 V DCg) Groundingh) Trace Heating
04	High Pressure Relief <ul style="list-style-type: none">a) High Pressure Relief to CV 24b) Low Temperature Relief
05	Low Pressure Relief
06	Safety Systems <ul style="list-style-type: none">a) Public Address and Public Alarmb) Gas Detectionc) Fire Detection
08	Hydraulic and Shut Down System
09	Methanol High and Low Pressure <ul style="list-style-type: none">a) Methanol High Pressureb) Methanol Injection to NEF

10	Drainage
	a) Open Drainage
	b) Closed Drainage
	c) Methanolated Water
11	Condensate
12	Gas CV 1A - CV 210 to Compression Header
14	Gas Inlet (from Riser to CV 1A, CV 210 Inlets).
16	Glycol Heating Medium
17	Fire Water and Extinguishing System
	a) Fire Water
	b) Deluge Water
	c) Extinguishing System
18	Washdown
22	Miscellaneous
25	Steel Structure and Modules
	a) Structure
	b) Access and Escape Ways
27	Corrosion Inhibitor
29	Lifting Equipment
30	Cathodic Protection

F. Chronological Number Breakdown

This number is established for each speciality per installation.

F.1 TCP-2 Extension : Site Code : 88

F.1.1 Discipline 00 : General

0001 to 0999 : Plot Plan - Layout
1000 to 1999 : Architectural General Platform
2000 to 2999 : No Allocation
3000 to 3999 : General Loading Drawings
4000 to 4999 : Safety
5000 to 5999 : PID
6000 to 9999 : No Allocation

F.1.2 Discipline 16 : Instrumentation

0001 to 0999 : Reserved for temporary drawings
1000 to 9999 : No special breakdown

F.1.3 Discipline 20 : Piping

0001 to 1999 : Arrangement Drawings
2000 to 2099 : Isometrics for ODIN Lines
2100 to 2199 : Isometrics for NEF Lines
2200 to 2399 : Isometrics for Common Lines to
ODIN & NEF
2400 to 2599 : Isometrics for Utility Lines
2600 to 3999 : No Allocation
4000 to 4999 : Pipe Supports
5000 to 9999 : Others

F.1.4 Discipline 21 : Structural

0001 to 1099 : General
1100 to 1999 : Support Frame
2000 to 2999 : Structural Module Upper Deck (M50)
3000 to 3999 : Main Deck : T.O.S. - Skid Beams
4000 to 4999 : Columns C1-C3-C5 Equipment
5000 to 5999 : Cellar Deck (P53) - Bridge TP1 - TCP-2
6000 to 6999 : Weight Estimate
7000 to 7999 : Miscellaneous, Projects, Sketches
8000 to 8999 : Sketches (Installation Drawings)
9000 to 9999 : No Allocation

F.1.5 Discipline 23 : Electricity

0001 to 9999 : No special breakdown

F.1.6 Discipline 26 : Mechanical

0001 to 9999 : No special breakdown

F.1.7 Discipline 30 : Process

0001 to 9999 : No special breakdown

Note : This discipline does not exist for EAN Engineering, but is allowed for TCP-2 Extension Project.

F.2 TCP-2 Extension : Other Site Codes

The new drawings to be issued for works connected to TCP-2 Extensions project but to be carried out within the Frigg Field existing facilities i.e.:

Site Code:	83	DP-2
	85	TCP-2 Treatment
	87	TCP-2 Compression
	95	TP-1
	96	QP

have, whatever the discipline is, chronological numbers taken within the range 8800 to 8899.

F.3 Revision Index

All revisions are mentioned on the drawings, and the updating of the drawings register shall be done accordingly.

2.2.3.3 Numbering of Technical Documents Other Than Drawings

2.2.3.3.1 Prefix

The FF Site Code will be preceeded by:

S	for Specifications, Data Sheets, Tie-In Files
C	for Calculation Notes
CH	for Charts
P	for Procedures
M	for Manuals
L	for Lists - M.T.O.
R	for Requisitions

2.2.3.3.2 Field Specification

FF are always used for types of documents listed in paragraph 2.2.3.3.1.

2.2.3.3.3 Codification of Installation

Refer to paragraph 2.2.3.2.3.

2.2.3.3.4 Codification of Speciality

Refer to paragraph 2.2.3.2.4.

2.2.3.3.5 Chronological Number

Refer to paragraph 2.2.3.2.6.

Exception

For the following instrumentation equipment, the chronological number is taken within the given ranges:

Flow Transmitter	10 00 to 10 99
Local Flow Meter	11 00 to 11 99
Flow Meter with Totalizer	12 00 to 12 99
Level Transmitter/Controller	20 00 to 20 99
Pneumatic Level Switch	21 00 to 21 99
Electrical Level Switch	22 00 to 22 99
Level Gauge	23 00 to 23 99
Pressure Transmitter	30 00 to 30 99
Pneumatic Pressure Switch	31 00 to 31 99
Electric Pressure Switch	32 00 to 32 99
Pressure Gauge	33 00 to 33 99
Temperature Probe	40 00 to 40 99
Transducer/mA	41 00 to 41 99
Thermometer	42 00 to 42 99
Control Valve	50 00 to 50 99
Choke Valve	51 00 to 51 99
ESDV Valves	52 00 to 52 99
Safety Valves	53 00 to 53 99
Electro Valve	54 00 to 54 99
Recorders	60 00 to 60 99
Indicators	61 00 to 61 99
P/I Transducers	62 00 to 62 99
Alarm System	63 00 to 63 99
Control Panel	70 00 to 70 99
Interface Cabinet	71 00 to 71 99
Fire Detection	80 00 to 80 99
Gas Detection	81 00 to 81 99

2.2.3.3.6 Revision Index

Refer to paragraph 2.2.3.2.7.

2.2.3.3.7 Numbering Sample

S - FF 88 16 5301 00

1 2 3 4 5 6

- 1 : Prefix (Specification here)
- 2 : Field Specification
- 3 : Codification of Installation
- 4 : Codification of Speciality
- 5 : Chronological Number (Safety Valves here)
- 6 : Revision Index

2.2.3.4 Numbering of Inquiries

The numbering will be as follows (sample).

FO 20 0001 00

1 2 3 4

- 1 : Project Reference : FO
- 2 : Speciality : refer to paragraph 2.2.3.2.4
- 3 : Chronological number : from 0001 and so on.
- 4 : Revision index : two figures from 00 and so on.

2.2.3.5 Numbering of Engineer's Purchase Orders

The numbering will be as follows (sample):

FO 1 20 0001 00

1 2 3 4 5

- 1 : Project Reference : FO
- 2 : Nature of the order : 1 for equipment
2 for service contract
3 for mixed contract
- 3 : Speciality : refer to paragraph 2.2.3.2.4
- 4 : Chronological number : from 0001 and so on.
- 5 : Revision index : two figures from 00 and so on.

2.2.3.6 Numbering of Letters, Transmittals, Telexes, Minutes of Meeting

2.2.3.6.1 Numbering of Letters

A. Correspondence from Company to Engineer.

Letters have been numbered in sequence as follows:

LCE = Letter Company to Engineer

001 = First number of sequence

Any equipment mentioned in letters has been identified by its tag number whenever possible.

B. Correspondence from Engineer to Company.

Letters have been numbered in sequence as follows:

LEC = Letter Engineer to Company

001 = First number of sequence

Any equipment mentioned in letters has been identified by the tag number whenever possible.

2.2.3.6.2 Numbering of Telexes

Telexes have been similarly numbered as follows:

A. Telexes from Company to Engineer

where TCE = Telex Company to Engineer.

B. Telexes from Engineer to Company.

where TEC = Telex Engineer to Company.

2.2.3.6.3 Numbering of Transmittals

Drawings and specifications have been accompanied by a data transmittal form. These forms carried letter numbers as mentioned in paragraph 2.2.3.6.1.

2.2.3.6.4 Numbering of Minutes of Meeting

The minutes of meeting were numbered as follows:

A. - Minutes of meeting from Engineer

MEC

001 : First number of sequence

B. - Minutes of meeting from Company

MCE

001 : First number of sequence

All the minutes of meetings were transmitted by a numbered covering letter.

2.2.4 Document Distribution

The Engineering contractor distributed the various documents as follows:

Legend (O) : Original
(R) : Reproducible

Documents (not limited to)	EAN DUSAVIK	EAN YARD	EAN SITE	TOTAL
A. <u>Contract Correspondence</u>				
- Letters	4+1(O)			5
- Minutes of Meeting	4+1(O)			5
- Contractual Documents	6+1(O)			7
B. <u>General Correspondence</u>				
- Letters	4+1(O)	1	1	7
- Minutes of Meeting	4+1(O)	1	1	7
C. <u>Engineering Documents</u>				
Engineering correspondence				
- Letters	4+1(O)	1	1	7
- Minutes of Meeting	4+1(O)	1	1	7
Documents for approval				
- Basic Engineering Documents	8			8
- Detailed Engineering Documents	8			8

Documents (not limited to)	EAN DUSAVIK	EAN YARD	EAN SITE	TOTAL
- Documents established by Engineer	8			8
- Documents established by Supplier for Engineer				
. Documents before approval by Engineer	4			4
. Documents with Engineer's comments	6			6
Documents "Approved for Construction" or final documents				
- Basic Engineering Documents 15+1(R)				16
Detailed Engineering Documents:				18
. Documents established by Engineer	15+1(R)			16
. Documents established by Supplier	10+1(R)			11
D. <u>Procurement Documents</u>				
Correspondence				
- Correspondence between Engineer and Company				
. Letters	4+1(0)			5
. Minutes of Meetings	4+1(0)			5
Correspondence between Engineer and Suppliers or Contractors				
. Before Purchase Order	3+1(0)			4
. After Purchase Order	4+1(0)			5
Tenderer's List				
- Before approval	4+1(0)			5
- Approved	4+1(0)			5

Documents (not limited to)	EAN DUSAVIK	EAN YARD	EAN SITE	TOTAL
Inquiry requests				
- General Purchase Conditions	4+1(0)			5
- Requests for Bids	4+1(0)			5
- Requests for Purchases	4+1(0)			5
Bids and Bid Tabulation				
- Acknowledgement of receipt	4+1(0)			5
- Bids	4+1(0)			5
- Bid Tabulations for approval with associated correspondence	6+1(0)			7
- Signed Bid Tabulation	6+1(0)			7
Purchase Orders				
- Purchase Orders and Changes in Orders for signing	4+1(0)			5
- Signed Purchase Orders and Changes in Orders	4+1(0)	1	1	7
- Purchase Order Lists	4+1(0)	2	2	9
- Spare Parts Lists	4+1(0)			5
- Shipping Lists	4+1(0)	2	2	9
Acknowledgement of Receipt of Orders				
Expediting/Inspection				
- Expediting Reports	4+1(0)	1	1	7
- Inspection Reports	4+1(0)	1	1	7
- Procurement Schedule Report	4+1(0)	1	1	7
- Manufacturing Schedules	4+1(0)	1	1	7
- List of Suppliers Subcontractors	4+1(0)	1	1	7
- Test Reports	4+1(0)	1	1	7
- Acceptance Documents	4+1(0)	1	1	7
Invoices	4+1(0)			5
E. <u>Project Control</u>				
Project Schedule	10	1	1	12
Cost Control Report	6	1	1	8
Financial Report	5			5
Monthly Progress Report	10	1	1	12

Documents (not limited to)	EAN DUSAVIK	EAN YARD	EAN SITE	TOTAL
F. <u>Manuals</u>				
Safety Manual	12-1(R)			12+1(R)
Operating Manual	12-1(R)			12+1(R)
Maintenance Manual	12+1(R)			12+1(R)
G. <u>Engineering Dossier</u>	10+1(0)			10+1(0)
H. <u>All Other Items</u>	5+1(0)			5+1(0)

2.3 ENGINEERING DESIGN

2.3.1 Structural Design

The structural design of TCP-2 Extension Project (Module M50 and Pancake P53) has been founded on the following limitations given by EAN:

- 1) Decks to be flushed with adjacent decks
- 2) Length of module to be equal to the adjacent module (M01)
- 3) Trusswork of module to be equal to adjacent module.
- 4) Pancake configuration conforms to present temporary pancake.

In addition the design has been based on "TCP-2 EXTENSION PROJECT; STRUCTURAL BASIS OF DESIGN", which contains:

- 5) 6.3.2 - Steel Structure; Basis of Design
- 6) SP M/NT No 43 B0 A 301 ; Materials for Welded Steel Structures.
- 7) SP M/NT No 43 B0 A 303 ; Fabrication of Steel Structures of Deck Modules

Module M50

Consists of:

- Two longitudinal trusses which are supported each 2 places.
- Lower deck on transverse beams spanning between the trusses.
- Upper deck on transverse beams spanning between the trusses.
- Mezzanine (intermediate) deck which is partly supported on the two trusses and partly by columns to the lower deck
- Sway bracing between the ends of the trusses.

Sway bracings, trusses, lower and upper decks forming a rigid box.

The truss members H-shapes are designed with vertical flanges which correspond to vertical node plates at each side of the nodes.

The node plates form areas with poor access for sandblasting and painting. These areas are therefore sealed by 8 mm plates. Also the support nodes (footings) are sealed areas.

A lifting rig is designed 5 m above upper deck. This rig reduces the amount of offshore work, and it contributes to the overall strength of the module during lifting which is the true design condition.

Lifting rig is temporary and shall be removed after installation.

Pancake P53

Pancake P53 is a pure beam structure with a deck plate on angle stringers which are spanning between primary and secondary beams.

A pipe support rack is located on the Pancake.

A lifting rig is designed to avoid conflicts between lifting slings and equipment. Lifting rig is temporary and shall be removed after installation.

2.3.2 Mechanical Design

The basis of the mechanical design was information obtained from Process Flow Diagrams. All equipment was designed to be exposed to a severe salt water atmosphere, 100% humidity and ambient temperature; - 9°C to 32°C.

All equipment has been designed in strict accordance with:

- 1) NPD - Regulations for Production and Auxiliary Systems on Production Installations
- 2) DnV - Technical Notes, Vol. B.
- 3) Codes and Standards listed below
- 4) Applicable Job Specifications.

Furthermore a great effort has been made in order to ensure compliance with the design document and to ensure good practice of QC-functions at the vendors in the lack of good working QA/QC systems.

2.3.2.1 Applicable Codes / Standards

Pressure Vessels: BS 5500

Heat Exchangers : BS 5500 and TEMA Class R

Pumps : API 610 with the exceptions mentioned
in the Purchase Order

2.3.3 Piping Design

2 3.3.1 Design

The piping design for this project was based upon following codes and standards:

- ANSI / ASME B31.3 - Chemical Plant and Petroleum Refinery Piping (1980 edition)
- ASTM Material Standards
- Material requirements in accordance with the relevant ASTM standard and Det norske Veritas (DnV) "Technical Notes for Fixed Offshore Installations Volume B".

2 3.3.2 Piping Materials

2 3.3.2.1 Piping Materials on TCP-2

Material specification of pipework to be erected on TCP-2 was, to the extent possible, based upon the original "Piping Material Specification No. 2110-50-1" prepared by McDermott-Hudson. Some piping classes in this specification were, however, revised/replaced mainly due to following:

- Specified ASTM standard had been withdrawn (Class EFS)
- Non-existing in McDermott-specification (Class EFT)
- Process calculations showed design pressures allowing a lower flange pressure rating (Class EAT)
- Experienced problems with existing installations (Class EZS - hydraulic fluid)
- Additional corrosion allowance for sea water piping (Class ELS).

2.3.3.2.2 Piping Materials on DP-2

Specification of materials for pipework to be erected on DP-2 was based on original Lummus Engineering Specification No. H.102 rev. 2.

Operating / design pressure for the methanolated water disposal line on DP-2 did not require more than 150 lbs flange rating. However, as some of the existing piping in class D1A (600 lbs) was to be utilized, decision was made to maintain this pressure rating throughout the system.

2.3.3.3 Piping Design Pressure Classes

Pressure Rating	Piping Material	Piping Class	Service
150 lbs	Carbon Steel	A2A, EA, EK, ELS, EU	Drainage, instrument air, plant air, process hydrocarbons, firewater, seawater, utility water, glycol, methanolated water, fuel gas, hydraulic fluid return
150 lbs	Stainless Steel	EAT	Low Temperature Relief System
300 lbs	Carbon Steel	EB	Process hydrocarbons, glycol, low pressure relief.
600 lbs	Carbon Steel	D1A, ECX	Methanolated water, high pressure relief
1500 lbs	Carbon Steel	EFS	Process hydrocarbon gas, H.P. methanol, process drains, fuel gas, condensate / methanolated water
1500 lbs	Stainless Steel	EFT	Hydrocarbon gas to relief
* 2300 lbs	Stainless Steel	EZS	Hydraulic fluid

* Design Pressure

2.3.3.4 Piping Stress Analysis

The major high pressure gas process lines and the entire low temperature relief system have been stress calculated utilizing a computer program for flexibility analysis.

2.3.4 Electrical Design

2.3.4.1 Motor Control Centre MCC

The 380 volt motor control centre for TCP-2 Extension is located in main substation M32.

The two existing TCP-2 Compression MCCs S.52.32.3.3 and S.52.32.2.3 are extended with two new switchboards delivered from National Elektro.

Each switchboard is split into two sections, "A" and "B"-sides. The interconnection between existing TCP-2 Compression MCC and new MCC extension is by an air circuit breaker rated at 1600 amps.

The following is a list of consumers for each switchboard.

S.52.32.3.3 -MCC "A" Ext.

CP 220 A	TEG Circulation Pump
CP 220 C	TEG Circulation Pump
CP 222 A	Methanolated Water Injection Pump
CP 224	Methanolated Water Drainage Pump
W14	Welding Socket.

S.52.32.2.3 -MCC "B" Ext.

CP 220 B	TEG Circulation Pump
CP 222 B	Methanolated Water Injection Pumps
W15	Welding Socket
DB 321	Normal Lighting Panel.

2.3.4.2 Lighting Distribution Board "DB"

There are two types of lighting DBs. Both are located in TCP-2 Treatment cabling room P08. The cabinet is of normal industrial type. Manufacturer ELDON IP 55. The cabinet is equipped with Merlin Gerin fuses.

Normal Lighting

The normal lighting distribution board DB 321 is fed from new TCP-2 Extension S.52.32.2.3 MCC. The fluorescent fixture is normal outdoor type IFA Ex (e).

Maintained Lighting

The new TCP-2 Extension emergency lighting DB 322 is supplied from the existing TCP-2 Treatment DB 308, a distribution board connected to the emergency power system. The lighting fixture is manufactured by IFA Ex (e).

2.3.4.3 Power Distribution Board "DB"

There are two types of power distribution boards. Both are located in TCP-2 Treatment interface room P13. The cabinet is of normal industrial type. Manufacturer ELDON IP 55. The cabinet is equipped with Merlin Gerin contr. fuses.

Emergency Supply

The emergency supply cabinet DB 324, supplies the instrument and fire & gas system with 24 V DC. DB 324 is supplied from the existing TCP-2 Treatment DB 310 maintained instrument supply.

No Break

The no break cabinet DB 323 is fed from the TCP-2 Compression no break system in PC 44 S.53.44.3.9 interface room P13. This cabinet DB 323 feeds the instrument fire and gas, telemetry and zener barrier rack with 220V AC.

2.3.4.4 Trace Heating

The trace heating cabinet DB 316 is located in the cabling room P08. Each outgoing circuit is going directly to a marshalling box and then splitted to each different heating cable. Phyretenox heating cable is used.

2.3.4.5 Hazardious Areas

The two modules for TCP-2 Extension, M50 and P53 are classified as Division 2 area.

2.3.4.6 Design

The design of electrical drawings and calculations is executed according to EAN standard, specification and integrated drawings.

2.3.5 Instrument Design

2.3.5.1 Instrument Installation M50 & P53

The instrument installation on TCP-2 extension comprises following functions:

- 1) Process Control & Monitoring
- 2) Emergency Shut Down & Process Safety System
- 3) Fire Detection & Protection Safety System
- 4) Public Address System

2.3.5.2 Process Control & Monitoring

The process control is based mainly upon local control loops except for gas flow through gas metering system where the set point can be remote controlled from central control room, (CCR) on QP platform. All control loops and various other parameters are monitored on mimic panel which is part of main control panel installed in CCR. Both local and remote recorders in main control panel are used.

Ref. (Appendix 3):

FF 88 00 00 5030	ODIN Gas Treatment
FF 88 00 00 5031	NEF Gas Treatment
FF 88 00 11 5032	NEF and ODIN Liquid Treatment Condensate Separation
FF 88 00 10 5033	NEF and ODIN Liquid Treatment Methanolated water
FF 88 00 00 5034	NEF and ODIN Liquid Treatment TEG and MW Facilities
FF 88 00 09 5036	NEF and ODIN Treatment Methanol Injection
FF 88 00 04 5090	NEF and ODIN Treatment Flare System
FF 88 00 10 5100	NEF and ODIN Treatment Process Drainage System
FF 83 00 54 5101	NEF and ODIN Liquid Treatment Methanolated Water Injection on DP-2.

2.3.5.3 ESD and Process Safety

The ESD system is split in five different levels of which 4th and 5th levels are considered as process safety system.

1st level is field shut down with isolation of platforms.

2nd level shut down for TCP-2 is total shut down and also decompression of bridge and treatment lines.

3rd level is process shut down and this level can also be released by fire or gas detection system.

4th and 5th levels are process safety and shuts down either one production stream or part of the stream.

Ref.:

S-FF 88 16 08 9521	Description of Process Safety System
S-FF 88 16 9520	Functional Description of the ESD System
FE 00 16 00 5801	Frigg Field Shut Down General Logic Diagram
FF 88 16 08 9557	Shut Down Detail Logic Diagram

2.3.5.4 Fire and Gas, Public Address System

The fire detection system consists of UV flame detectors, smoke detectors and manual fire alarm buttons.

A fire control panel is installed in the interface room in P13.

Action is either fire alarm or 3rd level shut down release of deluge system depending of activation of sensors/pushbuttons. Operation of a push button will cause fire alarm, 3rd level shut down and release of deluge system in affected area. Activation of one UV detector or smoke detector will cause fire alarm whilst activation of two sensors in coincidence will cause 3rd level shut down and release of deluge in affected area.

Eight loudspeakers are installed in Module M50, 4 on upper and 4 on lower level. 2 loudspeakers are installed on P53. These are integrated in the existing PA system.

Ref.:

S-FF 88 16 9620	Description of Fire Detection System
S-FF 88 16 9720	Description of Gas Detection System
S-FF 88 16 9820	Description of Public Address and Alarm System

2.3.6 Safety / Loss Prevention

2.3.6.1 Area Classification

As for the rest of the Frigg Field the IP Model Code of Safe Practice, part 1 of 1965 with supplement and part 8 of 1972, is the basis for the area classification.

Definitions and classification of types of release and zones are based upon "Provisional Regulations for Electrical Installations in Explosive Areas", communications 1/77 from the Norwegian Water Resources and Electricity Board, NVE.

Reference is made to the following drawings:

FE 85 23 00 0020	Area Classification Upper Deck
FE 85 23 00 0021	Area Classification Main Deck
FE 85 23 00 0022	Area Classification Cellar Deck
FE 85 23 00 0023	Area Classification East and South Elevations
FE 85 23 00 0024	Area Classification West and North Elevations.

2.3.6.2 Escape Routes

Escape routes are in accordance with Norwegian Petroleum Directorate (NPD) regulations.

2.3.6.3 Firewater System

The firewater systems for M50 and P53 are supplied from and integrated into the existing firewater network on TCP-2. Both M50 and P53 have interconnected dual supply from Treatment Area and Compression Area.

Firewater spray system capacity and coverage is in accordance with regulations laid down by NPD:

Process area	10 l/min ²
Surface of pressure vessels and tanks containing combustibles	10 l/min ²

The deluge/spray system is designed in accordance with NFPA 15.

2.3.6.4 Fire Fighting Equipment

Folllowing firefighting equipment is installed:

M50:

- 2 Firewater Hose Reels
- 2 Firewater Hose Reels connected to
AFFF Foam Tank
- 2 Wash Down Hose Reels
- 4 Firewater Monitor with 2 1/2" NOR Lock
Hydrant

P53:

- 1 Firewater Hose Reel
- 1 Firewater Hose Reel connected to
AFFF Foam Tank
- 1 Wash Down Hose Reel
- 2 Fire Monitor with 2 1/2" NOR Lock
Hydrant.

3 NEF - ELECTRICAL POWER SUPPLY

3.1 GENERAL DESCRIPTION OF NEF POWER SUPPLY INSTALLATION

The North East Frigg facilities are linked to the TCP-2 Frigg Field platform via a 16" gas line, a 1 1/4" hydrate inhibitor (methanol) supply line and an electric power/signal supply cable which provides the FCS with both electrical power and remote control signals. Control signals are also transmitted through a radio link system.

The electrical sub sea cable between TCP-2 Frigg Field and FCS at North East Frigg is 18 km long. The penetration of the sub sea cable into the TCP-2 platform is through the J5-tube in Column 5. The length of the J5-tube is 150 m, the bending radius is 30 m and it contains four plastic tubes. One of these is used for the 1 1/4" hydrate inhibitor supply and one for the sub sea cable. On top of the J5-tube inside Column 5 a hang off table is installed, in which the sub sea cable has its anchor point.

Just a few meters above the anchor point the sub sea cable is spliced to the emerged power cable and the emerged signal cable. The emerged power cable and the emerged signal cable are running in parallel on the 12kV high voltage cable ladder to the 12kV high voltage room in Module 32.

From the anchor point and up to el. 99.000 the tray is running up inside column 5. From el. 99.000 to el. 101.000 a solide pipe is installed to protect the cables. After rising from el. 101.000 the cable tray bends into el. 104.000. When entering PC 43 the tray rises to el. 106.000. After turning north in PC 43 the tray rises to el. 107.400 to avoid pipes and crossing beams. The tray continues in this elevation through PC 45 till it rises into the 12kV high voltage room Module 32.

The 12kV high voltage cable ladder is of stainless steel, 300 mm wide and covered all the way in order to protect the 12kV high voltage cable. To meet the requirements of EAN regulations of full insulation between racks/trays of stainless steel and supports of mild steel, P.V.C. shims are used.

The 12kV high voltage room in Module 32 was formerly a workshop. To meet the requirements of NPD regulations for high voltage rooms, the following structural and HVAC tasks have been executed. An air lock is built in connection with existing entry in west end of the room. A wire mesh-wall with door is installed by the staircase. A sliding door is replaced with a bolted panel with emergency exit - door. The drain has been moved and relocated under the HVAC unit. Further a steel plate is mounted under the three water pipes which are crossing the 12kV high voltage room.

The ventilation system in the 12 kV high voltage room comprises a new moisture eliminator, new fine filter, new sparkproof fan, heater, ductwork, new purging fan and accessories necessary to supply the sufficient amount of air, approximately 8000 m³/hr, to the H.V. room. In order to maintain an internal pressure of 6 mm WG above ambient, fresh air is drawn in from outside safe area. To remove moisture and entrained salt/dirt particles, the air is passed through a three stage moisture eliminator system, and through a centrifugal fan. In the H.V. room the air passes across 40 kW electric air heater. Via a rigid galvanized ductwork system the air is delivered to the H.V. room. Exhaust air is relieved to outside via a modulating fire damper, maintaining the area over pressure via an extract purging fan - not working under normal conditions.

The system will run automatically under normal platform operating conditions, and will shut down under ESD closure or by manual stop. After an emergency shut down, the H.V. room will be purged by the same system.

During purging the electric heater will be isolated and the extract purging fan will be working (approx. 5000 m³/hr). The modulating fire damper will be kept fully open.

In the 12 kV high voltage room a cast resin power transformer and a 12 kV switchgear are installed. The transformer is fabricated at Asea Lepper works in Brilon, West Germany, and its power rating is 630 kVA, voltage rating 5,5/12kV + 2 x 2.5 %, frequency 50 Hz, Vector group Dyn II and protective housing IP 23. The transformer is fitted with devices for service earthing on both the primary and secondary side, by fixed lockable earthing switches. The neutral point of the secondary winding is connected directly to earth. A two - core transformer 30/1/1A is fitted in the neutral inside the housing, one core rated 10 VA and CL.5 and the other core rated 10 CA CL.1.

The 12 kV switchgear is fabricated at the Merlin Gerin works in Grenoble, France, and consists of one voltage transformer cubicle and one drawout circuit - breaker cubicle. Voltage transformers are mounted in the voltage transformer cubicle. A 630A SF6 circuit breaker, current transformers, equipment for protection, measure, control etc. are located in the circuit - breaker cubicle. Both cubicles have incoming and outgoing cables from below.

A drawout truck comprising a 400 A vacuum contactor and 350 A HCR fuses, manufactured at the G.E.C. works in Rugby, England, is installed in a spare 5,5 kV switchgear cubicle, tagged VC 622, in existing 5,5 kV high voltage room module 32. Voltage and current transformers, equipment for measure, protection, control etc., circuit earthing switch and space heaters are mounted in the cubicle.

From VC 622 to the 630 kVA transformer a $3 \times 120 \text{ mm}^2$ 6 kV cable is installed on existing high voltage cable trays. All supply, control, heating, measurement and alarm cables in connection with the NEF power project are mainly clamped on existing trays, except under Module 32, where new low voltage cable trays are installed.

The electrical control board on mezzanine in MCC room, Pancake 08 on TCP-2 Treatment, is extended to display the mimic diagram of NEF Power Supply. The NEF mimic panel is manufactured at the Setram works in Salies - du - Salat, France, and fixed to the existing mimic panel's right side (front viewed). The length of extension panel is 72 cm. A new NEF alarm annunciator panel is mounted on the existing mimic panel to give alarm signals from NEF via a radio link system.

In the 12 kV high voltage room a signal isolation cabinet is installed. The purpose of this is to segregate high voltage from the signal circuit.

A signal cable is routed from the signal isolation cabinet via TP-1 platform to the central control room on QP platform.

The utility panel in central control room on QP platform is modified and shows the mimic diagram for the power supply to North East Frigg facilities.

3.2 DESIGN PHILOSOPHY

The electrical power supply from TCP-2 platform to the FCS on the NEF Field is the main power supply source for the FCS.

This is the first known high voltage power distribution plant via a combined power and signal cable over a relative long distance of 18 km. A lot of different calculations and investigations have been performed in order to ensure as high as possible reliability both for the power supply and the signal transmission line. As an example of calculation performed, it could be mentioned; a dynamical electrical network analysis for the whole Frigg Field. The calculation has been performed by EFI - the Norwegian Research Institute for Electricity Supply in Trondheim.

This analysis cover the following aspects:

- Short circuit levels in the network.
- Dynamical behaviour of the network due to short circuits and motorstarting on different platforms.
- Dynamical stability of the network. (Small signal disturbances)

As an example of investigations, an overharmonic ripple current measurement and a study regarding an eventual installation of a special harmonics filter in case of disturbances on signal transmission line, could be mentioned.


The choice of equipment such as the transformer, switchgear and other electrical equipment have been based upon well known design and references within the offshore industry. The high voltage equipment protection devices and settings have been selected in such a way that in case of a fault in the system, the fault shall be islanded without any interruption of other parts of the network.

For more detailed information concerning how the system is built up and tied into existing electrical network on TCP-2 the one line diagram - FF 88 23 03 0001 (Figure 1.17).

FIGURE 1.17

Drawing No.: FF 88 23 03 0001

NEF Power Supply One Line Diagram

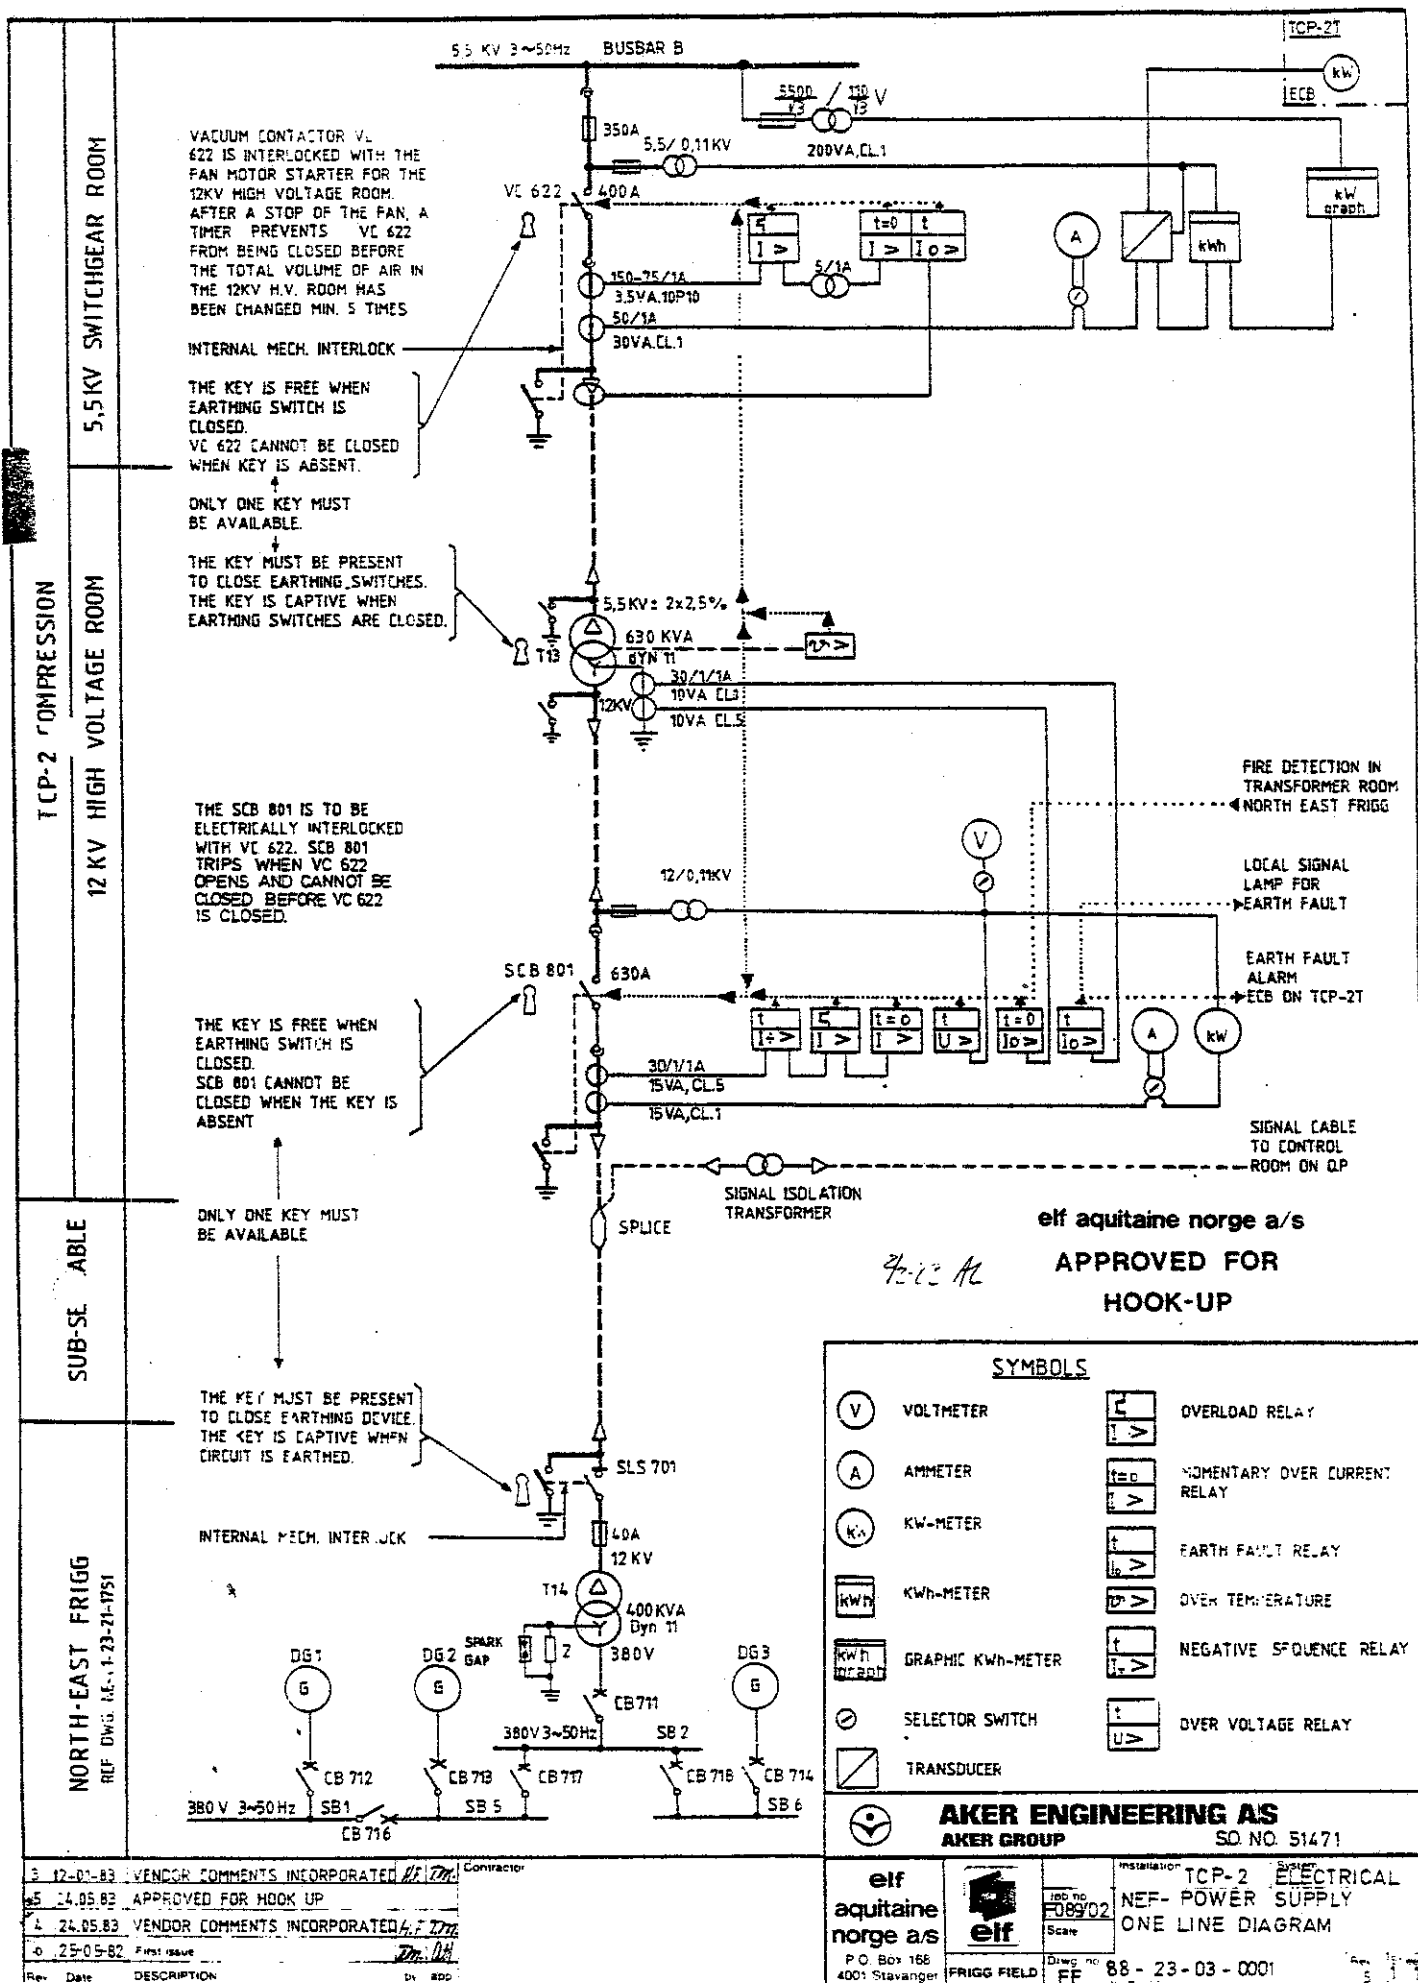

APPENDIX 1

NEF GAS COMPOSITION, RESERVOIR PRESSURE AND
PRODUCTION PROFILE

NEF GAS COMPOSITION, RESERVOIR PRESSURE
AND PRODUCTION PROFILE

GAS COMPOSITION NEF

COMPONENT	MOLE %
N 2	.6682
C02	.3010
C1	94.2498
C2	4.6479
C3	.0722
iC4	.0099
nC4	.0100
iC5	.0001
nC5	.0002
C6	.0012
C7	.0058
C8	.0082
C9	.0083
C10	.0073
C11	.0043
C12	.0028
C13	.0013
C14	.0007
C15	.0003
C16+	.0005

NORTH EAST FRIGG

Hypothesis: With water drive

Date	Static Bottom Pressure (bar a)	Well Head Flowing Pressure (bar a)	Average Daily Quantity (MSm3/D)	Design Flow Rate (MSm3/D)	Minimum Delivery Pressure on TCP2 (bar a)
01.01.1984	176.8	146	5.78	7.0	136.
30.09.1984	168	138	5.78	7.0	128.
" 1985	155	129	5.78	7.0	119.
" 1986	144	121	5.40	6.5	111.
" 1987	136	114	5.04	6.1	105.
" 1988	128	108	4.00	4.8	101.

NORTH EAST FRIGG

Hypothesis: Without water drive

Date	Static Bottom Pressure (bar a)	Well Head Flowing Pressure (bar a)	Average Daily Quantity (MSm3/D)	Design Flow Rate (MSm3/D)	Minimum Delivery Pressure on TCP2 (bar a)
30.09.1984	160	129.5	6.38	7.7	115.
" 1985	133	106	6.1	7.3	93.
" 1986	107	86	5.08	6.1	76.
" 1987	88	70	4.2	5.0	61.
" 1988	70	56	3.44	4.1	48.
" 1989	58	45	2.86	3.4	37.
" 1990	46	35	2.36	2.8	30.
" 1991	37	28	1.92	2.3	23.
" 1992	30	22	1.6	1.9	18.
" 1993	24	18	1.3	1.6	14.

APPENDIX 2

ODIN GAS COMPOSITION, RESERVOIR PRESSURE
AND PRODUCTION PROFILE

ODIN GAS COMPOSITION, RESERVOIR PRESSURE
AND PRODUCTION PROFILE

GAS COMPOSITION ODIN

COMPONENT	MOLE %
N 2	.92
CO2	.24
C1	94.81
C2	3.85
C3	.06
iC4	.01
nC4	.02
iC5	.02
nC5	.02
C6+	C6+ .05

ODIN

Hypothesis: With water drive

Date	Static Bottom Pressure (bar a)	Well Head Flowing Pressure (bar a)	Average Daily Quantity (MSm3/D)	Design Flow Rate (MSm3/D)	Minimum Delivery Pressure on TCP2 (bar a)
01.01.1985	171.5	147	10.19	11.2	137.
30.09.1985	156	133	10.19	11.2	123.
" 1986	142	123	10.19	11.2	110.
" 1987	131	111	10.19	11.2	101.
" 1988	121	104	9.28	10.2	95.
" 1989	114	99	7.08	7.8	92.
" 1990	110	96	5.29	5.8	91.
" 1991	109	94	4.10	4.5	90.
" 1992	109	93	3.28	3.6	90.
" 1993	109	92	2.89	3.2	90.


ODIN

Hypothesis: Without water drive

Date	Static Bottom Pressure (bar a)	Average Daily Quantity (MSm3/D)	Design Flow Rate (MSm3/D)	Minimum Delivery Pressure on TCP2 (bar a)
01.01.1985	183	10.19	11.2	149.
30.09.1985	160	10.19	11.2	128.5
" 1986	130	10.19	11.2	101.5
" 1987	107	10.19	11.2	69.
" 1988	85	9.28	10.2	50.
" 1989	64	7.08	7.8	38.
" 1990	48	5.29	5.8	28.
" 1991	32	4.10	4.5	19.5
" 1992	28	3.28	3.6	13.
" 1993	25	2.89	3.2	11.

APPENDIX 3

PROCESS FLOW DIAGRAMS

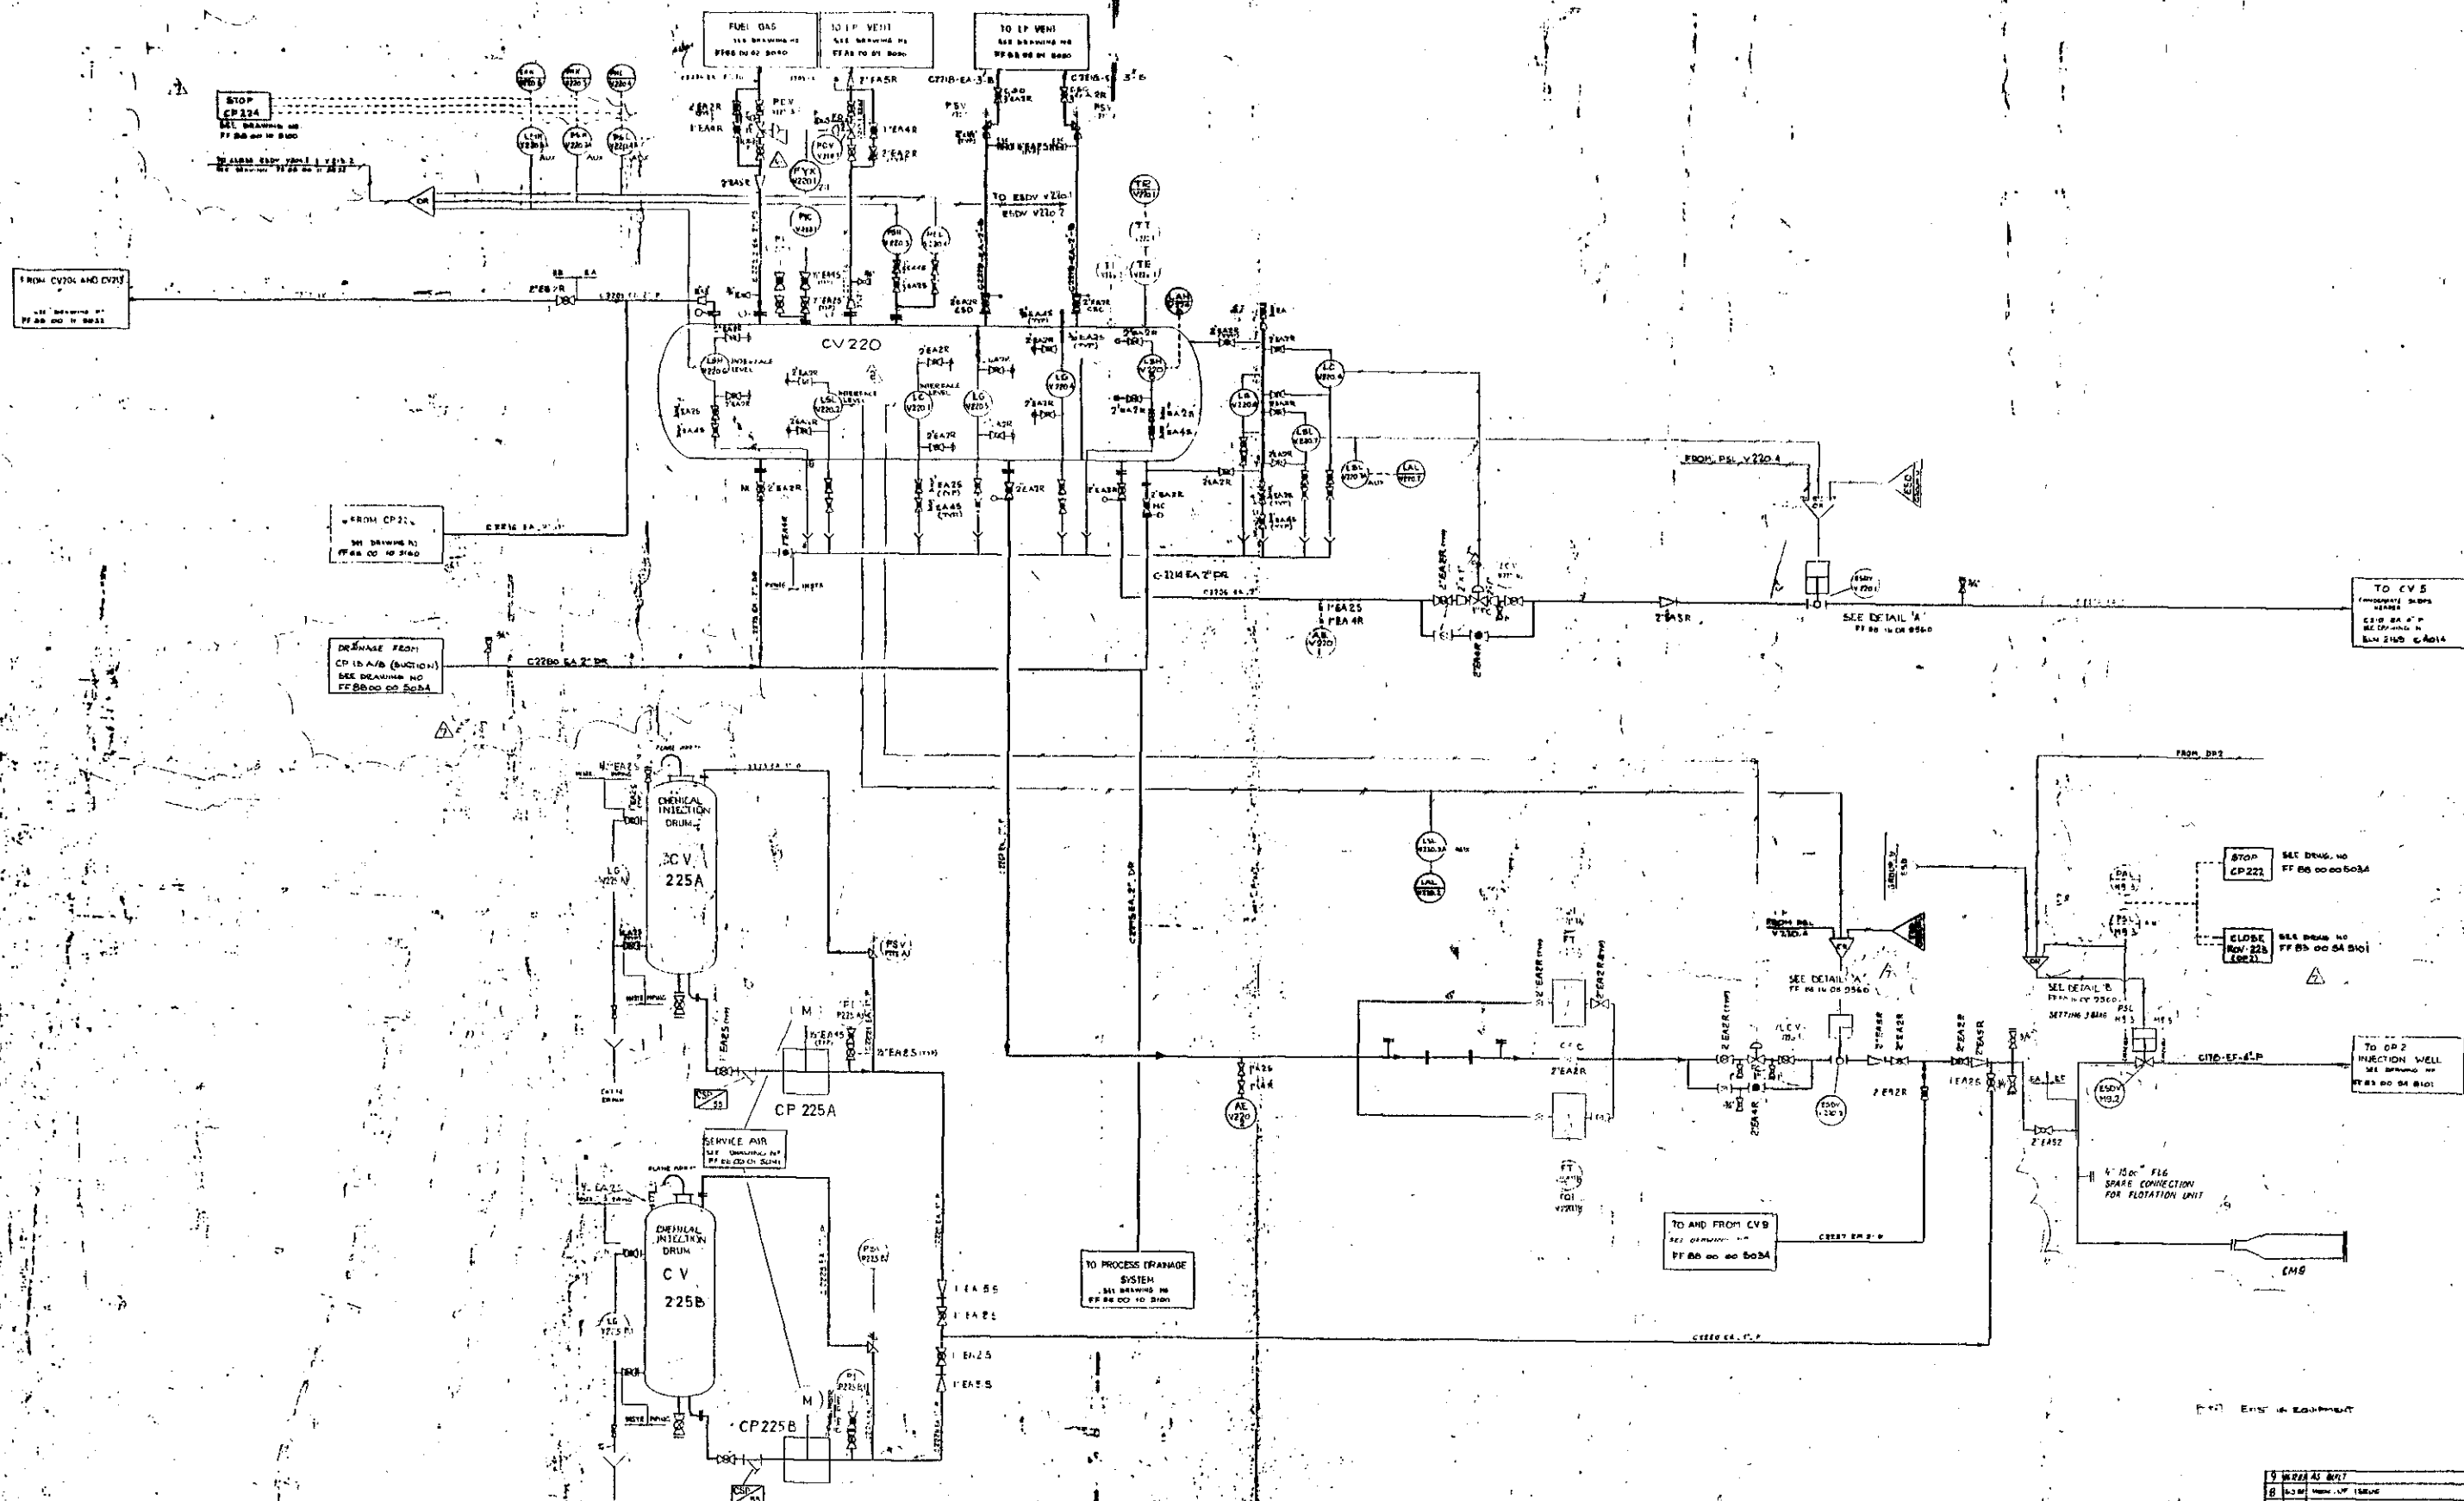











APPROVED FOR
HOOK-UP










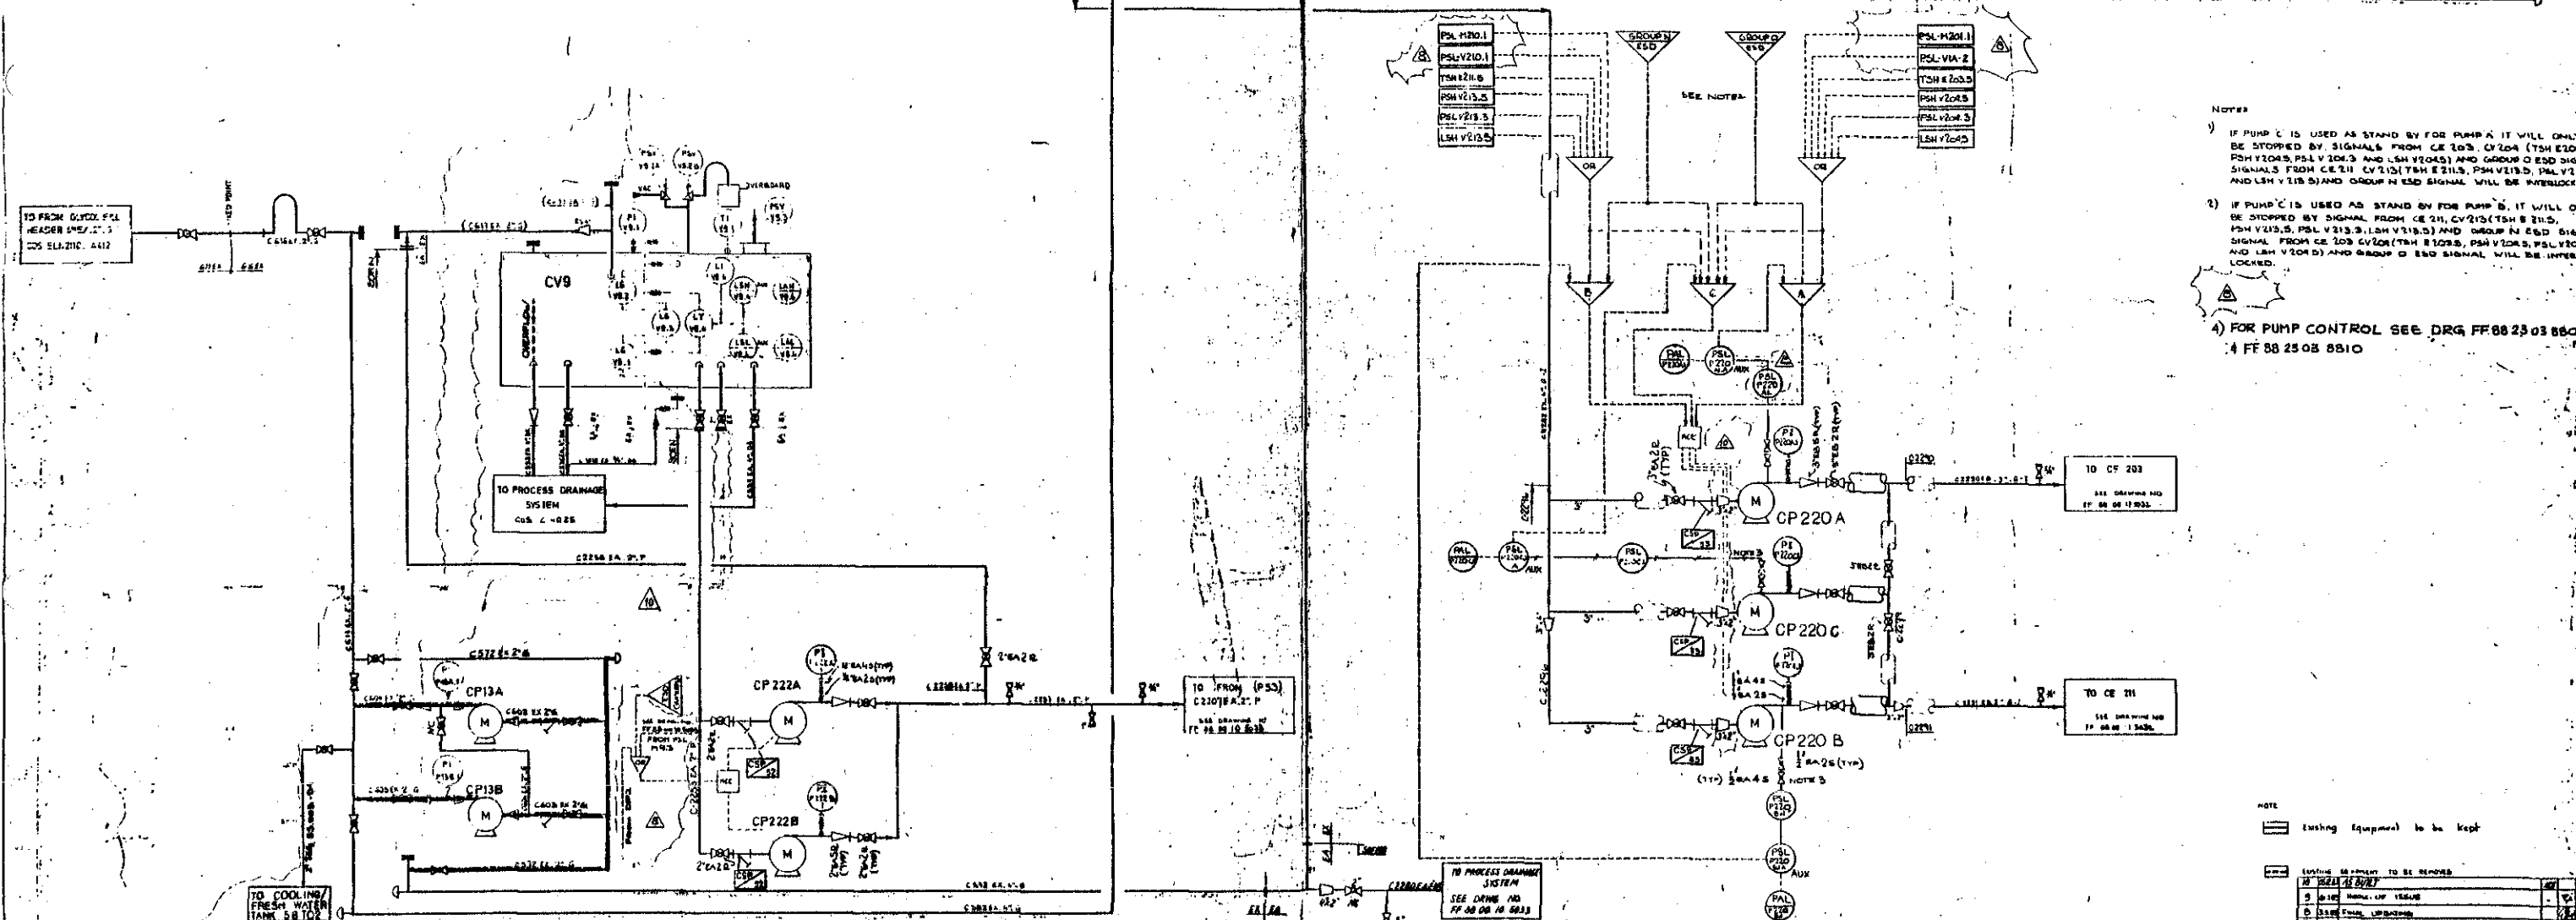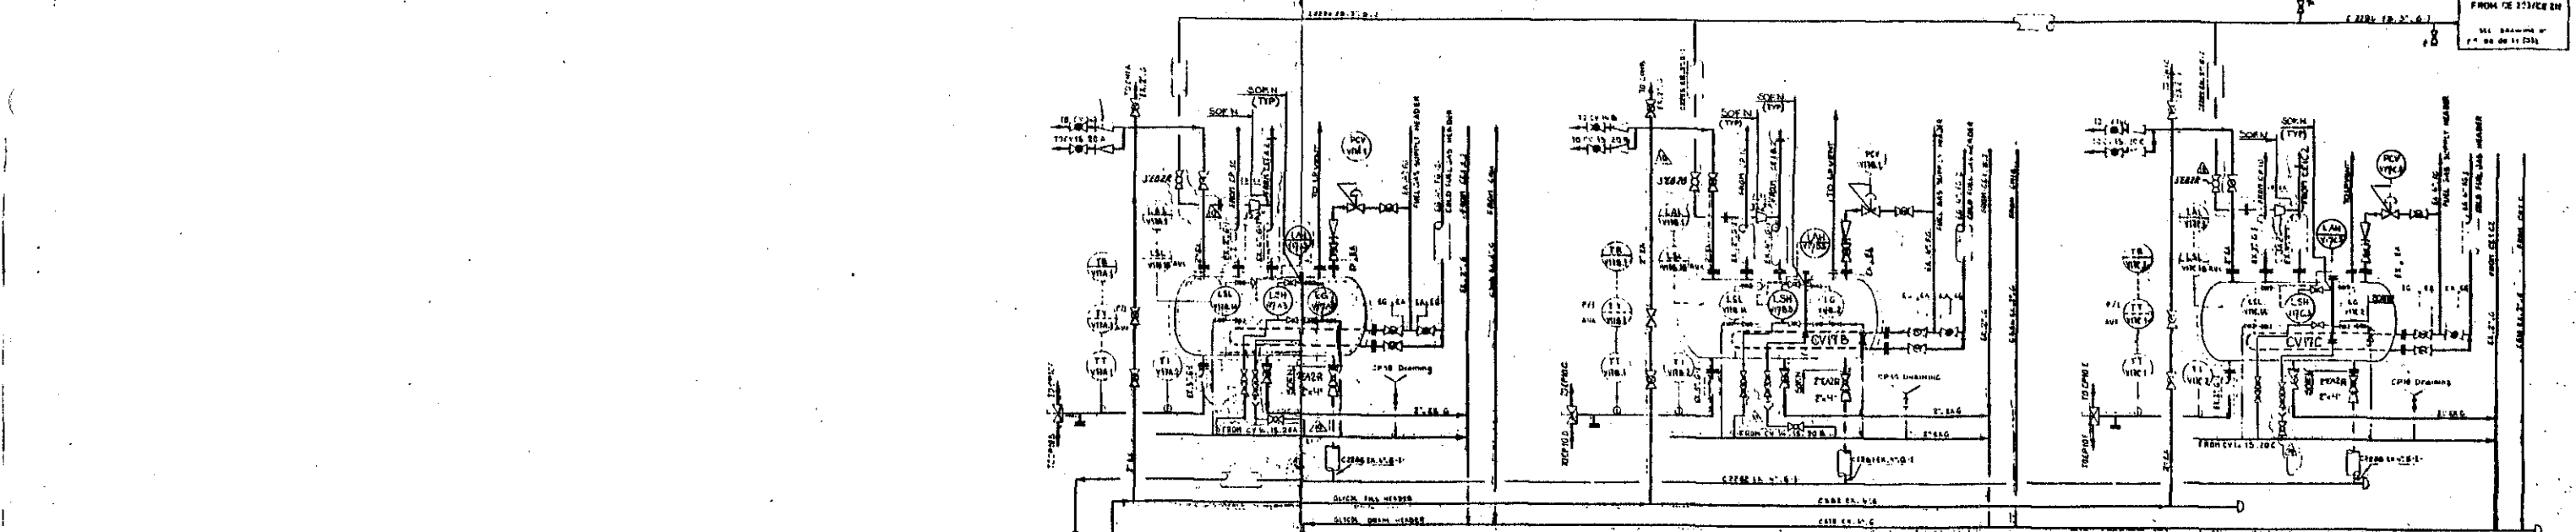

- NOTES
- IF PUMP C IS USED AS STAND BY FOR PUMP A IT WILL ONLY BE STOPPED BY SIGNALS FROM CE 203, CV104 (TSH E2035), PSH V204.3, PSL V204.3 AND LSH V204.5. SIGNALS FROM CE 211, CV213 (TSH E2115), PSH V213.3, PSL V213.3 AND LSH V213.5 AND GROUP N ESD SIGNAL WILL BE INTERLOCKED.
 - IF PUMP C IS USED AS STAND BY FOR PUMP B, IT WILL ONLY BE STOPPED BY SIGNAL FROM CE 211, CV213 (TSH E2115), PSH V213.3, PSL V213.3, LSH V213.5 AND GROUP N ESD SIGNAL. SIGNAL FROM CE 203, CV204 (TSH E2035), PSH V204.3, PSL V204.3 AND LSH V204.5 AND GROUP O ESD SIGNAL WILL BE INTERLOCKED.
 - FOR PUMP CONTROL SEE DRG FF 88 23 03 8600
4 FF 88 23 03 8610

NOTE
 (dashed line) Existing Equipment to be kept
 (solid line) Existing Equipment to be removed

NO.	REVISION	DATE	BY	CHKD.
1	ISSUED FOR APPROVAL			


PI 09.000.5034

TCP2 EXTENSION

APPROVED FOR
HOOK-UP

MW/Methanolated Water

FRIGG FIELD
FF 88 00 00 5034

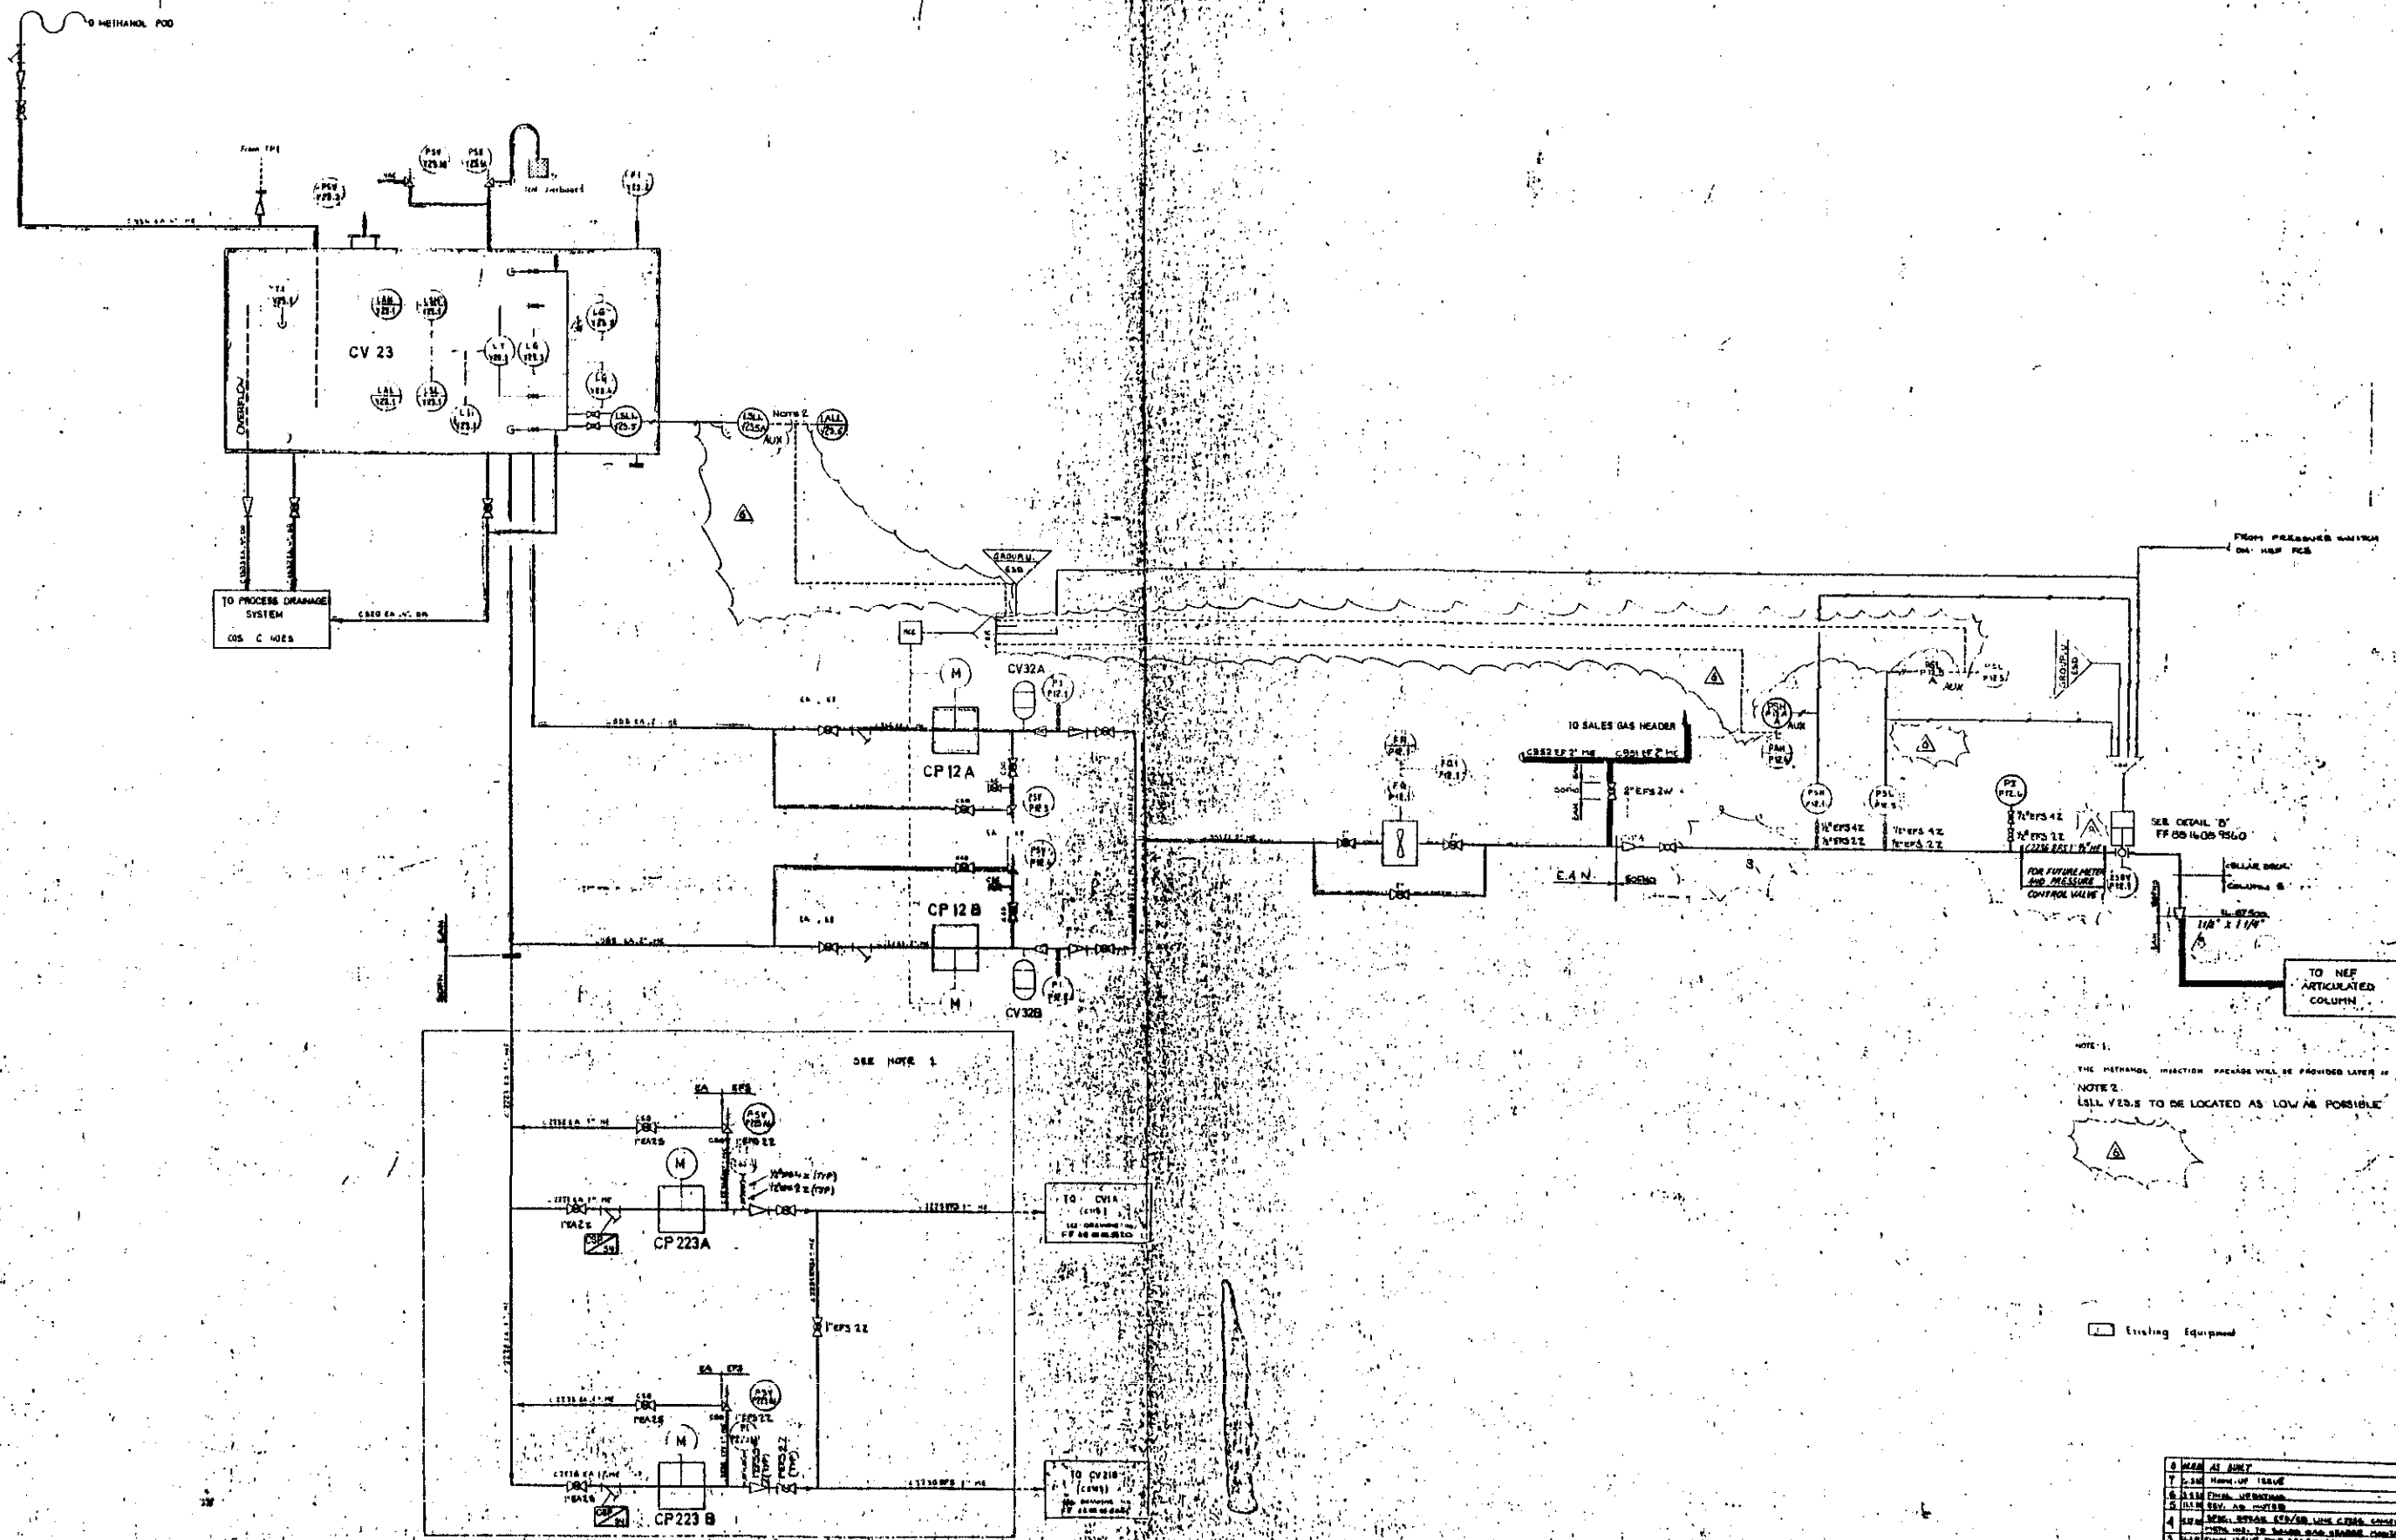

NOTE 1:
THE METHANOL INJECTION PACKAGE WILL BE PROVIDED LATER IF NECESSARY.

NOTE 2:
LSLL VES.S TO BE LOCATED AS LOW AS POSSIBLE

Existing Equipment

CV 23

CP 12

CP 223

CV 32

DESIGN TEMPERATURE: 115°C
DESIGN DISCHARGE PRESSURE: 50 BAR
DESIGN FLOWRATE: 51 m³/h
DESIGN DISCHARGE PRESSURE: 154 BAR
DESIGN TEMPERATURE: 20°C






PI 09.000 5036

TC P2 EXTENSION

APPROVED FOR
HOOK-UP

FRIGGA FIELD

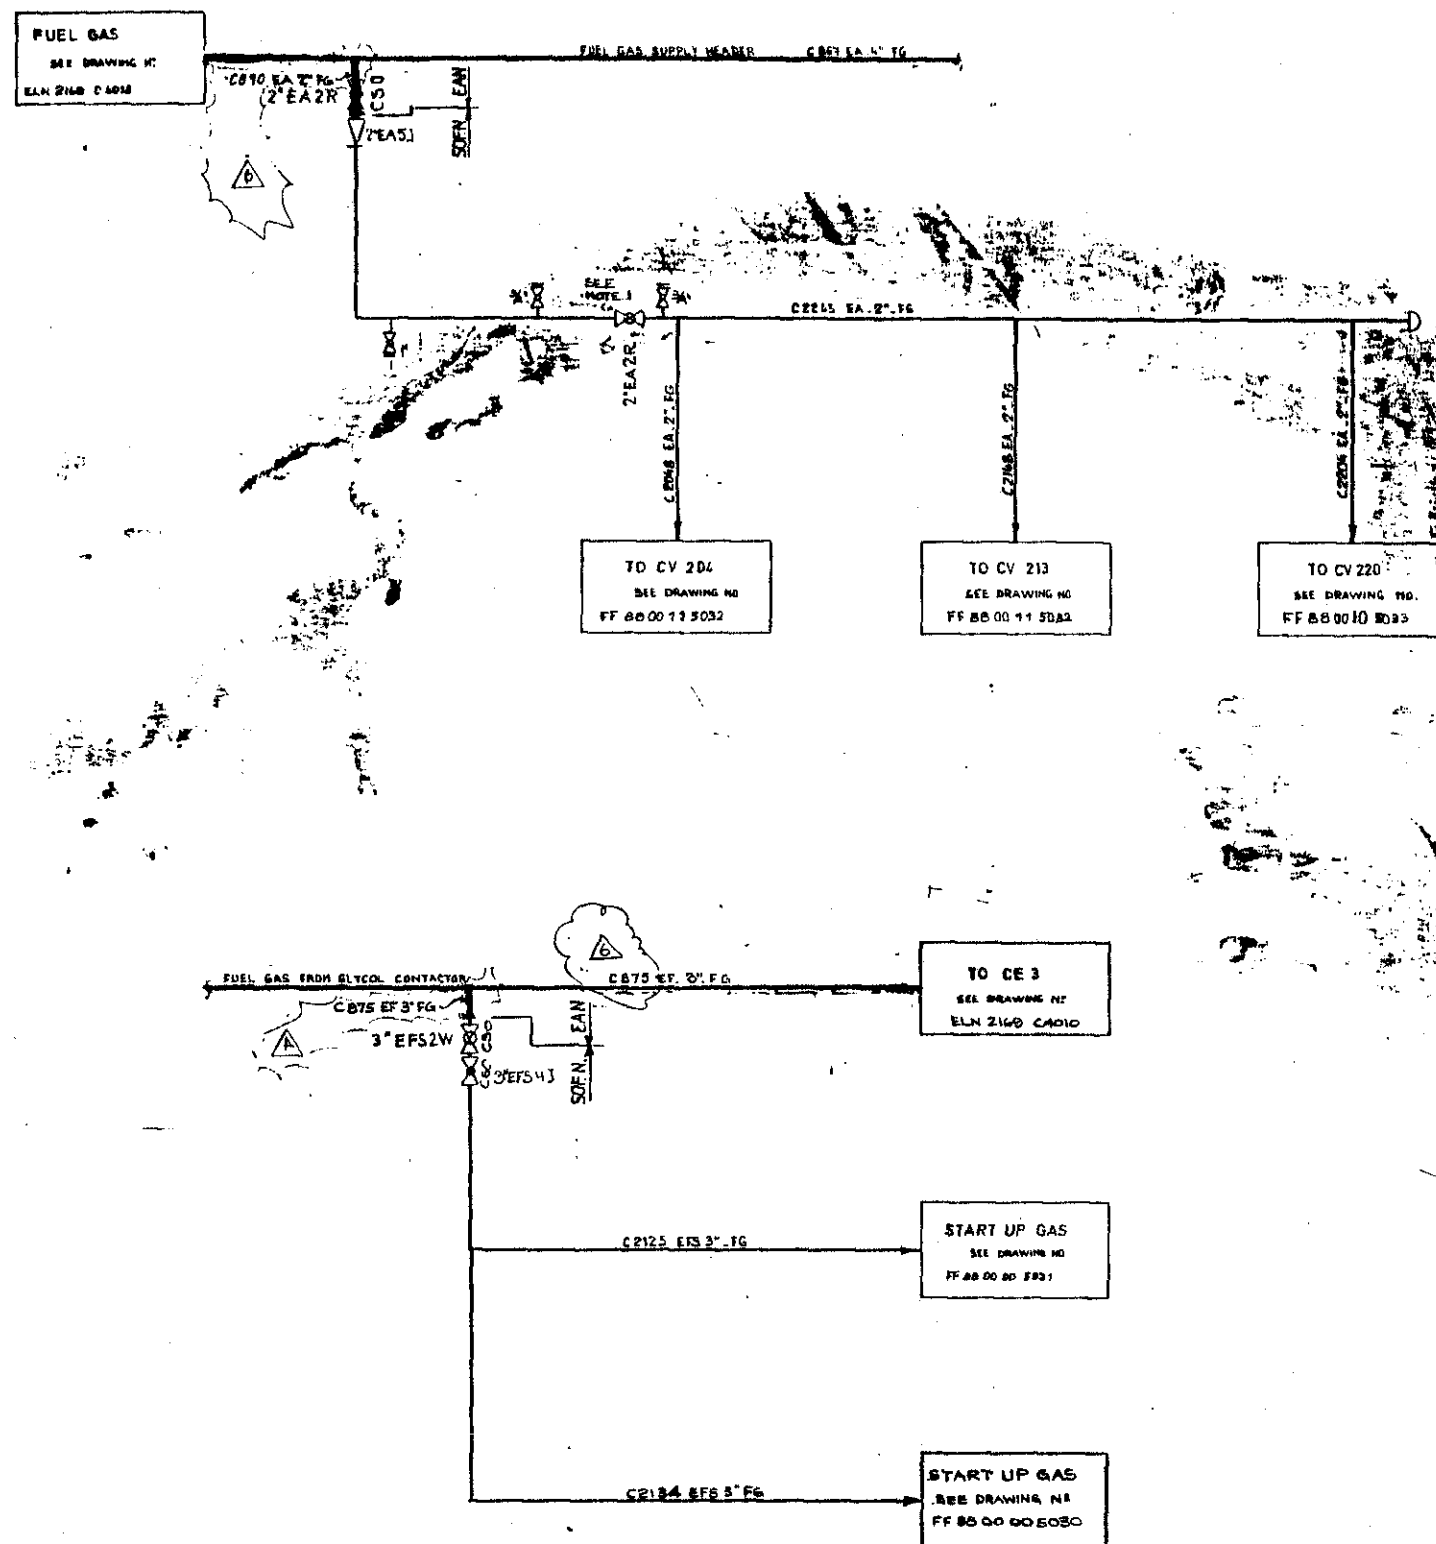

NOTES
1. VALVE TO BE INSTALLED CLOSE TO PANCAKE

EXISTING EQUIPMENT

oil equitane norge a/s
APPROVED FOR
HOOK-UP

5	REVISED AS BUILT			
6	REVISED HOOK-UP ISSUE			
4	ISSUE FINAL OPERATING			
3	ISSUE HADNED REPAIR APPROVAL			
2	ISSUE REVISED AS NOTED			
1	ISSUE ISSUED FOR APPROVAL			
0	ISSUE FIRST ISSUE			
REV	DATE	DESCRIPTION	BY	APP

oil equitane norge a/s
P1 09:000.5040

TCP2 EXTENSION

oil equitane norge a/s

AI TCP-2 FUEL GAS


N.E.F AND ODIN

TREATMENT


Fuel Gas System

FRIGG FIELD



FF 88 00 025040

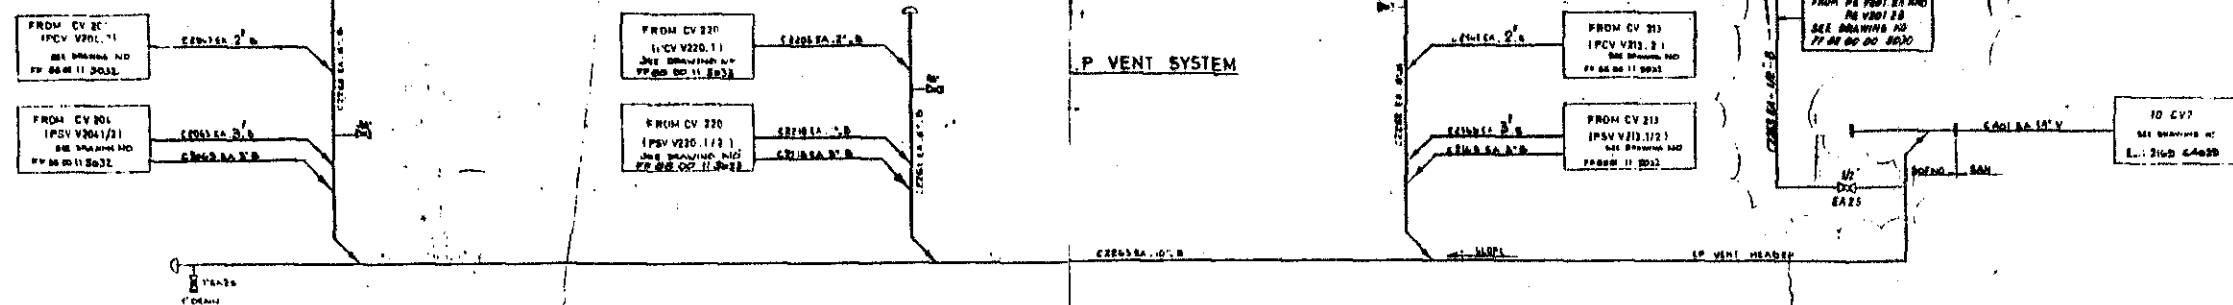

HP RELIEF SYSTEM

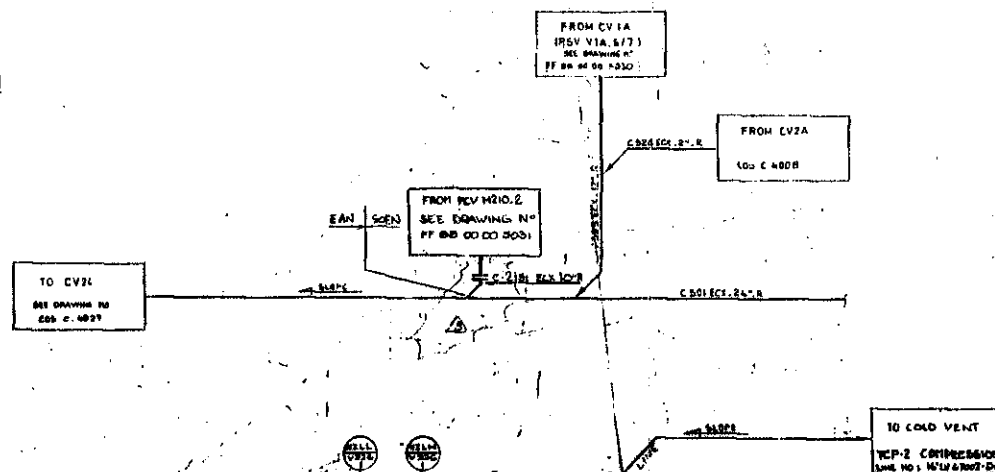

LT RELIEF SYSTEM

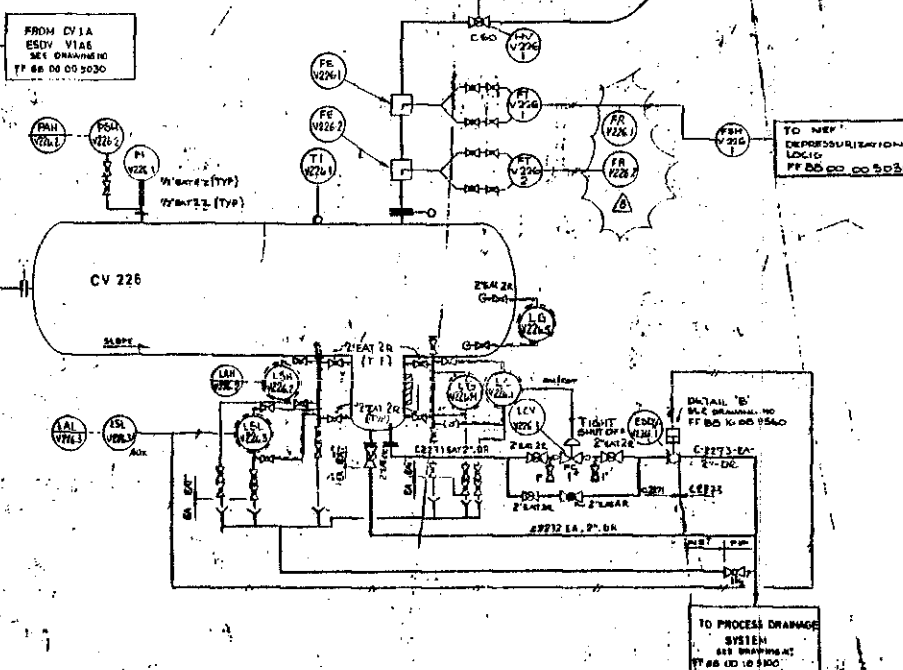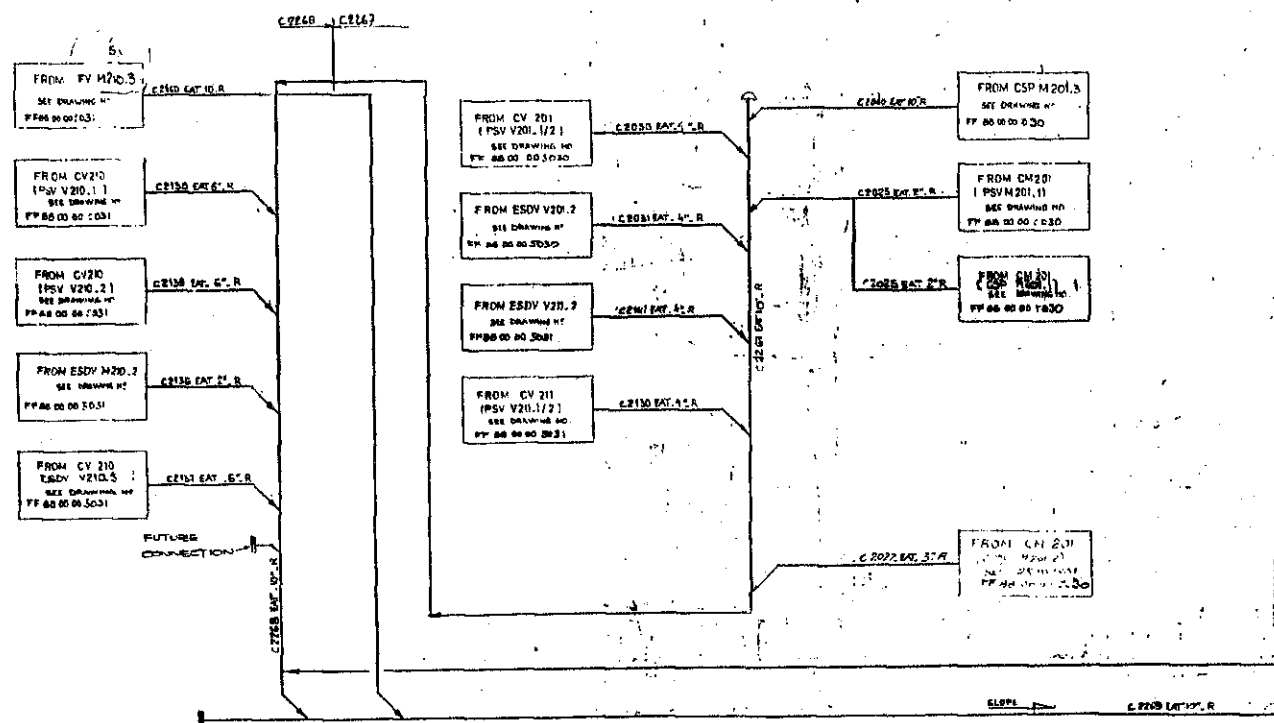


CV 226 LT RELIEF SCRUBBER


1	AS BUILT		
2	REVISED		
3	REVISED		
APPROVED FOR
HOOK-UP

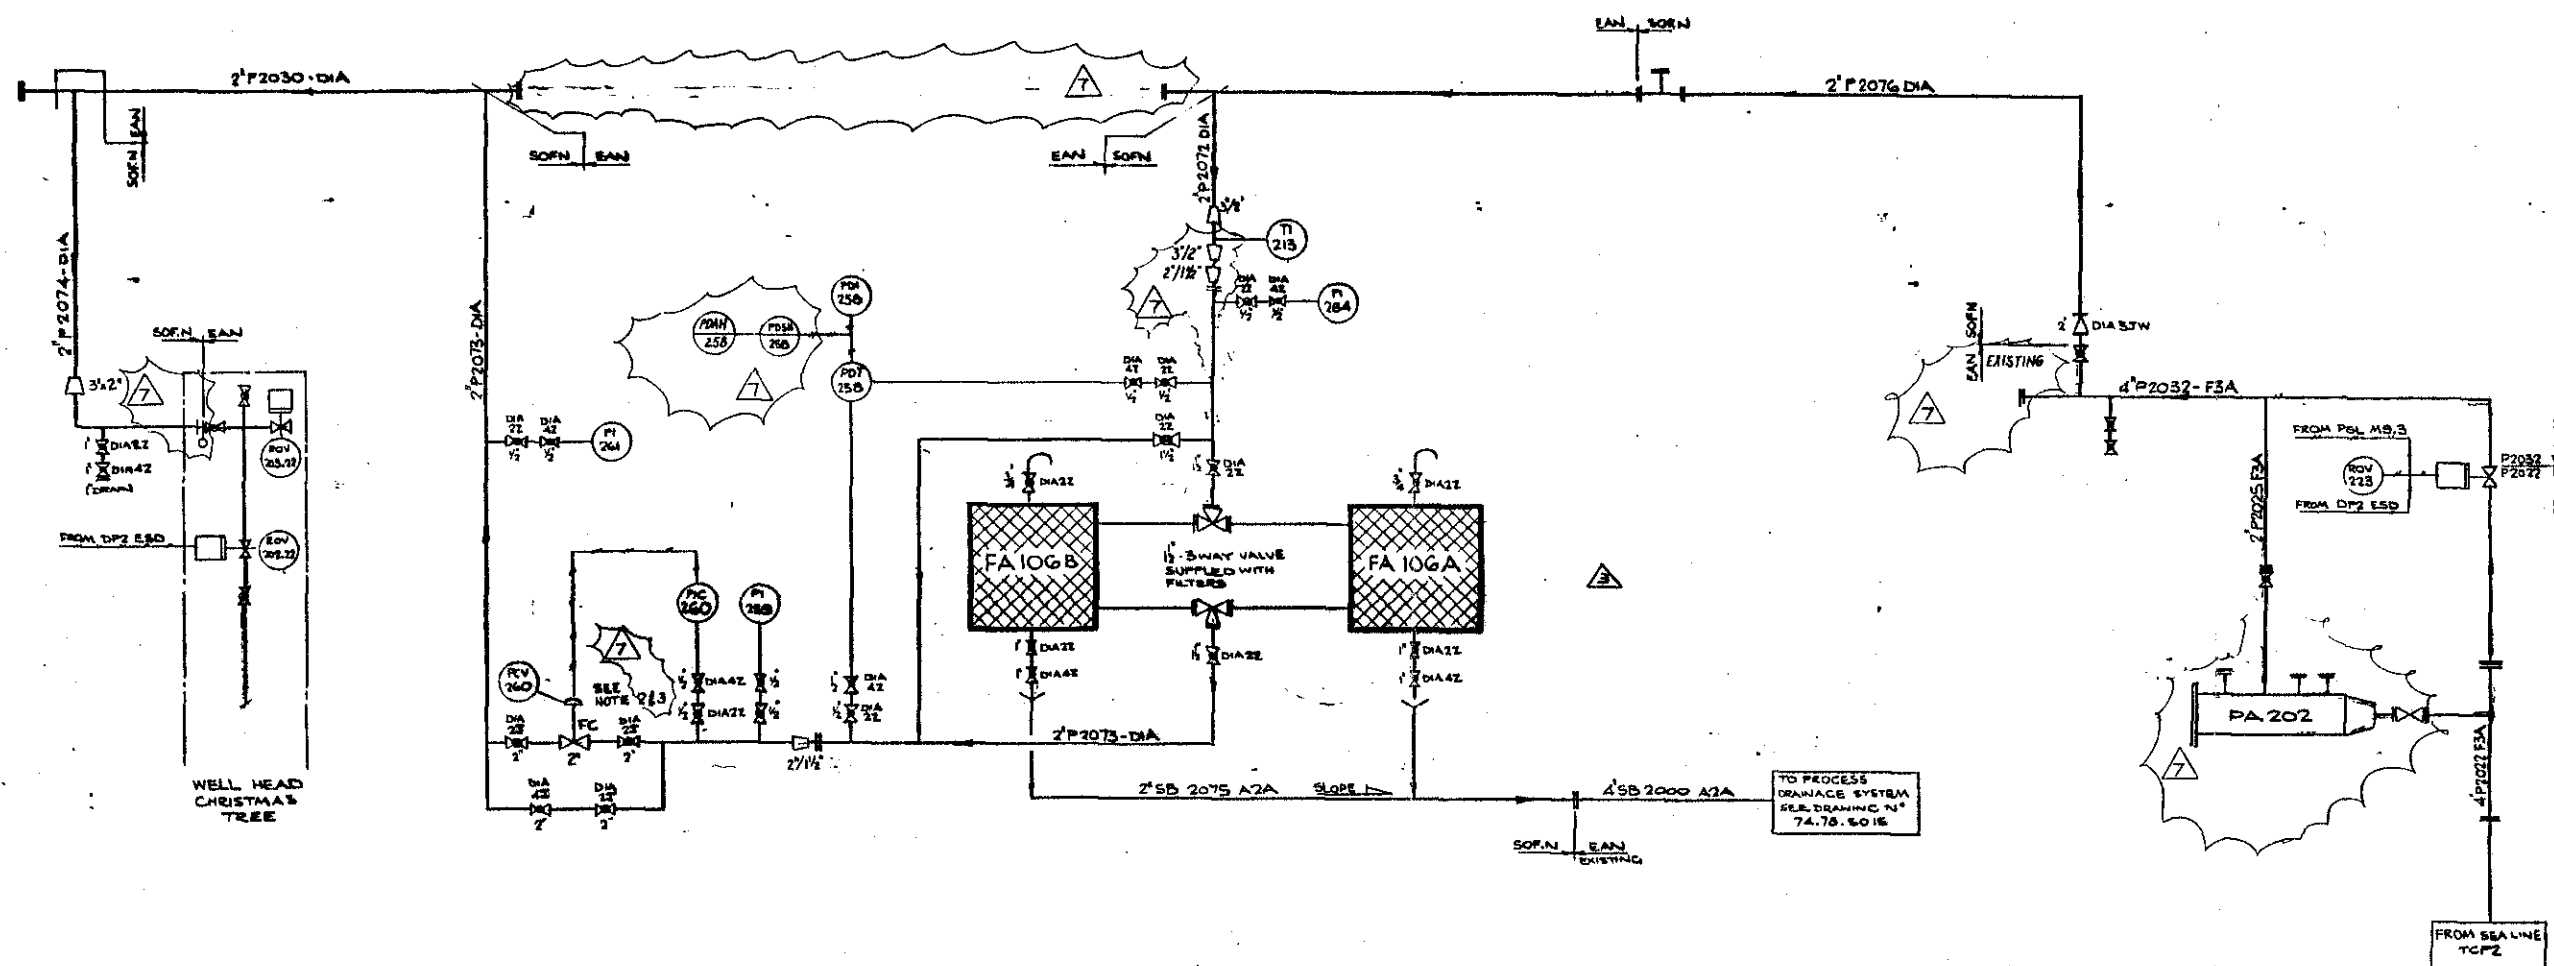

FA 10GA & B

METHANOLATED WATER FILTERS
 DESIGN TEMPERATURE ~ 30°C
 DESIGN PRESSURE ~ MAX. 16 Bar a.
 ~ MIN. 0.008 Bar a.
 OPERATING TEMPERATURE ~ 5°C
 OPERATING PRESSURE ~ 3 Bar a.

EXISTING EQUIPMENT TO BE KEPT.

NOTE 1: FOR SPECIFICATION OF VALVES SEE
 LUMMA'S PIPING MATERIAL SPEC.
 NOTE 2: PCV 260 AND 2" BY-PASS LINE TO BE
 LOCATED AS CLOSE AS POSSIBLE
 TO THE INJECTION WELL.

NOTE 3: AIR SUPPLY TO PCV 260
 REF. ISOMETRIC DRAWING FF 00 20 01 2077


etf aquitaine norge a/s
 APPROVED FOR
 HOOK-UP

REV.	DATE	DESCRIPTION	BY	CHK.	DATE
7	06.08.83	AS BUILT			
6	04.05.81	HOOK-UP ISSUE			
5	03.08.81	FINAL UPDATING LINE 2'552-7542A WAS 1"			
4	06.08.82	REVISED TO EAN COMMENTS			
3	04.08.82	REDRAWN 3 WAY VALVE TO FILTERS ADDED VALVE REF. N° ADDED SERVICE AIR DELETED			
2	01.01.81	REVISED AS NOTED			
1	19.04.81	ISSUED FOR APPROVAL			
0	01.01.81	First Issue			

etf aquitaine norge a/s DRAWG. NO: P1.09.000 5035

TCP 2 EXTENSION

AI	DP2	Process
		METHANOLATED WATER
		NEF AND ODIN
		LIQUID TREATMENT
		METHANOLATED WATER
		INJECTION ON DP2
FWOG FIELD		

 













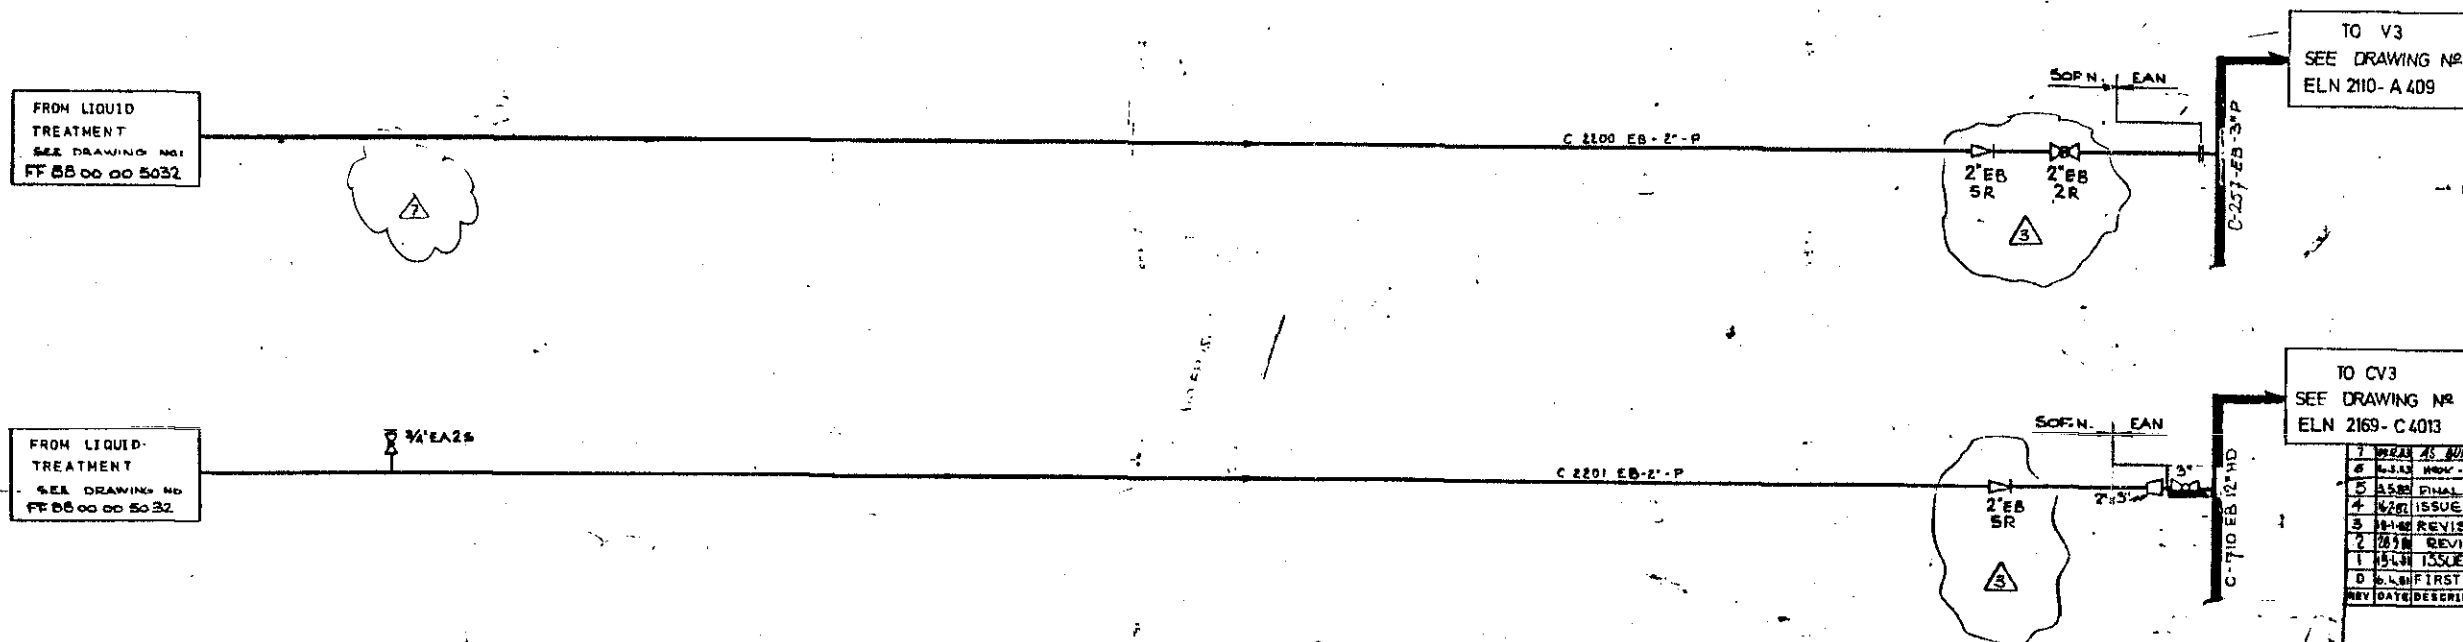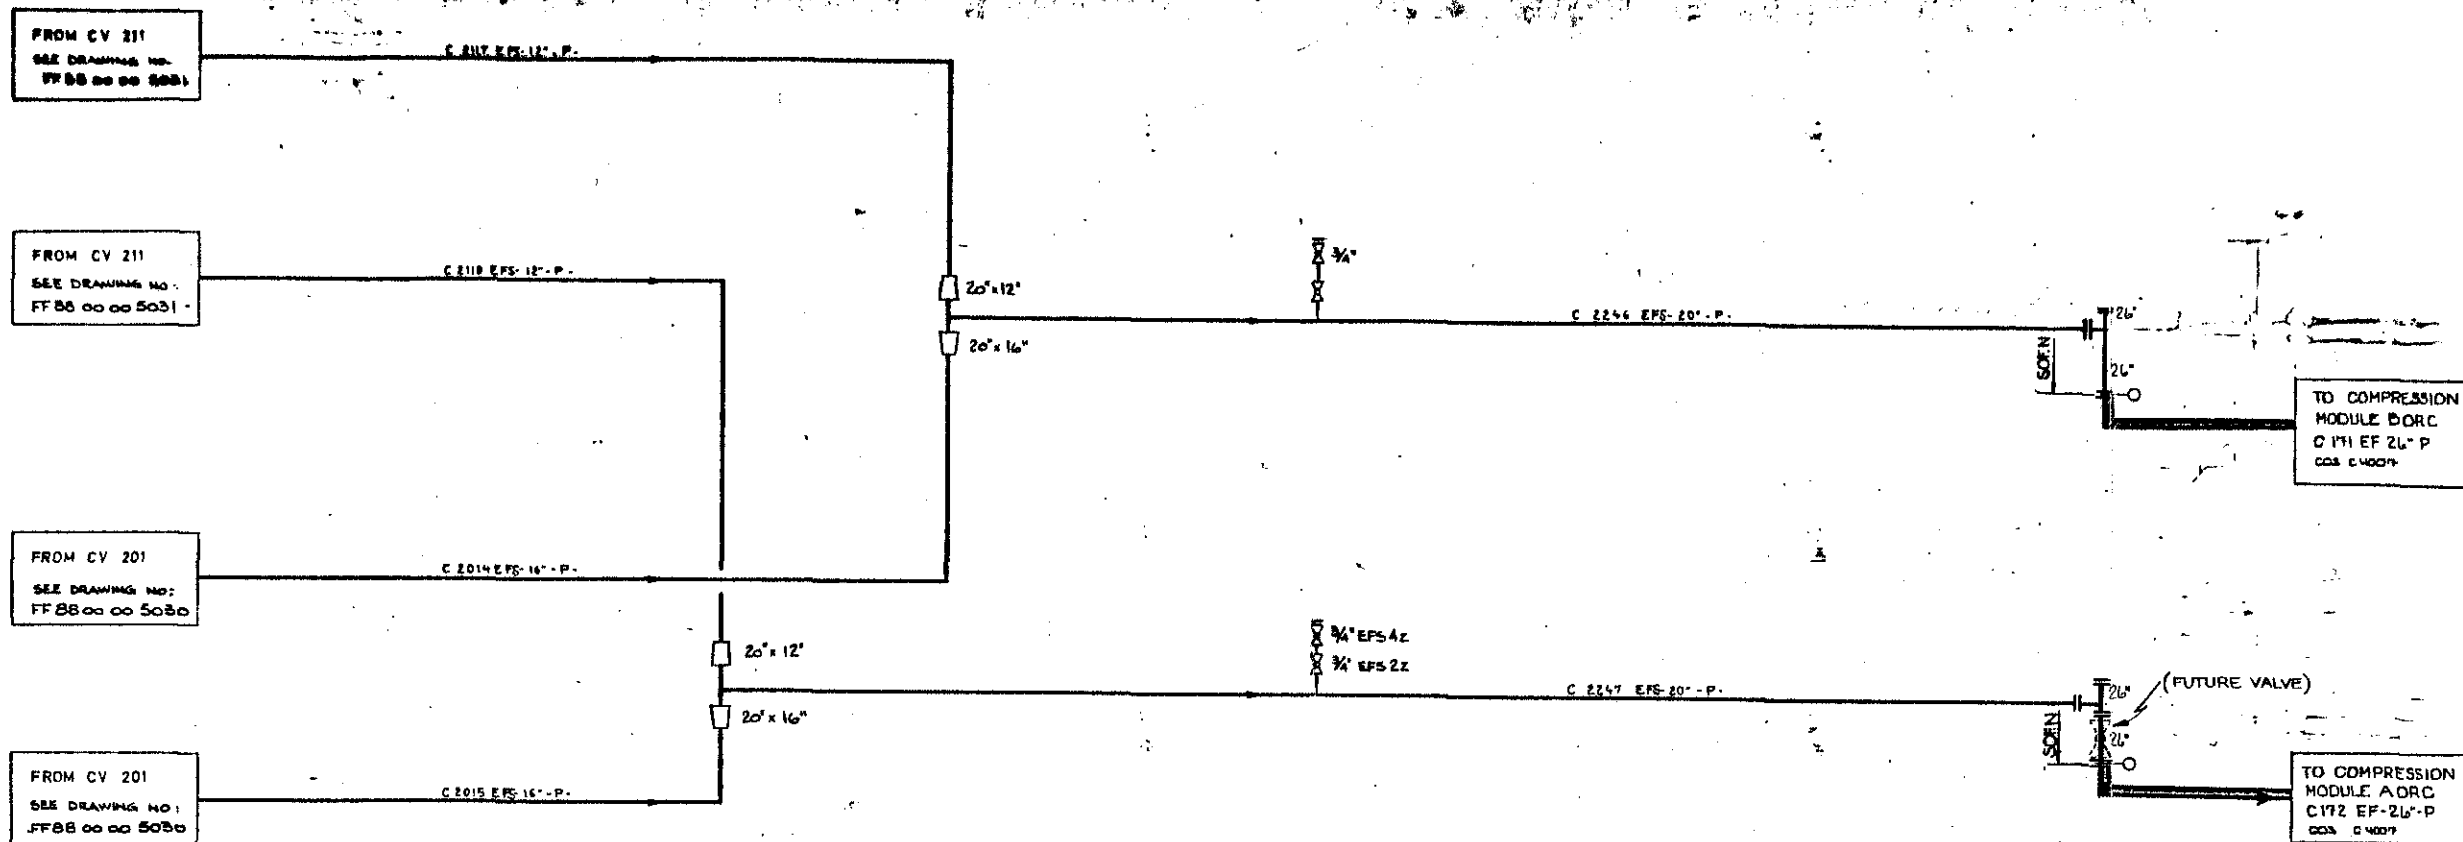

all aquatone norge a/s
APPROVED FOR
HOOK-UP

REV	DATE	DESCRIPTION	BY	APP

DRAWING NO. **PI 09.000.11300**
TPC 2 EXTENSION
 NEF AND ODIN
 TREATMENT
 condensate and gas
 Tie ins
 FRIGG FIELD
 PF 88 0000 0300

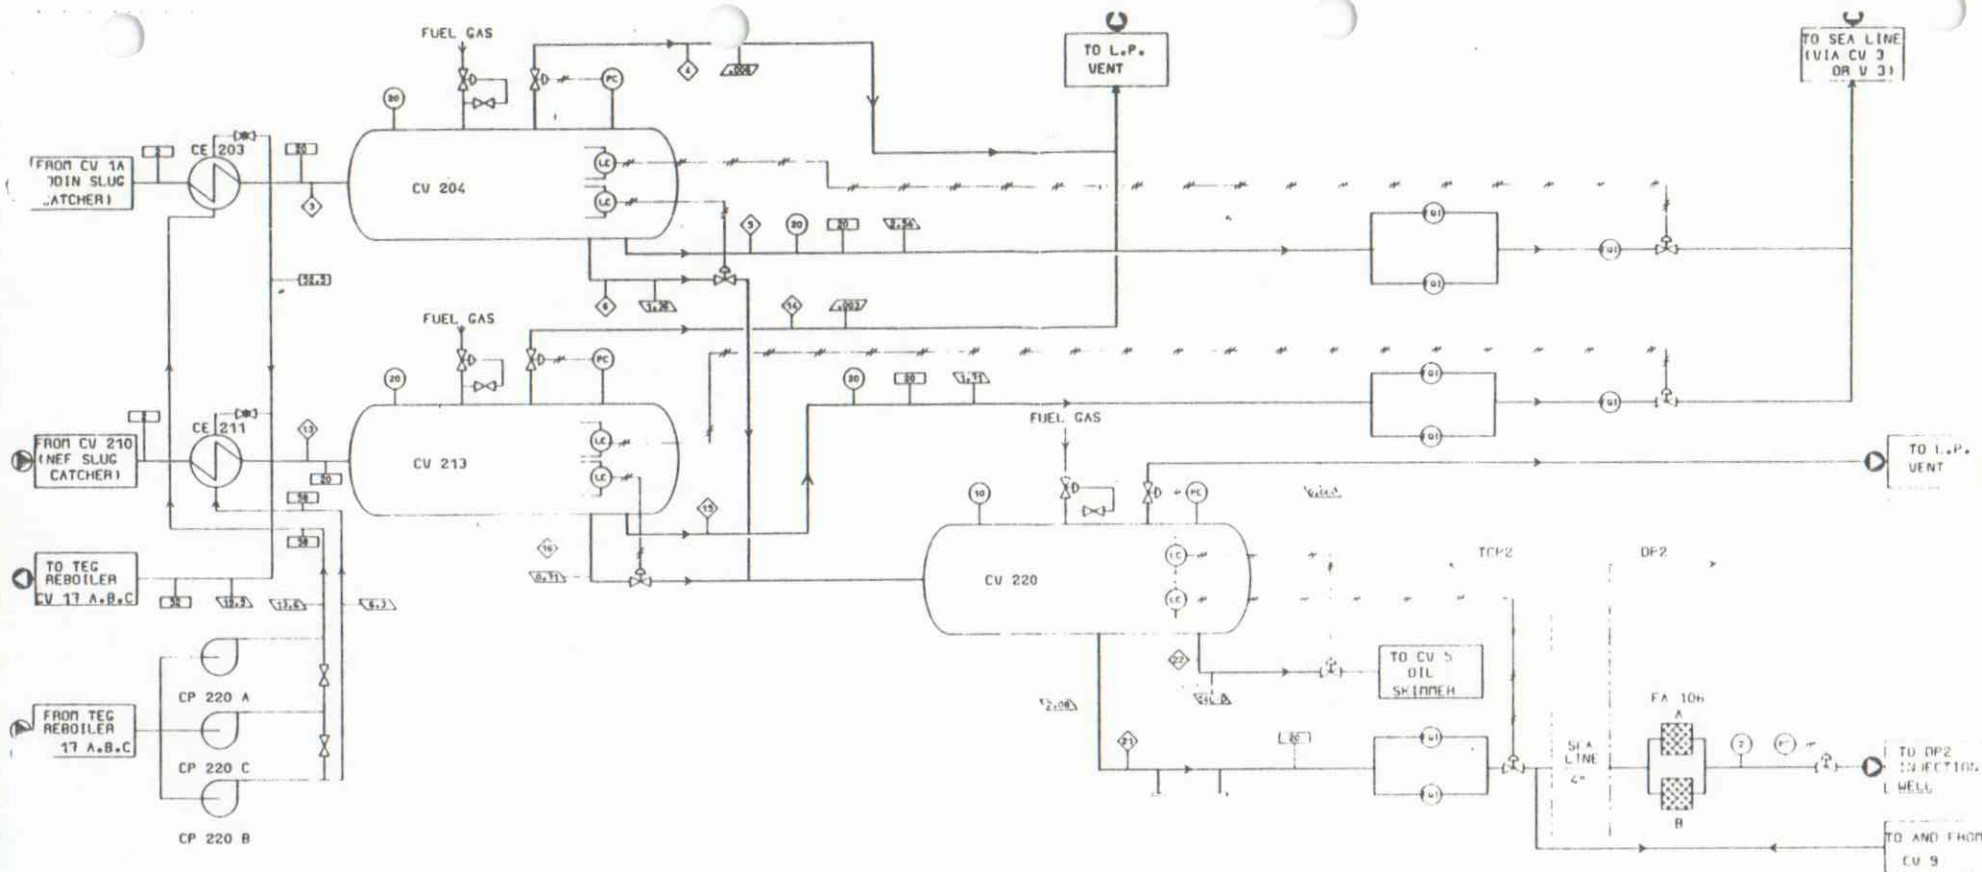

CE 203 DOIN CONDENSATE HEATER DUTY=47000 KCAL/H
 CE 211 NEF CONDENSATE HEATER DUTY=28000 KCAL/H
 CP 220 A/B/C TEG CIRCULATION PUMPS
 CV 204 DOIN CONDENSATE/METHANOL SEPARATOR
 CV 213 NEF CONDENSATE/METHANOL SEPARATOR
 CV 220 METHANOLATED WATER FLASH DRUM
 FA 100 A/B METHANOLATED WATER FILTERS

REFERENCE NUMBER
 PRESSURE BAR A
 TEMPERATURE °C
 FLOWRATE GAS M³/HR
 FLOWRATE LIQUID M³/HR

MATERIAL BALANCE											
STREAM NO.	3	4	5	6	13	14	15	16	21	22	
DESCRIPTION	CE 203 EFFLUENT	GAS FROM CV 204	LIQUID FROM CV 204 TO SEA LINE	LIQUID FROM CV 204 TO CV 213	CE 211 EFFLUENT	GAS FROM CV 213	LIQUID FROM CV 213 TO SEA LINE	LIQUID FROM CV 213 TO CV 220	TO DP2 6 + 16	LIQUID MC TO CV5 (1+1+1-31)	
PHASE	M	V	L	L	M	V	L	L	L	L	
COMPONENT, KG/MOLE (HR)											
N ₂	0.040	0.040			0.020	0.020					
CO ₂	0.010	0.060	0.010		0.040	0.030	0.010				
C ₁	10.250	3.090	3.110		5.060	5.110	0.890			0.100	
C ₂	1.080	0.630	0.390		1.140	0.580	0.560			0.100	
C ₃	0.030	0.010	0.020		0.040	0.010	0.030				
C ₄	0.040	0.010	0.030		0.020	0.010	0.010				
C ₅	0.110	0.100	0.100		0.010	0.010	0.010				
C ₆	0.030	0.010	0.030		0.030	0.030	0.030				
C ₇	0.040		0.040		0.230		0.230				
C ₈	0.120		0.120		0.560		0.560			0.100	
C ₉	0.220		0.220		0.560		0.560			0.200	
C ₁₀	0.110		0.110		0.560		0.560			0.200	
WATER	22.020		2.110	3.110	21.250	21.280	2.650	8.910	18.820	8.000	
METHANOL	0.280			10.130	6.300			8.200	18.510		
TOTAL	83.480	9.210	11.900	61.670	48.290	3.820	8.890	22.380	22.250	2.500	
ACT DENSITY KG/MP	14.820	12.500	970.000			120.800	1.100	970.000	970.000	141.000	
ACTUAL M ³ /HR	11.640	2.340	3.260			6.800	1.110	0.110	8.080	0.370	
COMPRESS. FACTOR Z		0.958				0.955					

NOTE: THIS PROCESS FLOW SHEET CORRESPONDS TO DOIN AND NEF PRODUCING WITHOUT WATER DRAIN

ISSUED FOR APPROVAL	DATE	BY
DESIGNED BY	DATE	BY
CHECKED BY	DATE	BY
APPROVED BY	DATE	BY
PROJECT NO.	TCP 2 EXTENSION	
PROCESS FLOW SHEET	LIQUID TREATMENT	
FRIGG FIELD	AR 0000 5101 15. 17	

APPENDIX 4

SAFETY ANALYSIS TABLE (SAT)

8	7	5	4	3	2	
ITEM CM 201		SERVICE ODIN PIG RECEIVER		FLOW DIAGRAM REFERENCE FF 88 00 00 503		REV. 8	
F E D C B A	UNDESIRABLE EVENT	CAUSE	DETECTABLE CONDITION AT COMPONENT	PROTECTION		COMMENTS	
				PRIMARY	SECONDARY	
	OVERPRESSURE	BLOCKED OUTLET	HIGH PRESSURE		PSV M201.1	<p>OVERPRESSURE NOT POSSIBLE SINCE MAWP IS HIGHER THAN MSWHP.</p> <p>NO OTHER PROTECTION REQUIRED SINCE THE SYSTEM IS ONLY IN SERVICE DURING PIGGING OF THE SEA LINE.</p>	
<table border="1" style="width:100%; border-collapse: collapse;"> <tr> <th style="width:5%;">REV. NO.</th> <th style="width:25%;">REVISION</th> <th style="width:10%;">DATE</th> <th style="width:5%;">BY</th> <th style="width:5%;">APPR.</th> <th style="width:10%;">APPR. BY CLIENT</th> </tr> <tr> <td>00</td> <td>FIRST ISSUE</td> <td>26/03/81</td> <td>JIN</td> <td>TE</td> <td></td> </tr> <tr> <td>01</td> <td>REVISED</td> <td>13/06/81</td> <td>JIN</td> <td>JE</td> <td></td> </tr> <tr><td> </td><td> </td><td> </td><td> </td><td> </td><td> </td></tr> <tr><td> </td><td> </td><td> </td><td> </td><td> </td><td> </td></tr> <tr><td> </td><td> </td><td> </td><td> </td><td> </td><td> </td></tr> <tr><td> </td><td> </td><td> </td><td> </td><td> </td><td> </td></tr> <tr><td> </td><td> </td><td> </td><td> </td><td> </td><td> </td></tr> <tr><td> </td><td> </td><td> </td><td> </td><td> </td><td> </td></tr> <tr><td> </td><td> </td><td> </td><td> </td><td> </td><td> </td></tr> <tr><td> </td><td> </td><td> </td><td> </td><td> </td><td> </td></tr> </table>				REV. NO.	REVISION	DATE	BY	APPR.	APPR. BY CLIENT	00	FIRST ISSUE	26/03/81	JIN	TE		01	REVISED	13/06/81	JIN	JE																																																		<table border="1" style="width:100%; border-collapse: collapse;"> <tr> <td colspan="4">CLIENT elf aquitaine norge a/s P.O.Box 168 - 4001 Stavanger</td> <td colspan="2" style="text-align: right;">FRIGG FIELD</td> </tr> <tr> <td style="width:15%;">DATE 26. 03/81</td> <td style="width:15%;">CONSTR. JIN</td> <td style="width:15%;">APPR</td> <td style="width:15%;">SCALE</td> <td colspan="2" rowspan="3" style="text-align: center;"> sofresid norge a.s </td> </tr> <tr> <td colspan="4" rowspan="2"> TITLE SAFETY ANALYSIS TABLE (SAT) <u>TCP 2 EXTENSION</u> </td> </tr> <tr> </tr> <tr> <td colspan="4"> DRWG NO CH-FF 88 00 00 4142 Sheet 1/ 28 </td> <td colspan="2"></td> </tr> </table>		CLIENT elf aquitaine norge a/s P.O.Box 168 - 4001 Stavanger				FRIGG FIELD		DATE 26. 03/81	CONSTR. JIN	APPR	SCALE	 sofresid norge a.s		TITLE SAFETY ANALYSIS TABLE (SAT) <u>TCP 2 EXTENSION</u>				DRWG NO CH-FF 88 00 00 4142 Sheet 1/ 28					
REV. NO.	REVISION	DATE	BY	APPR.	APPR. BY CLIENT	
00	FIRST ISSUE	26/03/81	JIN	TE	
01	REVISED	13/06/81	JIN	JE	
CLIENT elf aquitaine norge a/s P.O.Box 168 - 4001 Stavanger				FRIGG FIELD	
DATE 26. 03/81	CONSTR. JIN	APPR	SCALE	 sofresid norge a.s	
TITLE SAFETY ANALYSIS TABLE (SAT) <u>TCP 2 EXTENSION</u>	
DRWG NO CH-FF 88 00 00 4142 Sheet 1/ 28	

ITEM NO

CV 1A

SERVICE


ODIN SLUG CATCHER

FLOW DIAGRAM REFERENCE

FF 88 00 00 5030

REV. 8

F E D C B	UNDESIRABLE EVENT	CAUSE	DEVIABLE CONDITION AT COMPONENT	PROTECTION		COMMENTS
				PRIMARY	SECONDARY	
	OVERPRESSURE	BLOCKED OUTLET	HIGH PRESSURE		PSV V1A.6+7	OVERPRESSURE NOT POSSIBLE SINCE MAWP IS HIGHER THAN MSWHP.
	OVERFLOW	LIQUID INFLOW EXCEEDS LIQUID OUTFLOW LEVEL CONTROL FAILURE	HIGH LIQUID LEVEL	LSHH V1A.8A	LSHH V201.4 (DOWNSTREAM)	
	GAS BLOWBY	LEVEL CONTROL FAILURE	LOW LIQUID LEVEL	LSLL V1A.7A	PSV V204 1+2 PSH V204.5 (DOWNSTREAM)	SECONDARY PROTECTION PSH V3.8, PSV V3.5 AND PSV V3.6 AT CV3 (EXISTING EQUIPMENT DOWNSTREAM)
	LEAK	DETERIORATION RUPTURE ACCIDENT	LOW PRESSURE AND BACKFLOW	PSL V1A.2 FSV	ESS	

REV. NO.	REVISION	DATE	BY	APPR.	APPR. BY CLIENT	CLIENT			
00	FIRST ISSUE	23/03/81	JIN	<i>JIN</i>		ell aquitaine norge a/s P.O.Box 168 4001 Stavanger			
01	ISSUED FOR APPROVAL	02/04/81	JIN	<i>JIN</i>					
02	REVISED	13/06/81	JIN	<i>JIN</i>		DATE	CONSTR	APPR	SCALE
03	REVISED AS NOTED	25/08/81	JIN	<i>JIN</i>		23/03/81	JIN		
						TITLE			
						SAFETY ANALYSIS TABLE (SAT)			
						TCP 2 EXTENSION			
						 sofresid norge a/s			
						CH 05 1430			
						ORWG NO			
						CI-FF 88 00 00 4142			
						Sheet 2/28			

8

7

6

5

4

3

2

1

F

E

D

C

B

A

F E D C B A	DESIRABLE EVENT	CAUSE	DETECTABLE LOCATION AT COMPONENT	PROTECTION		COMMENTS
				PRIMARY	SECONDARY	
	OVERPRESSURE	BLOCKED OUTLET	HIGH PRESSURE		PSV V210.1+2	OVERPRESSURE NOT POSSIBLE SINCE MAWP IS HIGHER THAN MSWHP.
	OVERFLOW	LIQUID INFLOW EXCEEDS LIQUID OUTFLOW LEVEL CONTROL FAILURE	HIGH LIQUID LEVEL	LSHH V210.8	LSHH V211.4 (DOWNSTREAM)	
	GAS BLOWBY	LEVEL CONTROL FAILURE	LOW LIQUID LEVEL	LSLL V210.7	PSH V213.5 PSV V213 1+2 (DOWNSTREAM)	SECONDARY PROTECTION PSH V3.8 PSV V3.5 AND PSV V3.6 AT CV3 (EXISTING EQUIPMENT DOWNSTREAM)
	LEAK	DETERIORATION RUPTURE ACCIDENT	LOW PRESSURE AND BACKFLOW	PSL V210.1 FSV	ESS	
	REV. NO.	REVISION	DATE	BY	APPR.	APPR. BY CLIENT
	00	FIRST ISSUE	23/03/81	JIN	JIN	elf aquitaine norge a.s. P.O. Box 168 4001 Stavanger
	01	ISSUED FOR APPROVAL	02/04/81	JIN	JIN	FRIGG FIELD
	02	REVISED	13/06/81	JIN	JIN	DATE 23/03/81 CONSTR JIN
	03	REVISED AS NOTED	25/08/81	JIN	JIN	APPR SCALE
						solresid norge a.s.
						SAFETY ANALYSIS TABLE (SAT)
						TCP 2 EXTENSION
						CH 05 1430
						DRWG NO
						CH-FF 88 00 00 4142
						Sheet 4/28

solresid norge a.s

CH 05 1430

DRWG NO

CU-FF 88 00 00 4142

Sheet 5/28

ITEM NO. CE 203

SERVIC



ODIN CONDENSATE HEATER

FLOW DIAGRAM

REFERENCE

FF 88 00 11 5032

Rev. 7

UNDESIRABLE EVENT	CAUSE	D. TABLE CONDITION AT COMPONENT	PROTECTION		COMMENTS
			PRIMARY	SECONDARY	
OVERPRESSURE	BLOCKED OUTLET (CONDENSATE + METHANOLATED WATER) 	HIGH PRESSURE	PSH V204.5 (DOWNSTREAM)	PSV V204. 1+2 (DOWNSTREAM)	PROTECTION NOT REQUIRED SINCE MAX. PUMP DISCHARGE PRESS IS LESS THAN PIPING DESIGN PRESSURE. PROTECTION NOT REQUIRED SINCE THE EXISTING GLYCOL LINE TO CV17 A/B/C IS USED AS RELIEF SYSTEM.
OVERPRESSURE	BLOCKED OUTLET (GLYCOL)	HIGH PRESSURE			
LEAK (INTERNAL)	DETERIORATION RUPTURE	HIGH PRESSURE ON SHELL SIDE			
LEAK (EXTERNAL)	DETERIORATION RUPTURE ACCIDENT	LOW PRESSURE	PSL V204.3 (CONDENSATE LINE DOWNSTREAM) PSL-P220A.1/ PSL-P220C.1 (GLYCOL LINE UPSTREAM) TSH-E203.5	ESS 	NO SECONDARY PROTECTION REQUIRED SINCE MAX. BUILT UP PRESSURE IS BELOW DESIGN PRESSURE OF TUBES AND PIPING.
EXCESS TEMPERATURE	EXCESS HEAT INPUT	HIGH TEMP			

REV. NO.

REVISION

DATE

BY

APPR.

APPR. BY CLIENT

CLIENT

elf aquitaine norge a/s P.O.Box 168 - 4001 Stavanger

FRIGG FIELD

00

FIRST ISSUE

23/03/81

JIN

TEL

01

ISSUED FOR APPROVAL

02/04/81

JIN

TEL

02

REVISED

13/06/81

JIN

RF

03

REVISED AS NOTED

25/08/81

JIN

RF

DATE

CONSTR.

APPR.

SCALE

TITLE

SAFETY ANALYSIS TABLE
(SAT)

TCP 2 EXTENSION




sofresid norge a.s


CH 05 1430

DRWG NO.

CH-FF 88 00 00 4142

Sheet 6/ 28

UNDESIRABLE EVENT	CAUSE	DETECTABLE CONDITION AT COMPONENT	PROTECTION		COMMENTS
			PRIMARY	SECONDARY	
OVERPRESSURE	BLOCKED OUTLET 	HIGH PRESSURE	PSH V213.5 (DOWNSTREAM)	PSV V213 1+2 (DOWNSTREAM)	PROTECTION NOT REQUIRED SINCE MAX. PUMP DISCHARGE PRESSURE IS LESS THAN PIPING DESIGN PRESSURE. PROTECTION NOT REQUIRED SINCE THE EXISTING GLYCOL LINE TO CV17 A/B/C IS USED AS RELIEF SYSTEM.
OVERPRESSURE	BLOCKED OUTLET (GLYCOL)	HIGH PRESSURE			
LEAK (INTERNAL)	DETERIORATION	HIGH PRESSURE ON SHELL SIDE			
	RUPTURE				
LEAK (EXTERNAL)	DETERIORATION	LOW PRESSURE	PSL V213.3 (CONDENSATE LINE DOWNSTREAM) PSL P220B.1 / PSL P220C.1	ESS	NO SECONDARY PROTECTION REQUIRED SINCE MAX. BUILT UP PRESSURE IS BELOW DESIGN PRESSURE OF TUBES AND PIPING.
	RUPTURE				
	ACCIDENT				
EXCESS TEMPERATURE	EXCESS HEAT INPUT	HIGH TEMP	(GLYCOL LINE UPSTREAM) TSH-E211.5		

REV. NO.	REVISION	DATE	BY	APPR.	APPR. BY CLIENT	CLIENT			
00	FIRST ISSUE	23/03/81	JIN	<i>JIN</i>		elf aquitaine norge a/s P.O.Box 168 - 4001 Stavanger			
01	ISSUED FOR APPROVAL	02/04/81	JIN	<i>JIN</i>		FRIGG FIELD			
02	REVISED	13/06/81	JIN	<i>AP</i>		DATE	CONSTR.	APPR.	SCALE
03	REVISED AS NOTED	25/08/81	JIN	<i>AP</i>		23/03/81	JIN		
						TITLE			
						SAFETY ANALYSIS TABLE (SAT)			
						TCP 2 EXTENSION			
						 sofresid norge a/s CH 05 1430 DRWG. NO CH- FF 88 00 00 4142 Sheet 7/28			

EM NO. CV 204

SERVICE

N CONDENSATE/METHANOL

FLOW DIAGRAM

REFERENCE

FF 88 00 11 5032

REV

DESIRABLE EVENT	CAUSE	DEVIATION TABLE CONDITION AT COMPONENT	PROTECTION		COMMENTS
			PRIMARY	SECONDARY	
OVERPRESSURE	INFLOW EXCEEDS OUTFLOW BLOCKED OUTLET	HIGH PRESSURE	PSH V204.5	PSV V204.1+2	SECONDARY PROTECTION AT EXISTING LP VENT SCRUBBER (ALARM ONLY)
OVERFLOW	LIQUID INFLOW EXCEEDS LIQUID OUTFLOW LEVEL CONTROL FAILURE	HIGH LIQUID LEVEL	LSH V204.5	LSH V 7.4	
GAS BLOWBY (CONDENSATE LINE)	LEVEL CONTROL FAILURE	LOW LIQUID LEVEL	LSL V204.2	PSV V3.5 and V3.6	SECONDARY PROTECTION AT DOWNSTREAM COMPONENT V3 OR CV3 (EXISTING EQUIPMENT)
GAS BLOWBY (WATER LINE)	LEVEL CONTROL FAILURE	LOW LIQUID LEVEL	LSL V204.2	PSH V220.3 PSV V220.1/2 (DOWNSTREAM)	
LEAK	DETERIORATION RUPTURE ACCIDENT	LOW PRESSURE AND BACKFLOW	PSV PSL V204.3	ESS	
EXCESS TEMPERATURE	EXCESS HEAT INPUT	HIGH PROCESS TEMPERATURE	TSH E203.5		EXCESS TEMP ONLY POSSIBLE IN CASE OF BLOCKED OUTLETS. ANY PRESSURE BUILT UP WILL BE RELEASED THROUGH PSV V204.1+2.

REV. NO.	REVISION	DATE	BY	APPR.	APPR. BY CLIENT	CLIENT			
00	FIRST ISSUE	23/03/81	JIN	<i>JIN</i>		elf aquitaine norge a/s P.O.Box 108 - 4001 Stavanger			
01	ISSUED FOR APPROVAL	02/04/81	JIN	<i>JIN</i>		FRIGG FIELD			
02	REVISED	13/06/81	JIN	<i>BT</i>		DATE	CONSTR.	APPR.	SCALE
						3/03/81	JIN		
						TITLE			
						SAFETY ANALYSIS TABLE (SAT)			
						TCP 2 EXTENSION			
						solresid norge a.s			
						CH 05 1430			
						DRWG NO			
						CH-FF 88 00 00 4142			
						Sheet 8/28			

8

7

6


5


4

3

2

1

	DESIRABLE EVENT	CAUSE	DEF. TABLE EVALUATION AT COMPONENT	PROTECTION		COMMENTS
				PRIMARY	SECONDARY	
F	OVERPRESSURE	INFLOW EXCEEDS OUTFLOW BLOCKED OUTLET	HIGH PRESSURE	PSH V213.5	PSV V213.1+2	 SECONDARY PROTECTION AT EXISTING LP VENT SCRUBBER (ALARM ONLY) SECONDARY PROTECTION AT DOWNSTREAM COMPONENT V3 OR CV3 (EXISTING EQUIPMENT)
E	OVERFLOW	LIQUID INFLOW EXCEEDS LIQUID OUTFLOW LEVEL CONTROL FAILURE	HIGH LIQUID LEVEL	LSH V213.5	LSH V 7.4	
D	GAS BLOWBY (CONDENSATE LINE)	LEVEL CONTROL FAILURE	LOW LIQUID LEVEL	LSL V213.2	PSV V3.5 AND V3.6	
	GAS BLOWBY (WATER LINE)	LEVEL CONTROL FAILURE	LOW LIQUID LEVEL	LSL V213.2	PSH V220.3 PSV V220.1/2 (DOWNSTREAM)	
C	LEAK	DETERIORATION RUPTURE ACCIDENT	LOW PRESSURE AND BACKFLOW	FSV PSL V213.3	ESS	
B	EXCESS TEMPERATURE	EXCESS HEAT INPUT	HIGH PROCESS TEMPERATURE	TSH E211.5		EXCESS TEMP ONLY POSSIBLE IN CASE OF BLOCKED OUTLETS. ANY PRESSURE BUILT UP WILL BE RELEASED THROUGH PSV V213.1+2.

REV. NO.	REVISION	DATE	BY	APPR.	APPR. BY CLIENT	CLIENT			
00	FIRST ISSUE	23/03/81	JIN	<i>JIN</i>		elf aquitaine norge a/s P.O.Box 168 - 4001 Stavanger			
01	ISSUED FOR APPROVAL	02/04/81	JIN	<i>JIN</i>		FRIGG FIELD			
02	REVISED	13/06/81	JIN	<i>JIN</i>		DATE	CONSTR.	APPR.	SCALE
03	REVISED AS NOTED	25/08/81	JIN	<i>JIN</i>		23/03/81	JIN		
						TITLE			
						SAFETY ANALYSIS TABLE (SAT)			
						TCP 2 EXTENSION			
						 sofresid norge a.s.			
						CH 05 1430			
						DRWG NO CH-FF 88 00 00 4142 Sheet 9/26			

8

7

6

5

4


3

2

1

F E D C B	UNDESIRABLE EVENT	CAUSE	DETECTABLE CONDITION AT COMPONENT	PROTECTION		COMMENTS
				PRIMARY	SECONDARY	
	OVERPRESSURE	INFLOW EXCEEDS OUTFLOW BLOCKED OUTLET	HIGH PRESSURE	PSH V220.3	PSV V220.1+2	
	OVERFLOW	LIQUID INFLOW EXCEEDS LIQUID OUTFLOW LEVEL CONTROL FAILURE	HIGH LIQUID LEVEL	LSH V220.6	LSH V 7.4	SECONDARY PROTECTION AT EXISTING LP VENT SCRUBBER (ALARM ONLY)
	GAS BLOWBY (CONDENSATE LINE)	LEVEL CONTROL FAILURE	LOW LIQUID LEVEL	LSL V220.7	PSV V5.4+5	SECONDARY PROTECTION AT DOWNSTREAM CV5 (EXISTING EQUIPMENT).
	GAS BLOWBY (METHANOLATED WATER LINE)	LEVEL CONTROL FAILURE	LOW LIQUID LEVEL	LSL V220.2		NO SECONDARY PROTECTION REQUIRED SINCE DOWNSTREAM PIPELINE DESIGN PRESSURE IS GREATER THAN ANY GAS BLOWBY PRESSURE
	LEAK	DETERIORATION RUPTURE ACCIDENT	LOW PRESSURE AND BACKFLOW	FSV PSL V220.4	ESS	

REV. NO.	REVISION	DATE	BY	APPR.	APPR. BY CLIENT	CLIENT			
00	FIRST ISSUE	23/03/81	JIN	<i>JA</i>		elf aquitaine norge a/s P.O. Box 168 - 4001 Stavanger FRIGG FIELD			
01	ISSUED FOR APPROVAL	02/04/81	JIN	<i>JA</i>					
02	REVISED	13/06/81	JIN	<i>AF</i>					
						DATE	CONSTR	APPR	SCALE
						23/03/81	JIN		
						TITLE			
						SAFETY ANALYSIS TABLE (SAT)			
						<u>TCP 2 EXTENSION</u>			



sofresid norge a.s.


CH 05 1430

DRWC NG


CH-FF 88 00 00 4142


Sheet 11/ 20


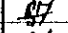
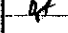

UNDESIRABLE EVENT	CAUSE	DETECTABLE CONDITION AT COMPONENT	PROTECTION		COMMENTS
			PRIMARY	SECONDARY	
OVERPRESSURE	BLOCKED OUTLET	HIGH PRESSURE	VENT+ SPARK ARRESTOR		NO OTHER PROTECTION REQUIRED SINCE THE VESSEL IS MANUALLY FILLED AND OPERATING AT ATMOSPHERIC CONDITIONS. SYSTEM NOT IN CONTINUOUS SERVICE.

REV. NO.	REVISION	DATE	BY	APPR.	APPR. BY CLIENT	CLIENT			
00	FIRST ISSUE	26/03/81	JIN	TEL		elf aquitaine norge a/s P.O.Box 168 - 4001 Stavanger FRIGG FIELD			
01	REVISED	13/06/81	JIN	BJ		DATE	CONSTR.	APPR	SCALE
						26/03/8	JIN		
						TITLE			
						SAFETY ANALYSIS TABLE (SAT)			
						TCP 2 EXTENSION			
						 solresid norge a.s CH 05 1430 DRWG. NO. CH-FF 88 00 00 4142 Sheet 12/28			

UNDESIRABLE EVENT	CAUSE	DANGER TABLE CONDITION AT COMPONENT	PROTECTION		COMMENTS
			PRIMARY	SECONDARY	
OVERPRESSURE	BLOCKED OUTLET	HIGH PRESSURE	VENT+ SPARK ARRESTOR		NO OTHER PROTECTION REQUIRED SINCE THE VESSEL IS MANUALLY FILLED AND OPERATING AT ATMOSPHERIC CONDITIONS. SYSTEM NOT IN CONTINUOUS SERVICE.


REV. NO.	REVISION	DATE	BY	APPR.	APPR. BY CLIENT	CLIENT			
00	FIRST ISSUE	26/03/81	JIN	<i>Ja</i>		elf aquitaine norge a/s P.O.Box 168 - 4001 Stevanger FRIGG FIELD			
01	REVISED	13/06/81	JIN	<i>87</i>		DATE	CONSTR.	APPR.	SCALE
						26/03/81	JIN		
						TITLE			
						SAFETY ANALYSIS TABLE (SAT)			
						TCP 2 EXTENSION			
						 sofresid norge a.s CH 05 1430 DRWG. NO. CH-FF 88 00 00 4142 Sheet 13/28			

UNDESIRABLE EVENT	CAUSE	D. TABLE CONDITION AT COMPONENT	PROTECTION		COMMENTS
			PRIMARY	SECONDARY	
OVERPRESSURE	BLOCKED DISCHARGE LINE	HIGH PRESSURE		PSV P225 A.1	NO OTHER PROTECTION REQUIRED SINCE SYSTEM IS MANUALLY OPERATED. NOT IN CONTINUOUS SERVICE.
LEAK	RUPTURE DETERIORATION ACCIDENT	LOW PRESSURE AND BACKFLOW	PSV		ONLY SMALL AMOUNTS 

REV. NO.	REVISION	DATE	BY	APPR.	APPR. BY CLIENT	CLIENT
00	FIRST ISSUE	26/03/81	JIN			elf aquitaine norge a/s P.O.Box 150 - 4001 Steinvanger FRIGG FIELD
01	REVISED	13/06/81	JIN			
02	REVISED AS NOTED	25/08/81	JIN			
						DATE 26/03/81 CONSTR. JIN APPR. SCALE
						TITLE
						SAFETY ANALYSIS TABLE (SAT) <u>TCP 2 EXTENSION</u>
						 sofresid norge a.s
						CH 05 1430
						DRWG. NO. CH-FF 88 00 00 4142 Sheet 14/28


ITEM NO. CP 225 B SERVICE INHIBITOR PUMP FLOW DIAGRA REFERENCE FF 88 00 10 5033 REV. 2

UNDESIRABLE EVENT	CAUSE	DETECTABLE CONDITION AT COMPONENT	PROTECTION		COMMENTS
			PRIMARY	SECONDARY	
OVERPRESSURE	BLOCKED DISCHARGE LINE	HIGH PRESSURE		PSV P225 B.1	NO OTHER PROTECTION REQUIRED SINCE SYSTEM IS MANUALLY OPERATED. NOT IN CONTINUOUS SERVICE.
LEAK	RUPTURE DETERIORATION ACCIDENT	LOW PRESSURE AND BACKFLOW	FSV		ONLY SMALL AMOUNTS

REV. NO.	REVISION	DATE	BY	APPR.	APPR. BY CLIENT	CLIENT elf aquitaine norge a/s P.O. Box 168 - 4001 Stavanger FRIGG FIELD			
00	FIRST ISSUE	26/03/81	JIN	<i>rec</i>		DATE 26/03/81	CONSTR. JIN	APPR.	SCALE
01	REVISED	13/06/81	JIN	<i>AB</i>		 sofresid norge a.s. CH 05 1430 DRWG. NO. CH-FF 88 00 00 4142 Sheet 15/28			
02	REVISED AS NOTED	25/08/81	JIN	<i>HA</i>					
						TITLE SAFETY ANALYSIS TABLE (SAT) TCP 2 EXTENSION			

8 7 6 5 4 3 2 1

UNDESIRABLE EVENT	CAUSE	DEVIABLE CONDITION AT COMPONENT	PROTECTION		COMMENTS
			PRIMARY	SECONDARY	
OVERPRESSURE	INFLOW EXCEEDS OUTFLOW BLOCKED OUTLET	HIGH PRESSURE	PSV V23.1A	PSV V23.3	OVERFLOW OF THE TANK CAN ONLY OCCUR DURING FILLING OF THE UNIT. THIS IS DONE MANUALLY AND THE VESSEL IS PROTECTED BY AN OVERFLOW LINE GOING TO THE DRAINAGE SYSTEM. PROTECTION NOT REQUIRED SINCE THE FEED TO THE VESSEL IS THE FILLING LINE. THIS IS OPERATED MANUALLY AND IS NOT IN CONTINU- OUS SERVICE.
UNDERPRESSURE	WITHDRAWALS EXCEEDS INFLOW	LOW PRESSURE	PSV V23.1B	PSV V23.3	
OVERFLOW	LIQUID INFLOW EXCEEDS LIQUID OUTFLOW	HIGH LIQUID LEVEL			
LEAK	DETERIORATION RUPTURE ACCIDENT	LOW LIQUID LEVEL			

REV. NO.	REVISION	DATE	BY	APPR.	APPR. BY CLIENT	CLIENT			
00	FIRST ISSUE	26/03/81	JIN	<i>Ta</i>		elf aquitaine norge a/s P.O.Box 168 - 4001 Stavanger			
01	REVISED	13/06/81	JIN	<i>AT</i>		FRIGG FIELD			
						DATE	CONSTR.	APPR.	SCALE
						26/03/81	JIN		
						TITLE			
						SAFETY ANALYSIS TABLE (SAT)			
						TCP 2 EXTENSION			
						 sofresid norge a.s. CH 05 1430 DRWG NO. CH-FF 88 00 00 4142 Sheet 16/28			

UNDESIRABLE EVENT	CAUSE	D. TABLE CONDITION AT COMPONENT	PROTECTION		COMMENTS
			PRIMARY	SECONDARY	
OVERPRESSURE	BLOCKED DISCHARGE LINE	HIGH PRESSURE	PSH P12.4	PSV 12.3+4	
LEAK	RUPTURE DETERIORATION ACCIDENT	LOW PRESSURE AND BACKFLOW	PSL 12.5 FSV	ESS	

REV. NO.	REVISION	DATE	BY	APPR.	APPR. BY CLIENT	CLIENT
00.	FIRST ISSUE	26/03/81	JIN	<i>[Signature]</i>		elf aquitaine norge a/s P.O.Box 168 - 4001 Stavanger
01	REVISED	13/06/81	JIN	<i>[Signature]</i>		FRIGG FIELD
						DATE 26/03/81 CONSTR. JIN APPR. SCALE
						TITLE
						SAFETY ANALYSIS TABLE (SAT)
						TCP 2 EXTENSION
						DRWG. NO. CH-FF 88 00 00 4142 Sheet 17/28



solresid norge a.s.


CH 05 1430

DRWG. NO.

CH-FF 88 00 00 4142
Sheet 17/28


ITEM NO. CV 9 (EXISTING) SERVICE **ISOLATED WATER STORAGE TANK** FLOW DIAGRAM REFERENCE FF 88 00 00 5034 REV. 5

UNDESIRABLE EVENT	CAUSE	DETECTABLE CONDITION AT COMPONENT	PROTECTION		COMMENTS
			PRIMARY	SECONDARY	
OVERPRESSURE	INFLOW EXCEEDS OUTFLOW BLOCKED OUTLET	HIGH PRESSURE	PSV V9.2B	PSV V9.3	<p>THE TANK IS NOT IN CONTINUOUS SERVICE. OVERFLOW IS ONLY POSSIBLE WHEN INJECTION WELL OR DP2 IS CLOSED. VESSEL IS PROTECTED BY AN OVERFLOW LINE GOING TO THE DRAINAGE SYSTEM. NONE HAZARDOUS EVENT.</p> <p>NONE HAZARDOUS EVENT. PROTECTION NOT REQUIRED. THE TANK IS NOT IN CONTINUOUS SERVICE.</p>
UNDERPRESSURE	OUTFLOW EXCEEDS INFLOW	LOW PRESSURE	PSV V9.2A	PSV V9.3	
OVERFLOW	LIQUID INFLOW EXCEEDS LIQUID OUTFLOW BLOCKED OUTLET	HIGH LIQUID LEVEL			
LEAK	DETERIORATION RUPTURE ACCIDENT	LOW LIQUID LEVEL			

REV. NO.	REVISION	DATE	BY	APPR.	APPR. BY CLIENT	CLIENT
00	FIRST ISSUE	26/03/81	JIN	<i>JIN</i>		elf aquitaine norge a/s P.O.Box 168 - 4001 Stavanger
01	REVISED	13/06/81	JIN	<i>JIN</i>		FRIGG FIELD
						DATE 26/03/81 CONSTR JIN APPR. SCALE
						TITLE
						SAFETY ANALYSIS TABLE (SAT)
						TCP 2 EXTENSION
						 sofresid norge a.s CH 05 1430 DRWG. NO. CH-FF 88 00 00 4142 Sheet 19/28


8 7 6 5 4 3 2 1





UNDESIRABLE EVENT	CAUSE	D. TABLE CONDITION AT COMPONENT	PROTECTION		COMMENTS
			PRIMARY	SECONDARY	
OVERPRESSURE	BLOCKED DISCHARGE LINE	HIGH PRESSURE			PSH AND PSV IS NOT REQUIRED SINCE MAX PUMP DISCHARGE PRESSURE IS LESS THAN THE RATED WORKING PRESSURE ON DISCHARGE PIPING.
LEAK	RUPTURE DETERIORATION ACCIDENT	LOW PRESSURE AND BACKFLOW	FSV		PSL NOT REQUIRED SINCE OPERATING PRESSURE IS NEAR ATMOSPHERIC.

REV. NO.	REVISION	DATE	BY	APPR.	APPR. BY CLIENT	CLIENT
00	FIRST ISSUE	26/03/81	JIN	<i>[Signature]</i>		elf aquitaine norge a/s P.O.Box 168 - 4001 Stevanger FRIGG FIELD
01	REVISED	13/06/81	JIN	<i>[Signature]</i>		
						DATE 26/03/81 CONSTR. JIN APPR. SCALE
						TITLE
						SAFETY ANALYSIS TABLE (SAT)
						TCP 2 EXTENSION
						 sofresid norge a.s CH 05 1430 DRWG NO. CH-FF 88 00 00 4142 Sheet 20, 28

F	UNDESIRABLE EVENT	CAUSE	DANGEROUS TABLE CONDITION AT COMPONENT	PROTECTION		COMMENTS
				PRIMARY	SECONDARY	
	OVERPRESSURE	BLOCKED DISCHARGE LINE	HIGH PRESSURE			PSH AND PSV NOT REQUIRED SINCE MAX PUMP DISCHARGE PRESSURE WILL NOT EXCEED RATED WORKING PRESSURE ON DISCHARGE PIPING.
E	LEAK	RUPTURE DETERIORATION ACCIDENT	LOW PRESSURE AND BACKFLOW	FSV PSL P220A.1/ P220B.1/ P220C.1		NO SECONDARY PROTECTION REQUIRED SINCE THE LIQUID IS NOT HYDROCARBONS.
D						
C						
B						
A						


REV. NO.	REVISION	DATE	BY	APPR.	APPR. BY CLIENT	CLIENT
00	FIRST ISSUE	26/03/81	JIN	70		elf aquitaine norge a/s P.O.Box 168 - 4001 Stavanger
01	REVISED	13/06/81	JIN	82		FRIGG FIELD
						DATE 26/03/81 CONSTR. JIN APPR. SCALE
						TITLE
						SAFETY ANALYSIS TABLE (SAT)
						TCP 2 EXTENSION
						CH 05 1430
						DRAWG. NO. CH-FF 88 00 00 4142 Sheet 22/28

UNDESIRABLE EVENT	CAUSE	DANGEROUS CONDITION AT COMPONENT	PROTECTION		COMMENTS
			PRIMARY	SECONDARY	
OVERPRESSURE	BLOCKED DISCHARGE	HIGH PRESSURE	VENT+ SPARK ARRESTOR		NO OTHER PROTECTION REQUIRED SINCE THE VESSEL IS OPERATED MANUALLY AND AT ATMOSPHERIC CONDITIONS. THE SYSTEM IS NOT IN CONTINUOUS SERVICE.
OVERFLOW	LIQUID INFLOW EXCEEDS LIQUID OUTFLOW	HIGH LIQUID LEVEL	VENT (LSHH V222.3)		LSHH V222.3 GIVES ALARM ONLY
LEAK	DETERIORATION RUPTURE ACCIDENT	LOW LIQUID LEVEL			NONE HAZARDOUS EVENT.  CV 222 IS LOCATED WITHIN THE BEAMS, BELOW CELLAR DECK ELEVATION.

REV. NO.	REVISION	DATE	BY	APPR.	APPR. BY CLIENT	CLIENT			
00	FIRST ISSUE	26/03/81	JIN			elf aquitaine norge a/s P.O.Box 168 - 4001 Stavanger			
01	REVISED	13/06/81	JIN			FRIGG FIELD			
02	REVISED AS NOTED	25/08/81	JIN			DATE	CONSTR.	APPR.	SCALE
						26/03/81	JIN		
						TITLE			
						SAFETY ANALYSIS TABLE (SAT)			
						TCP 2 EXTENSION			
						 sofresid norge a.s			
						CH 05 1430			
						DRWG NO CH-FF 88 00 00 4142 Sheet 23/28			

Sheet 25/28

DESIRABLE EVENT	CAUSE	DETECTABLE CONDITION AT COMPONENT	PROTECTION		REMARKS
			PRIMARY	SECONDARY	
OVERPRESSURE	BLOCKED LINE	HIGH PRESSURE			OVERPRESSURE NOT POSSIBLE SINCE MAWP IS HIGHER THAN MSWHP
LEAK	DETERIORATION RUPTURE ACCIDENT	LOW PRESSURE BACKFLOW	PSL M210.1 PSV	ESS	

REV. NO.	REVISION	DATE	BY	APPR.	APPR. BY CLIENT	CLIENT elf aquitaine norge a/s P.O.Box 168 - 4001 Stavanger FRIGG FIELD			
00	FIRST ISSUE	13/06/81	JIN	AG		DATE	CONSTR.	APPR.	SCALE
						13/06/81	JIN		
						SAFETY ANALYSIS TABLE (SAT) TCP 2 EXTENSION			
						 solresid norge a.s. CH-05 1430 DRWG NO. CH-FF 88 00 00 4142 Sheet 26/28			

ITEM NO. C 2236 EFS 11"ME


SERVICE ARTICULATED COLUMN

FLOW DIAGRAM REFERENCE FF 88 00 09 5036

Rev. 3

F E D C B A	UNDESIRABLE EVENT	CAUSE	UNSTABLE CONDITION AT COMPONENT	PROTECTION		COMMENTS
				PRIMARY	SECONDARY	
	OVERPRESSURE	BLOCKED LINE	HIGH PRESSURE	PSH P12.4		SECONDARY PRETECTION NOT REQUIRED SINCE MAX PRESSURE IS LESS THAN THE WORKING PRESSURE OF THE PIPING
	LEAK	DETERIORATION RUPTURE ACCIDENT	LOW PRESSURE BACKFLOW	PSL P12.5 FSV	ESS	

REV. NO.	REVISION	DATE	BY	APPR.	APPR. BY CLIENT
00	FIRST ISSUE	13/07/81	JIN	AT	

CLIENT elf aquitaine norge a/s P.O.Box 188 - 4001 Slaverøyen				FRIGG FIELD	
DATE 13/06/81	CONSTR. JIN	APPR.	SCALE	 sofresid norge a.s.	
TITLE SAFETY ANALYSIS TABLE (SAT) TCP2 EXTENSION					
				CH 05 1430	
				DRWG. NO. CH-FF 88 00 00 4142 Sheet 28/28	

APPENDIX 5

SAFETY ANALYSIS FUNCTION EVALUATION CHART

PLATFORM IDENTIFICATION
TCP 2 EXTENSION

03	09	79	03	AS BUILT	NCA		081	A1	ICP 3	Continued
02	09	06	01	UPDATED ACC TO EAM COMM	22		acquire	F07	FPZ EXTENSIO	
01	07	08	06	UPDATED	22		nonge AS		SAFETY ANALYSIS FUNCTION	
00	06	06	01		26				EVALUATION CHAIR	
					26				GAS AND LIQUID TREATING	
Rev.	Date	DESCRIPTION				No.	Notes	FF	BB	15
									00	00


DRWS MO CK EN 000 14331

APPENDIX 6

FUNCTIONAL DESCRIPTION OF THE ESD SYSTEM

S-FF 88 16 9520

2	26.11.81	UPDATED PAGE 4, 5 AND 6	JKa	BT	
1	13.10.81	UPDATED ACCORDING TO EAN COMMENTS	JKa	BT	
0	12.6.81	First Issue	JKa	BT	
REV.	DATE	DESCRIPTION	BY	APP.	CLIENT



sofresid norge a.s

NO.: PR 08 000 01202

TCP 2 EXTENSION



elf aquitaine norge a/s P.O. Box 168 — 4001 Stavanger

A4

Installation

TCP 2

System

HYDR. AND SHUT DOWN

Job no.

F 087

Scale

-

FUNCTIONAL DESCRIPTION
OF THE ESD SYSTEM

FRIGG FIELD

Drwg. no.

S-FF

88

16

9520

Rev.

02

Sheet

1/6

TABLE OF CONTENTS

	<u>PAGE</u>
1.0 GENERAL	3/6
2.0 SYSTEM DESCRIPTION	4/6
3.0 REFERENCE LIST, DRAWINGS AND SPECIFICATION	6/6

1.0 GENERAL

The emergency shut down system (ESD) for TCP 2 extension is fully integrated in the existing ESD system for the TCP 2 platform and based on the same philosophy.

The intention with the ESD system is to avoid dangerous situations or limit the consequences of same, to avoid disturbances in parts of the process or damage on process equipment.

The system is split into five levels, and the consequences of the action on each level is described in section 2.0.

The system can be released either manually by push buttons or automatically by fire/gas detection or process fault depending upon which level it is released. The ESD valves can only be opened again when the reason for ESD action is eliminated and authorization signal is given from control center.

Time response for the system will be within 45 seconds i.e. the time from the signal is initiated by the sensor till the ESD valve is fully closed shall not exceed 45 seconds.

Three auxiliary systems are utilized to operate the ESD system. These are as follows:

- A. Hydraulic Power System
See Hydraulic System Description Appendix B.
- B. Instrument Air
See drawing FF 87 00 00 1003 - Plant and Instrument Air System on TCP 2

Instrument air at 1.4 bar, 2.5 bar and 7 bar, is supplied from the existing Instrument Air System and is provided with back-up air bottles in order to provide safe operation in case of failure in air supply.

- C. Electric power is fed from the existing No Break System which has a battery back-up.

Voltages: 220 V AC
 110 V DC
 48 V DC
 24 V DC

See drawing FF 85 23 03 00 84.

2.0 SYSTEM DESCRIPTION



Location of the ESD valves is shown on drawing FF 88 00 00 0102 Schematic Process Diagram.

The ESD logic for the field is shown on drawing FE 00 16 00 5801 Frigg Field Shut Down General Logic Diagram. Drawing FF 88 16 08 9551 Shut Down Detail Logic Diagram presents the ESD logic for TCP 2 treatment extension which is incorporated in the total system. 4th and 5th level is defined as process safety system, see S-FF 88 16 08 9521 Description of Process Safety System.



1st level:

1st level shut down can only be released manually by using the push button in QP Central Control Room (CCR). The action is shut down of all field included isolation of the platforms by closing ESD valves on bridge lines. It also includes Disaster Shut Down signal (DSD) on DP 2 and CDP 1. There is no cascade action to level 2 and hence no decompression. 5.5 kV generators TA 4, 5 and 6 will be shut down. Non essential electrical consumers is isolated and fire water pumps CP6A and CP6B will start.



2nd level:

2nd level shut down of TCP 2 treatment is also only manually released by push buttons located in QP CCR and TCP 2 Interface Room. The action is the same as for 1st level with following exceptions:

5.5 kV generators are not affected.
ESD signal only to DP 2.
Decompression of bridge and treatment lines.



3rd level:

3rd level shut down can be released either manually by push buttons or automatically by fire or gas detection. 7 push buttons are located on different places for manual release (See drawing FF 88 16 08 9551 Shut Down Detail Logic Diagram). Note that 4 of these push buttons also will cause 3rd level shut down both on treatment and compression part of TCP 2.

Action on 3rd level is as for 2nd level with following exceptions:



No ESD signal to DP 2. Automatic release of Deluge Valves for relevant fire/gas affected area in parallel with 3rd level shut down. Note that Deluge Valves will not be released by operating of push buttons.



4th and 5th level:

4th and 5th level shut down are defined as process safety system. Release on 4th level is both manually and automatically, whilst 5th level is only automatically released by process faults. The ESD valves are grouped together in three groups. Group "O" is ODIN stream isolation, group "N" is NEF stream isolation and group "U" is closing of sealines. Group "U" will only be closed by 3rd level shut down or higher levels, whilst group "O" and "N" will also be closed by 4th level shut down. 5th level is only selective i.e. a process fault will only close one or a certain number of ESD valves. For further information about 4th and 5th level shut down, see FF 88 16 08 9521 Description of Process Safety System.

3.0 REFERENCE LIST, DRAWINGS AND SPECIFICATIONS

FF 88 00 00 0102	Schematic Process Diagram
FE 88 16 00 5801	Frigg Field Shut Down General Logic Diagram
FF 88 16 08 9155	Shut Down & Safety Functions TCP2 Extension Overall Block Diagram
FF 88 16 06 9152	Fire Detection Logic Principal Diagram
FF 88 16 06 9153	Gas Detection Logic Principal Diagram
FF 88 16 06 9151	Public Address and Alarm System Block Diagram
FF 88 16 08 9551	Shut Down Detail Logic Diagram
FF 88 16 08 9561	ESD Pneumatic Schematics Group "O".
FF 88 16 08 9562	ESD Pneumatic Schematics Group "U".
FF 88 16 08 9564	Pneumatic Schematics Group "N".
ELD 2169 Sheet 7379	Safety Plot Plan Main Deck
FF 88 00 00 4012	Safety Plot Plan M50 Main Deck
FF 88 16 08 1832	Type A Pneumatic ESDV Control Schematic
FF 88 16 08 1833	Type B Hydraulic ESDV Control Schematic
FF 88 16 08 1835	Type D Pneumatic ESDV Control Schematic
S-FF 88 20 2600	Specification for ESD Valves
S-FF 88 16 2940	Specification for Hydraulic & Pneumatic Control Enclosures
S-FF 88 16 1512	Specification for Level Switches
S-FF 88 16 3110	Specification for Pressure Switches
S-FF 88 16 4002	Specification fo Temperature Switches
Appendix B	Hydraulic System Description
FF 85 23 03 00045	Master One Line Diagram for Emergency Supplies
FF 87 00 00 1003	Plant and Instrument Air System on TCP 2
FF 87 23 03 8800	Low Voltage Consumers for 380 V MCC "A"
FF 87 23 03 8810	Low Voltage Consumers for 380 V MCC "B"

APPENDIX B

DESCRIPTION OF HYDRAULIC SYSTEM

APPENDIX B

HYDRAULIC SYSTEM DESCRIPTION

HYDRAULIC POWER GENERATION

Hydraulic power for Module M50 and ESDV's on sealines will be derived from the existing treatment hydraulic power generator by extending the existing ring main shown schematically on drawing no. FF 88 00 0800 02.

The existing system has the following capacity:

Max. Press	138 Bar
Min. Press	125 Bar
Pumping Rate	100 l/min.

It is estimated that with the present load its recovery time is approximately 7 minutes if the full ESDV back up is utilized.

The additional load imposed by the extension amounts to approximate 100 litres if the full ESDV back up is used.

Therefore the new recovery time will be approximately 9 minutes.

The hydraulic system for M50 will consist of a ring main with dedicated local accumulator stations for each ESDV valve.

Each ESDV will be controlled by means of a local control enclosure. This will provide either a local or remote facility to close the valve, with the local control having priority. Opening of the valve is accomplished locally, but requires that an ESDV status does not exist, that there is no remote close requirement and that authorization has been given to open the valve. Pneumatic valves in Pancake 53 operate in a similar manner.

The control enclosure schematics are shown on drawings
no.:

FF 88 16 00 1832 - Type A Pneumatic ESDV Control Schematic
(DD 08 P53 06807)

FF 88 16 08 1833 - Type B Hydraulic ESDV Control Schematic
(DD 08 M50 06808)

FF 88 16 08 1834 - Type C Hydraulic HV Control Schematic
(DD 08 M50 06809)

FF 88 16 08 1835 - Type D Pneumatic ESDV Control Schematic
(DD 08 M50 06810)

For hydraulic valves these schematics are identical to
those on the existing treatment unit.

Actuators are of the double acting hydraulic type except
for those valves located in the Pancake 53 which are of
the double acting pneumatic type. The blow down valves
are conventional fail open control valves fitted with
travel stops to limit the flow through the valve.


Provision is made to supply all ESDV valves except
blow down valves with either a hydraulic or pneumatic
back up accumulator/volume tank capable of providing
2 cyclic (4 single strokes) operations of the valve.

APPENDIX 7

DESCRIPTION OF PROCESS SAFETY SYSTEM

S-FF 88 16 08 9521


1	20.10.81	Updated acc. to EAN comments	JKa	JEL	
00	13.10.81	First issue	JKa	JEL	
REV.	DATE	DESCRIPTION	BY	APP.	CLIENT



sofresid norge a.s

NO.: SP 08 000 6801

TCP 2 EXTENSION

	elf aquitaine norge a/s P.O. Box 168 — 4001 Stavanger		
	A4	Installation TCP 2	System HYDR. & SHUT DOWN
	DESCRIPTION OF PROCESS SAFETY SYSTEM		
Job no. F 087			
Scale —			

FRIGG FIELD	Drwg. no. S-FF	88 16 08 9521	Rev. 01	Sheet 1/2
-------------	-------------------	---------------	------------	--------------

TABLE OF CONTENT

	<u>PAGE</u>
1.0 GENERAL	3/8
2.0 PROCESS SAFETY CONTROL LOOPS, GENERAL	4/8
3.0 PROCESS SAFETY CONTROL LOOPS, PNEUMATIC	5/8
4.0 PROCESS SAFETY CONTROL LOOPS, ELECTRICAL	6/8
5.0 REFERENCE LIST, DRAWINGS AND SPECIFICATIONS	7/8 - 8/8

1.0 GENERAL

The Process Safety System is an integrated part of the total ESD System, which is split in five levels. Ref. FF 88 16 08 9520 - Functional description of the ESD System. The Process Safety System is formed by 5th and 4th level in the ESD System. The intention with the Process Safety System is to close either one or a certain number of ESD valves in the process when abnormal conditions occur, in order to avoid dangerous situations, disturbances in other parts of the process or damage on process equipment. Thus, a process safety function is to be defined as closing of an ESD valve/valves or a pump to be switched off.

All process safety functions on 5th level are initiated automatically by sensors located in different places in the process. 4th level signals are initiated either automatically by sensors or manually by push buttons. The push buttons are located in QP central control room, interface room on TCP 2 and locally in the field. (See drawing ELN 2169 sheet C7379 - Safety Plot Plan Main Deck FF 88 00 00 4012 - Safety Plot Plan M50 Main Deck.). Note that signals from 4th level will close the whole stream on either NEF or ODIN.

Three auxiliary systems are utilized to operate the ESD and Process Safety System. These are as follows:

- A. Hydraulic Power System
See Hydraulic System Description Appendix I.
- B. Instrument Air
See drawing FF 87 00 00 1003 - Plant and Instrument Air System on TCP 2

Instrument air at 1.4 bar, 2.5 bar & 7 bar, is supplied from the existing Instrument Air System and is provided with back-up air bottles in order to provide safe operation in case of failure in air supply.

- C. Electric power is fed from the existing No Break System which as a battery back-up.

Voltages: 220 V AC
110 V DC
48 V DC
24 V DC

See drawing FF 85 23 03 0045.

Time response for the system will be within 45 seconds i.e. the time from the signal is initiated by the sensor till the ESD valve is fully closed shall not exceed 45 seconds.

2.0 PROCESS SAFETY CONTROL LOOPS, GENERAL

A process safety control loop consists of following components:

- A. Sensors monitoring the process condition, i.e. pressure, temperature and liquid level in the different vessels. These are all switches with air supply and pneumatic on/off output signal.
- B. Auxiliary Components
 - B.1 Pneumatic/electric switches located in pneumatic switch cabinet in interface room.
 - B.2 Relays and solenoid valves located in ESD cabinet in interface room.
 - B.3 Pneumatic operated pilot valves located close to the different control enclosures and ESD valves.
 - B.4 Pneumatic/hydraulic control enclosures located close to the ESD valve.
- C. ESD valve with built on pneumatic or hydraulic actuator depending on valve size and torque.
- D. Alarm circuit with visual and audible signal in QP control room.

3.0 PROCESS SAFETY CONTROL LOOPS, PNEUMATIC

Closing of ESD Valves

Ref. drwg.'s no.:

FF 88 16 08 9561 Pneumatic Schematic Group "O"

FF 88 16 08 9562 Pneumatic Schematic Group "U"

FF 88 16 08 9564 Pneumatic Schematic Group "N"

On 5th and 4th level the ESD valves are closed almost directly when the output signal from the sensor in the process is removed.

Example: High liquid level in CV1A. See drawing
FF 88 16 08 9561 - Pneumatic Schematics
Group "O".

When in normal condition there is a continuous control signal from LSHH V1A.8A to pilot valve LV V1A.8A which keeps this open between inlet and outlet and allows for the air supply to the control enclosure and ESDV V1A.1 is in open position. If the level in CV1A rises and pass the set point for LSHH V1A.8A the control signal to LV V1A.8A is vented and this will switch over to vent position. Air supply to the control enclosure is vented and ESDV V1A.1 will close. For functioning of pneumatic/hydraulic control enclosures see following drawings:

FF 88 16 00 1832 - Type A Pneumatic ESDV Control Schematic

FF 88 16 08 1833 - Type B Hydraulic ESDV Control Schematic

FF 88 16 08 1835 - Type D Pneumatic ESDV Control Schematic

All types of control enclosures are equipped with devices for local closing of the valve and also devices for testing of ESD valve functioning.

The alarm circuit will be activated by a pneumatic/electric switch in interface room from where the signal is passed via telemetry to alarm circuit in control room on QP. The input signal to the pneumatic/electric switch in interface room comes from the same sensor as closes the ESD valve. The ESD valve status is also shown on a mimic panel in control room and the input signal for this is provided from two limit switches mounted on the ESD valve.

When automatically closed, valves will remain closed even if the relevant cause of shut-down has disappeared. The operator will have to restart the process manually after investigation and elimination of the prime cause and after authorization signal is given for central control room.

4.0 PROCESS SAFETY CONTROL LOOPS, ELECTRICAL

Stop of Pumps

All control loops for stop of pumps are electrical except the primary signal from the sensor in the process which is pneumatic. This signal is transferred to an electric signal in the pneumatic switch cabinet in interface room and passed from there to the ESD cabinet where it operates a relay. A contact set on the relay is connected to the pump motor starter circuit and will switch off the power to this.

Ref. drwg.'s:

- FF 87 23 03 8800 - Low Voltage Consumers for
380 V MCC "A"
- FF 87 23 03 8810 - Low Voltage Consumers for
380 V MCC "B"

5.0 REFERENCE LIST, DRAWINGS AND SPECIFICATIONS

FF 88 00 00 5030	ODIN Gas Treatment
FF 88 00 00 5031	NORTH EAST FRIGG Gas Treatment
FF 88 00 11 5032	NEF and ODIN Liquid Treatment Condensate Separation
FF 88 00 10 5033	NEF and ODIN Liquid Treatment Methanolated Water
FF 88 00 00 5034	NEF and ODIN Liquid Treatment TEG & MW Facilities
FF 88 00 09 5036	NEF and ODIN Treatment Methanol Injections
FF 88 00 04 5090	NEF and ODIN Treatment Flare System
FF 88 00 10 5100	NEF and ODIN Treatment Process Drainage System
FF 83 00 54 5101	NEF and ODIN Liquid Treatment Methanolated Water Injection on DP 2

All drawings above are relevant P & ID's to this description.

FF 88 16 00 4143	TCP 2 Extension Safety Analysis Function Evaluation Chart (SAFE)	
FF 88 16 08 9551	Shut Down Detail Logic Diagram	
FF 88 16 08 9561	ESD Pneumatic Schematics Group "O"	
FF 88 16 08 9562	ESD Pneumatic Schematics Group "U"	
FF 88 16 08 9564	Pneumatic Schematics Group "N"	
ELN 2169 Sheet 7379	Safety Plot Plan Main Deck	} Location of ESD push buttons level 4
FF 88 00 00 4012	Safety Plot Plan M50 Main Deck	
FF 88 16 08 1832	Type A Pneumatic ESDV Control Schematic	
FF 88 16 08 1833	Type B Hydraulic ESDV Control Schematic	
FF 88 16 08 1835	Type D Pneumatic ESDV Control Schematic	
S-FF 88 20 2600	Specification for ESD Valves	
S-FF 88 16 2940	Specification for Hydraulic & Pneumatic Control Enclosures	

S-FF 88 16 1512	Specification for Level Switches
S-FF 88 16 3110	Specification for Pressure Switches
S-FF 88 16 4002	Specification for Temperature Switches
Appendix I	Hydraulic System Description
FF 85 23 03 00045	Master One Line Diagram For Emergency Supplies
FF 87 00 00 1003	Plant And Instrument Air System On TCP 2
FF 87 23 03 8800	Low Voltage Consumers For 380 V MCC "A"
FF 87 23 03 8810	Low Voltage Consumers For 380 V MCC "B"

APPENDIX B

DESCRIPTION OF HYDRAULIC SYSTEM

APPENDIX B

HYDRAULIC SYSTEM DESCRIPTION

HYDRAULIC POWER GENERATION

Hydraulic power for Module M50 and ESDV's on sealines will be derived from the existing treatment hydraulic power generator by extending the existing ring main shown schematically on drawing no. FF 88 00 0800 02.

The existing system has the following capacity:

Max. Press	138 Bar
Min. Press	125 Bar
Pumping Rate	100 l/min.

It is estimated that with the present load its recovery time is approximately 7 minutes if the full ESDV back up is utilized.

The additional load imposed by the extension amounts to approximate 100 litres if the full ESDV back up is used.

Therefore the new recovery time will be approximately 9 minutes.

The hydraulic system for M50 will consist of a ring main with dedicated local accumulator stations for each ESDV valve.

Each ESDV will be controlled by means of a local control enclosure. This will provide either a local or remote facility to close the valve, with the local control having priority. Opening of the valve is accomplished locally, but requires that an ESDV status does not exist, that there is no remote close requirement and that authorization has been given to open the valve. Pneumatic valves in Pancake 53 operate in a similar manner.

The control enclosure schematics are shown on drawings
no.:

FF 88 16 00 1832 - Type A Pneumatic ESDV Control Schematic
(DD 08 P53 06807)

FF 88 16 08 1833 - Type B Hydraulic ESDV Control Schematic
(DD 08 M50 06808)

FF 88 16 08 1834 - Type C Hydraulic HV Control Schematic
(DD 08 M50 06809)

FF 88 16 08 1835 - Type D Pneumatic ESDV Control Schematic
(DD 08 M50 06810)

For hydraulic valves these schematics are identical to
those on the existing treatment unit.

Actuators are of the double acting hydraulic type except
for those valves located in the Pancake 53 which are of
the double acting pneumatic type. The blow down valves
are conventional fail open control valves fitted with
travel stops to limit the flow through the valve.

Provision is made to supply all ESDV valves except
blow down valves with either a hydraulic or pneumatic
back up accumulator/volume tank capable of providing
2 cyclic (4 single strokes) operations of the valve.

APPENDIX 8

PRESSURE DROP CALCULATIONS FOR LP VENT SYSTEM

CALCULATION NOTES

CLIENT: E.A.N.	PROJECT: TCP-2 Extension	SHEET 1 OF 2
DISCIPLINE: Process	ENGINEER: JIN	REF.:
SUBJECT: LP vent header pressure drop calculation		

The below calculations are based on maximum flow rate released through the LP vent system. This flow rate corresponds to fire on the pancake, which will release 0.348 MSCM/D or 10608 kg/hr.

The pressure drop is calculated using the Darcy formula:

$$(\Delta P_{100}^1) = \frac{4f \times 0.000336 \times W^2}{(ID)^5 \times \rho}$$

where

- (P_{100}^1) = the pressure drop in psi/100 ft
- f = fanning friction factor
- W = flow rate in lb/hr (23387 lb/hr)
- ID = internal diameter of pipe in inches (10.02)
- ρ = gas density in lb/cuft

The friction factor "f" is determined from Reynolds number:

$$Re = \frac{6.32 \times W}{\mu d}$$

where μ = gas viscosity in cp (0.011)

$$Re = \frac{6.32 \times 23387}{0.011 \times 10.02} = 1341007$$

$$\text{Since } Re > 4000, f = \frac{0.04}{Re^{0.172}} = 0.00353$$

CALCULATION NOTES

CLIENT: E.A.N.	PROJECT: TCP-2 Extension	SHEET 2 OF 2
DISCIPLINE: Process	ENGINEER: JIN	REF.:
SUBJECT: LP vent header pressure drop calculation		

$$\text{Gas density @ 1.5 bara : } \rho = \frac{1.5 \times 17.3}{293.15 \times 0.08314} = 1.065 \text{ kg/m}^2$$

(0.0665 lb/cuft)

Pressure drop

$$(\Delta P_{100}^1) = \frac{4 \times 0.00353 \times 0.000336 \times (23387)^2}{(10.02)^5 \times 0.0665} = \underline{0.386 \text{ psi/100 ft}}$$

Equivalent length:

75 m	=	246 ft
6 ellbows	=	72 ft
1 enlargement 10"/14"	=	7 ft
		325 ft

$$\text{Total pressure drop: } 0.386 \times 3.25 = 1.25 \text{ psi} = \underline{0.1 \text{ bar}}$$

Pressure at tie in point between the 10" LP vent header and the existing 14" header is 1.3 bara.

(Ref. is made to Document 5532 N12 "Process Studies for Flare and Vent", first part).

Maximum back pressure for the 10" LP vent header will be 1.4 bara.

APPENDIX 9

BACK PRESSURE CALCULATIONS - LT RELIEF SYSTEM

- HP RELIEF SYSTEM

CALCULATION NOTES

CLIENT: E.A.N.

PROJECT: TCP-2 Extension

SHEET 1 OF 9

DISCIPLINE: Process

ENGINEER: JIN

REF.: JIN/asb

SUBJECT: Back pressure calcs - LT Relief header

Basis

The method for calculating the back pressure is based on the guidelines given in API RP 521 section 5.3A.1. The critical mass flow is determined using the equation:

$$G_{ci} = 12.6 P_o \left(\frac{M}{T_o} \right)^{0.5}$$

G_{ci} = critical mass flow, lb/sec, sqft

P_o = upstream pressure, psia

M = molecular weight of vapour (16.9)

T_o = upstream temperature, °R (393°R or - 55°C)

Total line resistance is calculated using the equation:

$$N_T = \frac{4fL}{D} + K$$

N_T = total equivalent resistance factor, dimensionless

f = fanning friction factor

L = equivalent length of line, ft

K = values for pipe fittings, dimensionless

i) LT RELIEF SYSTEM

1. Back pressure from 1 to 2. (Ref. is made to fig. 1)

Calculation of friction factor f .

Reynolds no: $Re = \frac{\rho V D}{\mu}$

ρ (at 2.0 bara and - 55°C): $\frac{16.9 \times 2.0}{0.08314 \cdot 218} = 1.86 \text{ kg/m}^3$

D (internal diameter) = 0.315 m

Flowrate (2.8 MSCM/D) = 83380 kg/hr

CALCULATION NOTES

CLIENT: E.A.N.

PROJECT: TCP-2 Extension

SHEET 2 OF 9

DISCIPLINE: Process

ENGINEER: JIN

REF.: JIN/asb

SUBJECT: Back pressure calculation - LT relief header

$$V = \frac{83380}{1.86 \times 3600 \times 0.073} = 171 \text{ m/s}$$

$$\mu = 0.0083 \quad (\text{from chart 16 - 26 NGPSA})$$

$$Re = \frac{1.86 \times 171 \times 0.315}{0.0083 \times 0.001} = 12070952$$

$$\text{Since } Re > 4000 \quad f = \frac{0.04}{Re^{0.172}} = 0.0024$$

Calculation of N_T

Length: 11.5 m = 38 ft

$$N_T = \frac{4 \times 0.0024 \times 38}{1.03} = 0.4$$

Back pressure calcs

Results

Downstream pressure (P_1) 1.373 bara	TRIAL 1	TRIAL 2	TRIAL 3
Upstream pressure P_o	1.573	1.973	2.373
P_1/P_o	0.87	0.696	0.58
G/G_{ci}	0.64	0.84	0.875
G_{ci} lb/sec, sqft	59.61	74.77	89.93
G , lb/sec, sqft	38.15	62.8	79.14

CALCULATION NOTES

CLIENT: E.A.N.

PROJECT: TCP-2 Extension

SHEET 3 OF 9

DISCIPLINE: Process

ENGINEER: JIN

REF.: JIN/asb

SUBJECT: Back pressure calculation - LT relief system

"Actual" G is (12" pipe):


$$\frac{83380 \times 2.20462}{3600 \times \pi/4(1.03)^2} = \underline{61.3 \text{ lb / sqft,s}}$$

. The above results are presented in fig. 2.

Conclusion: The pressure at point 1 is 1.95 bara

LT RELIEF SYSTEM - SCHEMATIC DIAGRAM


FIG.1

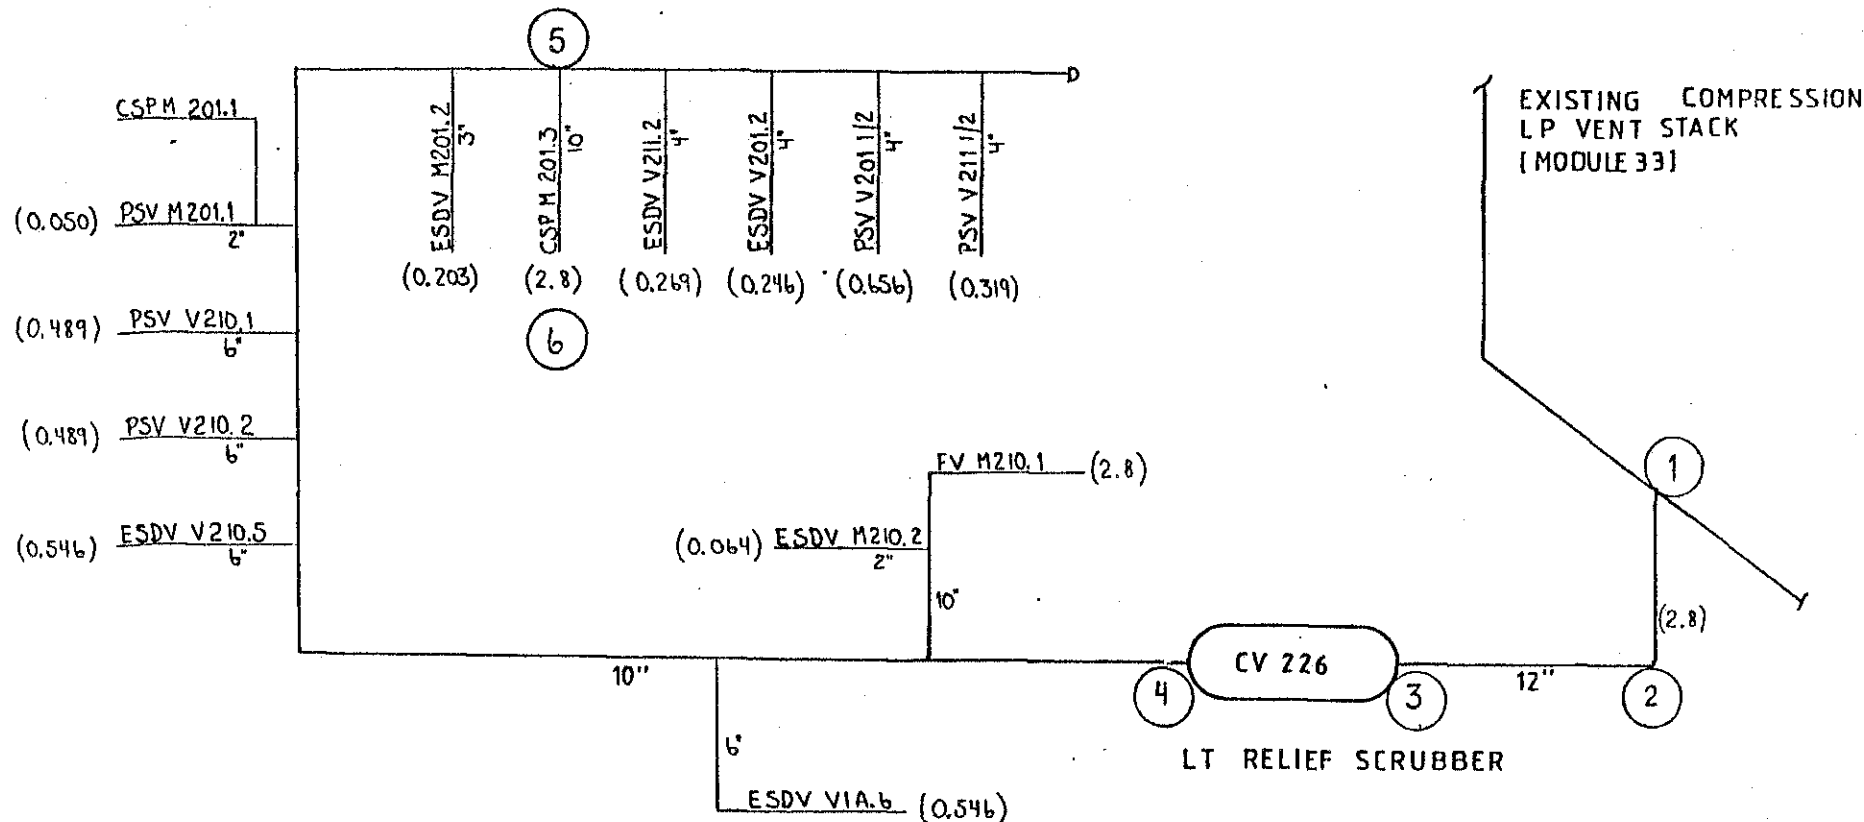

REVNO	REVISION	DATE	BY	APPR	APPR BY CLIENT
CLIENT					
DATE	CONSTR.	APPR.	SCALE		
TITLE					
				APPR. BY CLIENT	
				DATE SIGN	
				DRWG NO.	

BACK PRESSURE - LP VENT SLACK TID POINT 1

FIG 2

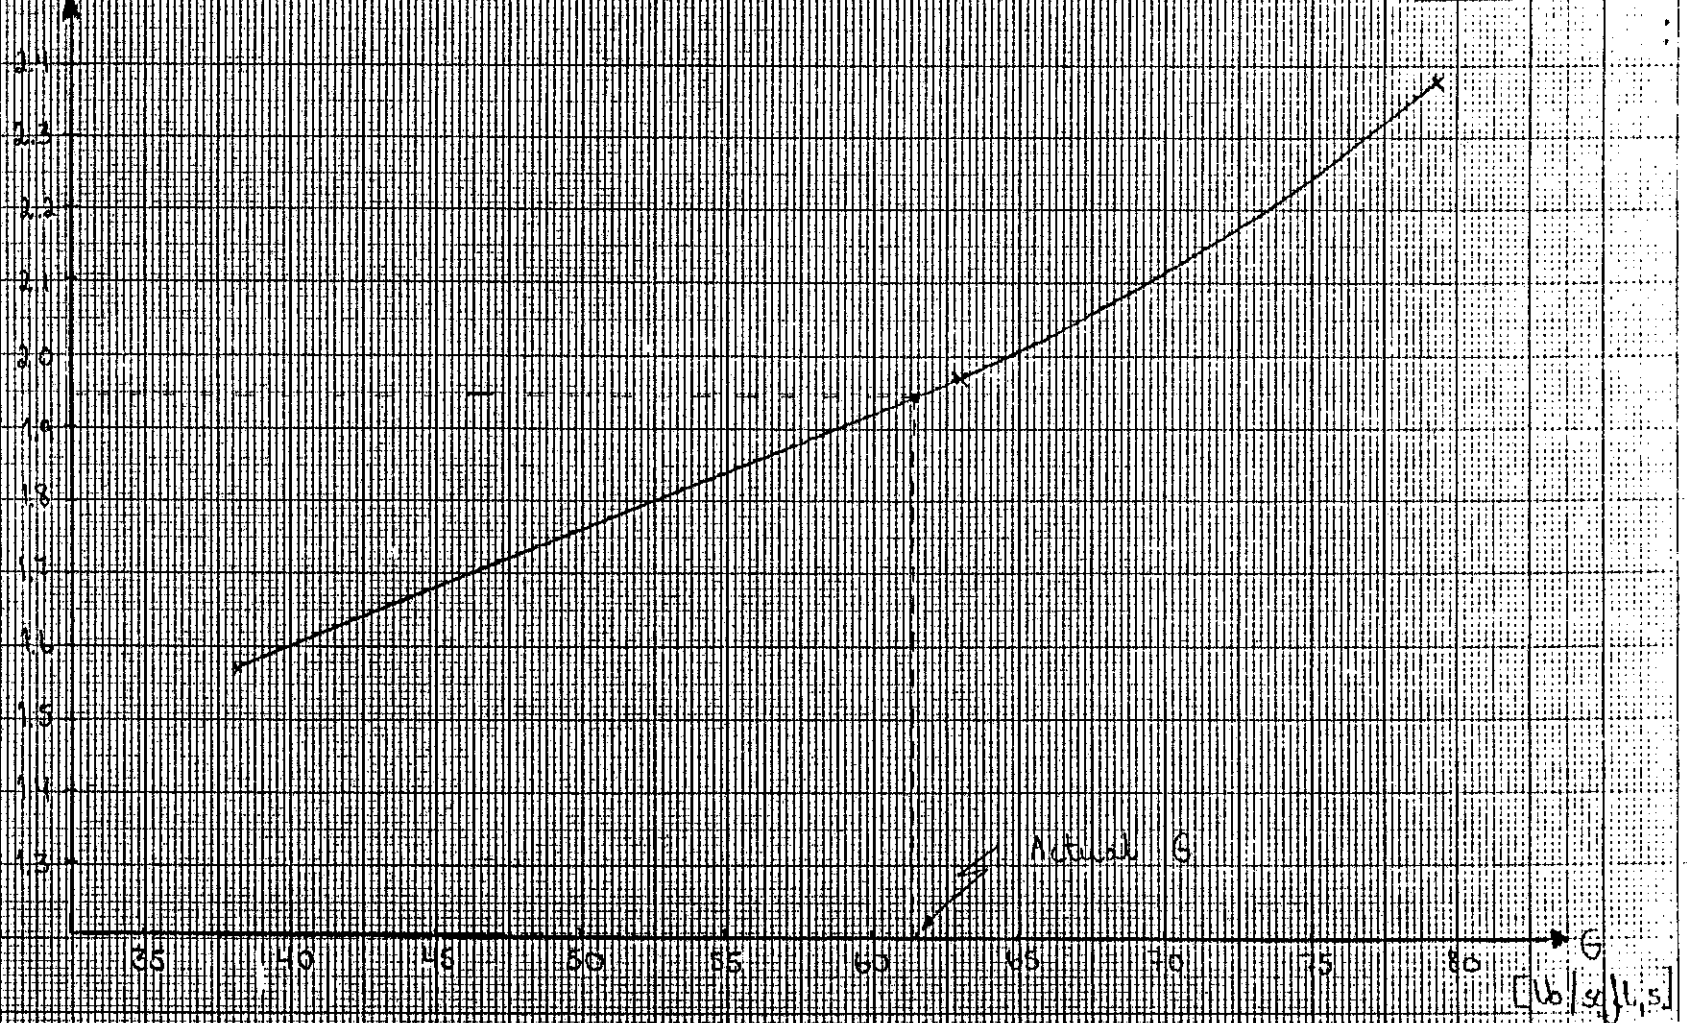

10.02.81 JIN

CALCULATION NOTES

CLIENT: E.A.N.

PROJECT: TCP-2 Extension

SHEET 4 OF 9

DISCIPLINE: Process

ENGINEER: JIN

REF.: JIN/asb

SUBJECT: Back pressure calcs - LT relief header

2. Back pressure from 2 to 3 (Ref. fig. 1)

Calculation of N_T

Length 38.1 m = 125 ft

5 long rad 90° ell ($K = 0.45 \times 5$) = 2.25

3 long rad 45° ell ($K = 0.20 \times 3$) = 0.60

$$N_T = \frac{4 \times 0.0024 \times 125}{1.03} + 2.25 + 0.60 = \underline{4.05}$$

Back pressure calcs

Results


Downstream pressure (P_1) 1.95 bara	TRIAL 1	TRIAL 2	TRIAL 3
Upstream pressure P_0	2.5	3.0	3.5
P_1/P_0	0.78	0.65	0.56
G/G_{ci}	0.44	0.52	0.57
G_{ci} lb/sec, sqft	94.75	113.7	132.64
G lb/sec, sqft	41.69	59.12	75.60

The above results are presented in fig. 3.

Conclusion: The pressure at point 2 is 3.07 bara

BACK PRESSURE - POINT 1 TO POINT 2

FIG. 3

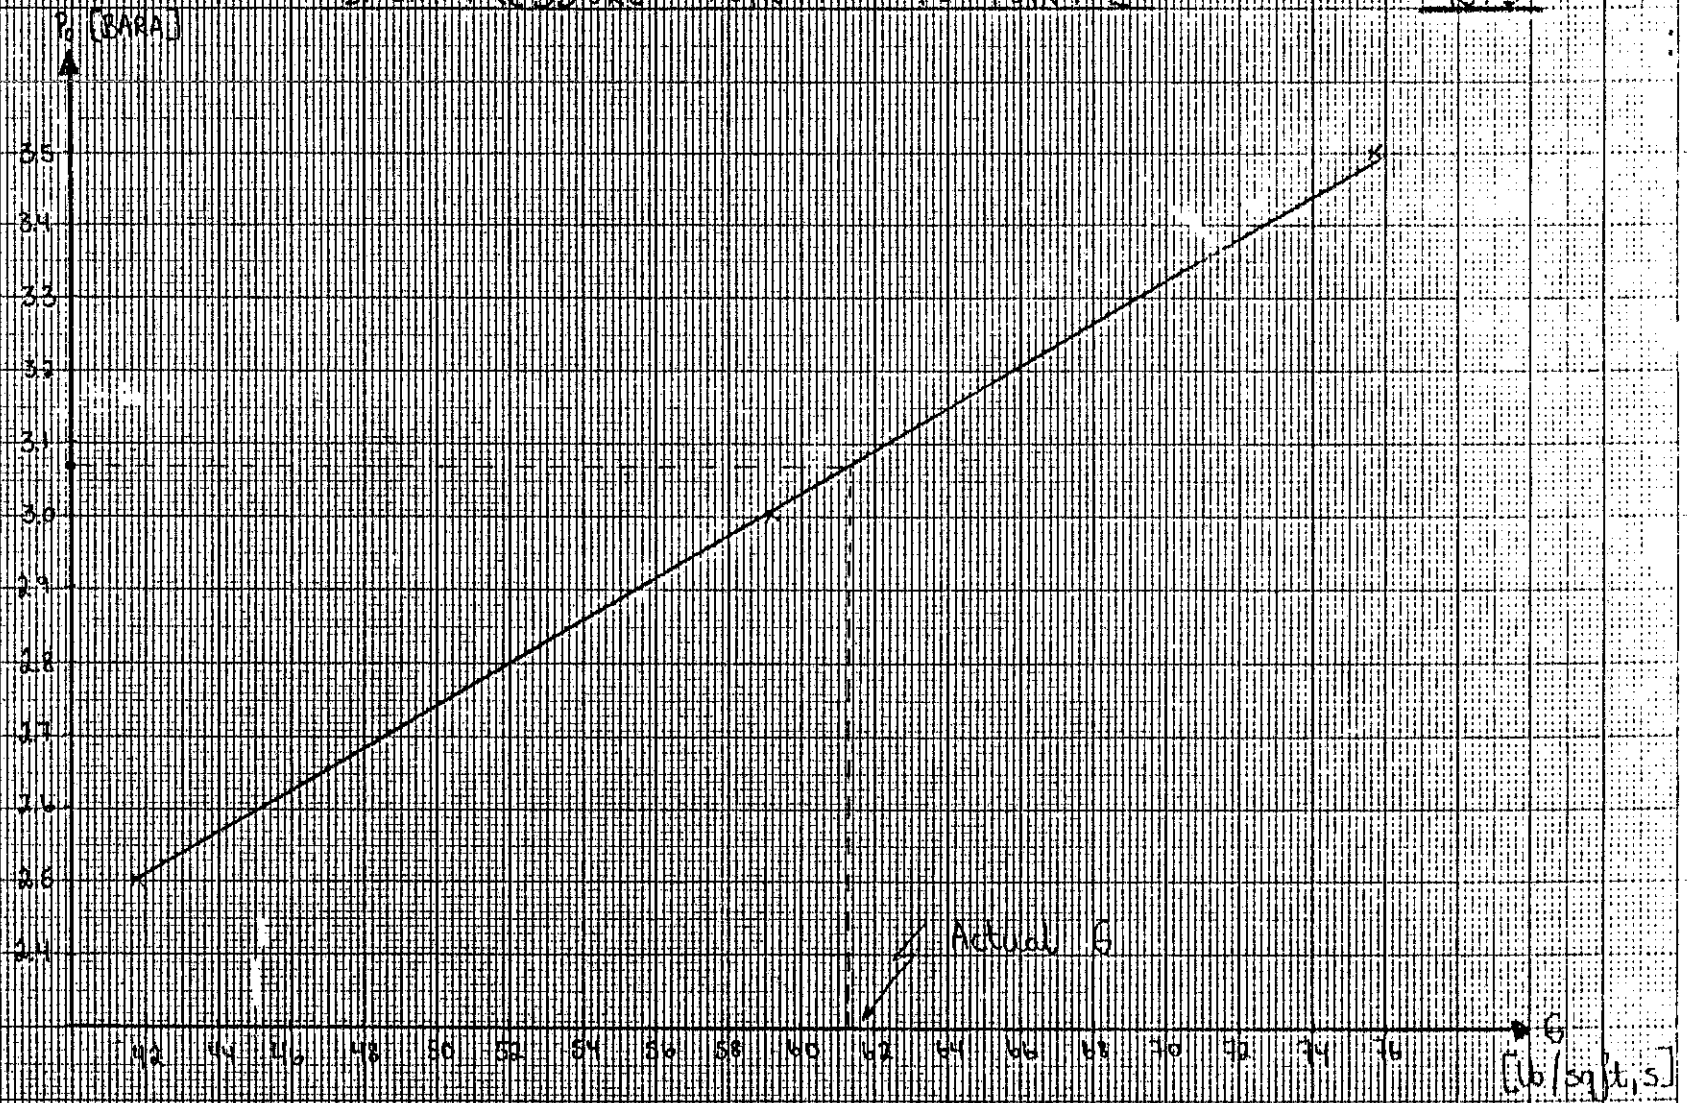

10.02.81 JIN

CALCULATION NOTES

CLIENT: E.A.N.

PROJECT: TCP-2 Extension

SHEET 5 OF 9

DISCIPLINE: Process

ENGINEER: JIN

REF.: JIN/asb

SUBJECT: Back pressure calcs - LT relief header

3. Pressure drop through LT - relief scrubber

Pressure drop is calculated using the formula

$$\Delta p = \frac{K \rho V^2}{9266}$$

$$\text{Sudden enlargement } K_1 = (1 - \beta_1)^2$$

$$\text{Sudden contraction } K_2 = 0.5 (1 - \beta_2)^2$$

$$\beta_1 = \frac{\text{small diameter}}{\text{large diameter}} = \frac{0.305}{1.5} = 0.20$$

$$\beta_2 = \frac{0.254}{1.5} = 0.17$$

$$K_1 = (1 - (0.2)^2)^2 = 0.922, K_2 = 0.5 (1 - 0.17^2) = 0.485$$

$$K = 1.407$$

$$\rho \text{ (at 3.1 bara)} = \frac{16.9 \times (3.1 \times 14.5038)}{10.73 \times 393} = 0.180 \text{ lb/cuft}$$

$$v = \frac{61.3 \text{ lb/sqft} \cdot \text{s}}{0.180 \text{ lb/cuft}} = 340.2 \text{ fps}$$

$$\Delta p = \frac{1.407 \times 0.180 \times (340.2)^2}{9266} = 3.16 \text{ psi} = 0.22 \text{ bar}$$

Pressure just upstream the relief scrubber is (3.07 + 0.22) bar
= 3.3 bara

CALCULATION NOTES

CLIENT: E.A.N. PROJECT: TCP-2 Extension SHEET 6 OF 9
 DISCIPLINE: Process ENGINEER: JIN REF.: JIN/asb
 SUBJECT: Back pressure calcs - LT relief header

4. Back pressure from 4 to 5 (Ref. fig. 1)Calculation of N_T

Length 55 m 180.5 ft
 11 long rad 90° ell (K = 11 x 0.45) K = 4.95
 2 long rad 45° ell (K = 0.2 x 2) K = 0.40

$$N_T = \frac{4 \times 0.0024 \times 180.5}{10.42/12} + 5.35 = \underline{7.3}$$

Back pressure calcs

Results

Downstream pressure (P_1) 3.3 bara	TRIAL 1	TRIAL 2	TRIAL 3
Upstream pressure P_o	4.4	4.9	5.4
P_1/P_o	0.75	0.67	0.61
G/G_{ci}	0.39	0.42	0.44
G_{ci} lb/sqft,s	166.75	185.70	204.65
G lb/sqft,s	65.0	78.0	90.1

"Actual" G is (10" pipe)


$$\frac{83380 \times 2.20462}{3600 \times \frac{\pi}{4} \left(\frac{10.42}{12}\right)^2} = 86.2 \text{ lb/sqft,s}$$

The above results are presented in fig. 4.

Conclusion: The pressure at point 5 is 5.23 bara

BACK PRESSURE - POINT 4 TO POINT 5

FIG 4

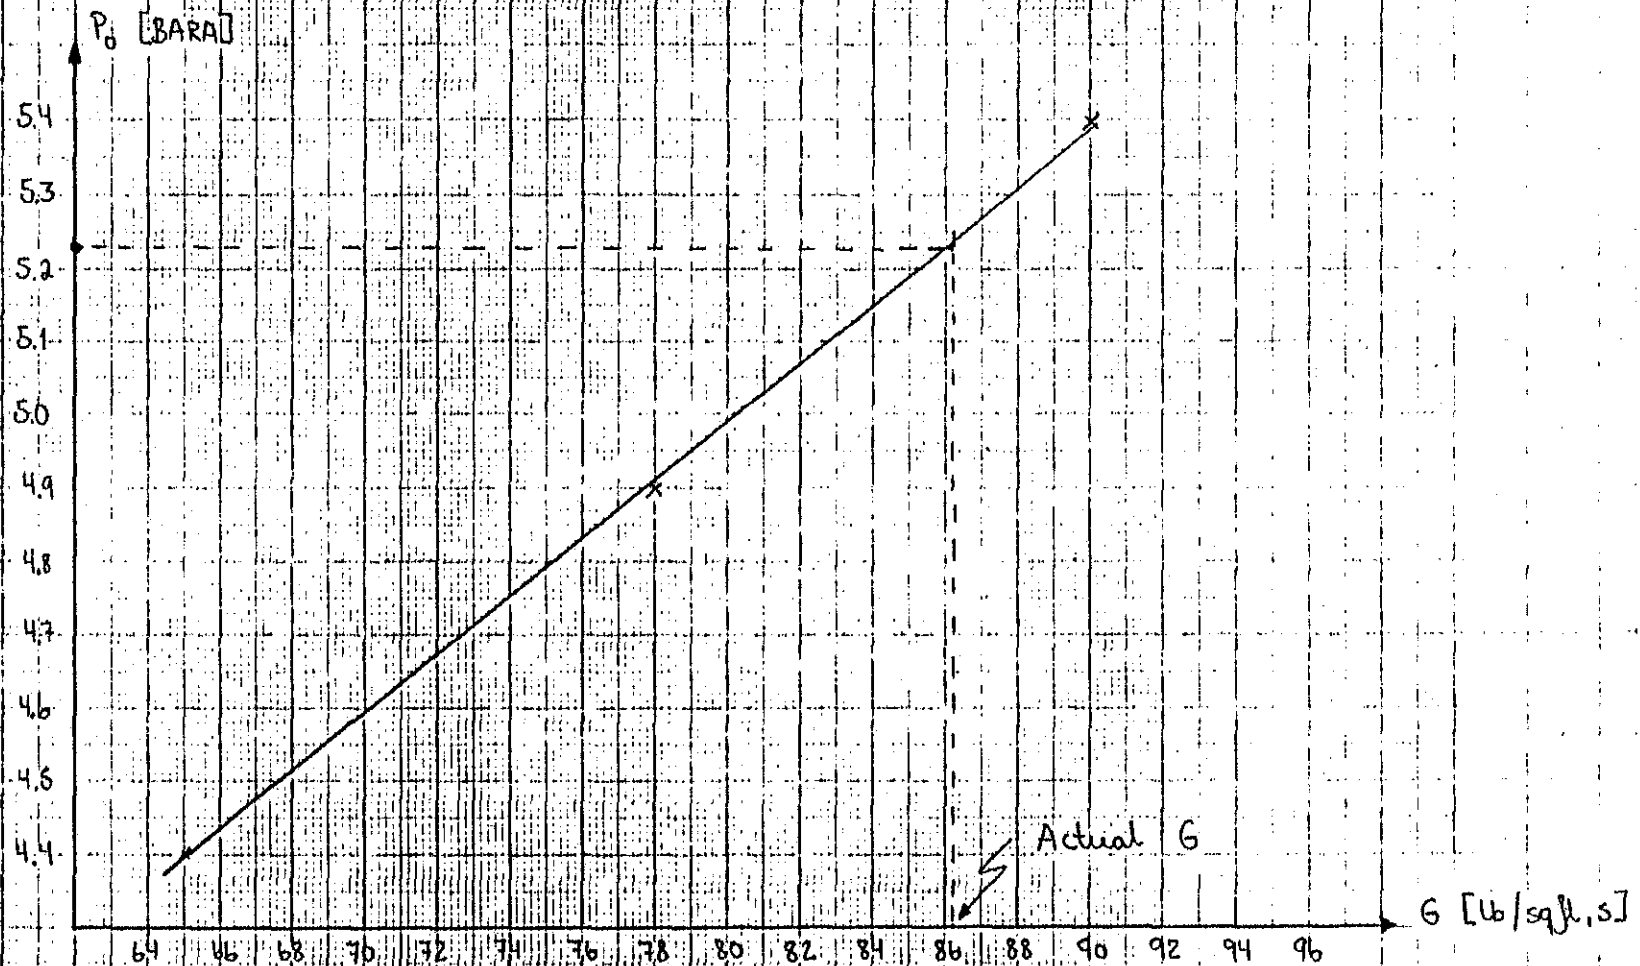

14.07.81 JIN

CALCULATION NOTES

CLIENT: E.A.N.

PROJECT: TCP-2 Extension

SHEET 7 OF 9

DISCIPLINE: Process

ENGINEER: JIN

REF.: JIN/asb

SUBJECT: Back pressure calcs - LT relief header

5. Back pressure from 5 to 6 (Ref. fig. 1)

Calculation of N_T

Lenght 7.1 m = 23 ft

1 long rad 90° ell (K = 0.45) = 0.45

1 Tee through branch (K=1.0) = 1.0

$$N_T = \frac{4 \times 0.0024 \times 23}{10.42/12} + 1.45 = 1.7$$

Back pressure calcs

Results

Downstream pressure (P_1) 5.23 bara	TRIAL 1	TRIAL 2	TRIAL 3
Upstream pressure bara	5.4	5.5	5.8
P_1/P_0	0.97	0.95	0.90
G/Gci	0.23	0.31	0.44
Gci lb/sqft,s	204.65	208.44	219.80
G lb/sqft,s	47.07	64.62	96.71


The above results are presented in fig. 5.

Conclusion: The pressure at point 6 is 5.70 bara

Max back pressure in LT relief system is 5.7 bara

BACK PRESSURE - POINT 5 TO POINT 6

FIG 5

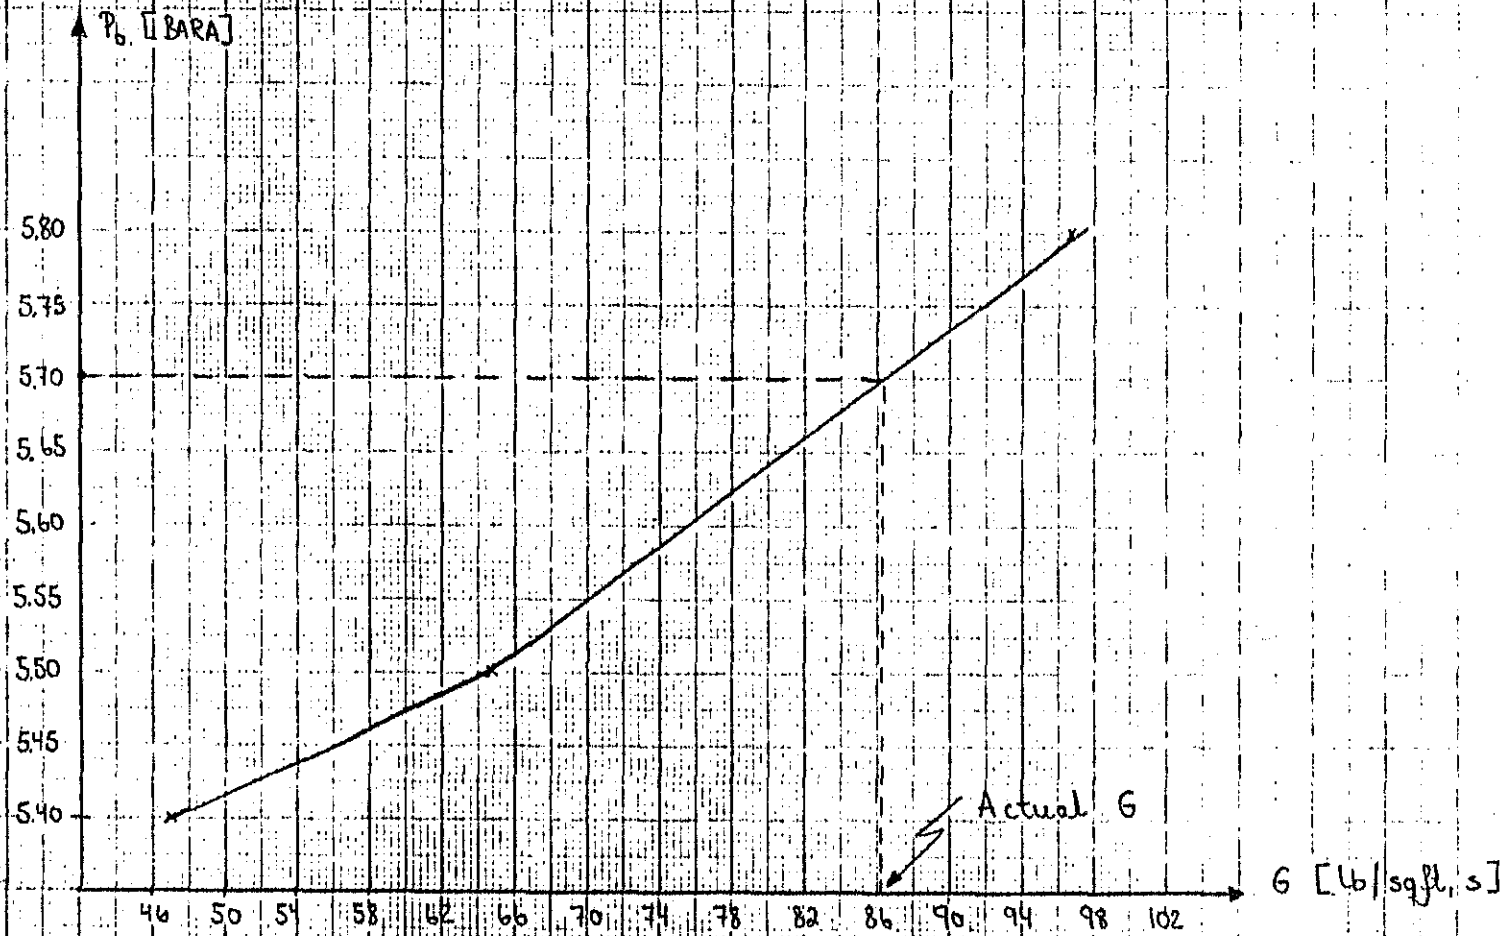

CALCULATION NOTES

CLIENT: E.A.N PROJECT: TCP-2 Extension SHEET 8 OF 9
 DISCIPLINE: Process ENGINEER: JIN REF.:
 SUBJECT: HP Relief system (Bypass of cold vent)

ii) HP - RELIEF SYSTEM

Piping class ECX

Pipe size 10" $\Rightarrow ID = (10.75 - 2 \cdot 0.56)'' = 9.63 \text{ in}$ Flowing area: $\pi/4 ID^2 = 0.04699 \text{ m}^2 = 0.506 \text{ ft}^2$

Back pressure at tie in (ref. fig. 7) : 7.3 bara

Flowrate 8.4 MSCMD = 250140 kg/hr (551463 lb/hr)

$$\text{Density: } \rho = \frac{16.9 \cdot 7.3}{0.08314 \cdot 233 \cdot 0.97} = 6.6 \text{ kg/m}^3$$

$$\text{Velocity } v = \frac{250140}{6.6 \cdot 3600 \cdot 0.04699} = 224.0 \text{ m/sec}$$

$$\text{Mach no: } \frac{224}{386.4} = 0.58$$

$$\text{Reynold no: } R_e = \frac{\rho \cdot v \cdot ID}{\mu} = \frac{6.6 \cdot 224 \cdot 0.245}{0.011 \cdot 0.001} = 32934295$$

$$f = \frac{0.04}{R_e^{0.172}} = 0.00203$$

Calculation of N_T

Length 13m = 43.00 ft

8 long rad ell $K = 8 \cdot 0.32 = 2.56$ 1 Tee $K = 1.72$ 1 enlargement $K = 0.41$ 1 check valve $K = 2.3$ 1 ball valve $K = 0.21$ $\Sigma 43 \text{ ft} + 7.20$

$$N_T = \frac{4f \cdot L}{ID} + \Sigma K = \frac{4 \cdot 0.00203 \cdot 43}{0.8025} + 7.2 = 7.6$$

CALCULATION NOTES

CLIENT: E.A.N PROJECT: TCP-2 Extension SHEET 9 OF 9
DISCIPLINE: Process ENGINEER: JIN REF.:
SUBJECT: HP Relief svstem (Bypass of cold vent)

$$G_{ci} = 12.6 P_o \left(\frac{M}{T_o} \right)^{0.5}$$
$$= 12.6 P_o \left(\frac{16.9}{420} \right)^{0.5} = 2.527 P_o$$

$P_1 = 7.3$ BARA	TRIAL 1	TRIAL 2	TRIAL 3
Upstream pressure, P_o	10	14	18
P_1 / P_o	0.73	0.52	0.405
G / G_{ci}	0.38	0.44	0.48
G_{ci}	366.6	513.2	659.8
G	139.3	225.8	316.7

Calculation of "actual" G:


$$G = \frac{551463}{3600 \cdot 0.506} = 302.7 \text{ lb/sec, sqft}$$

From attached figure, the max back pressure in the HP relief system for TCP 2 Extension is 17.4 Bara.

BACK PRESSURE - HP RELIEF SYSTEM

FIG. 6

P. (BAR)

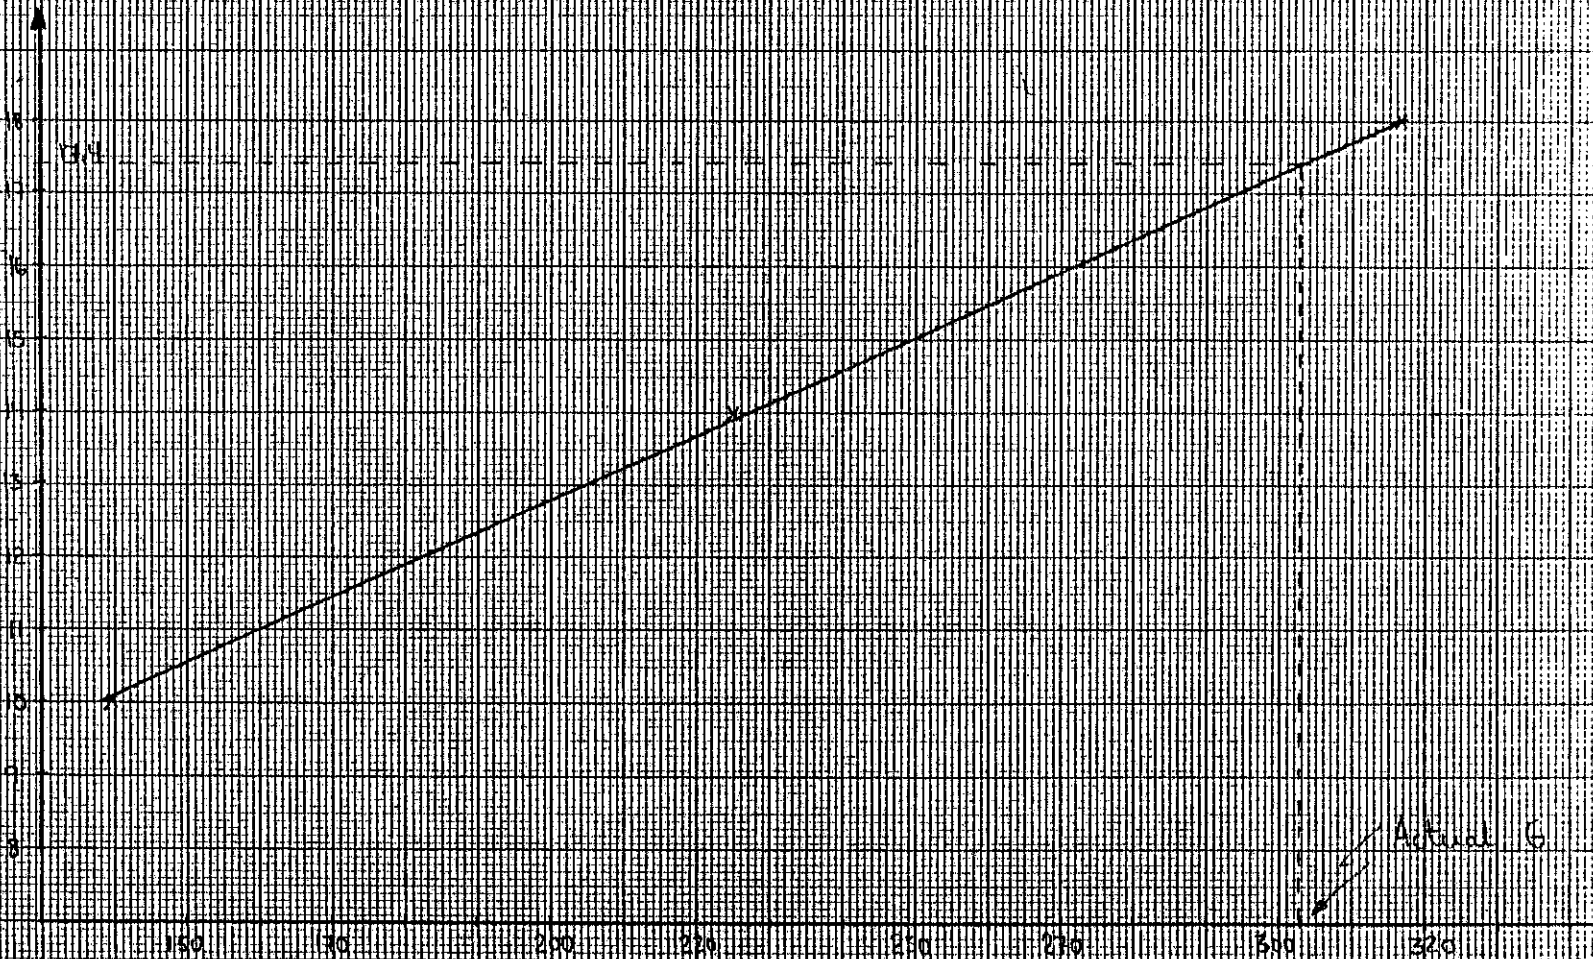

G (l/s)

2/07/81 JIN

6

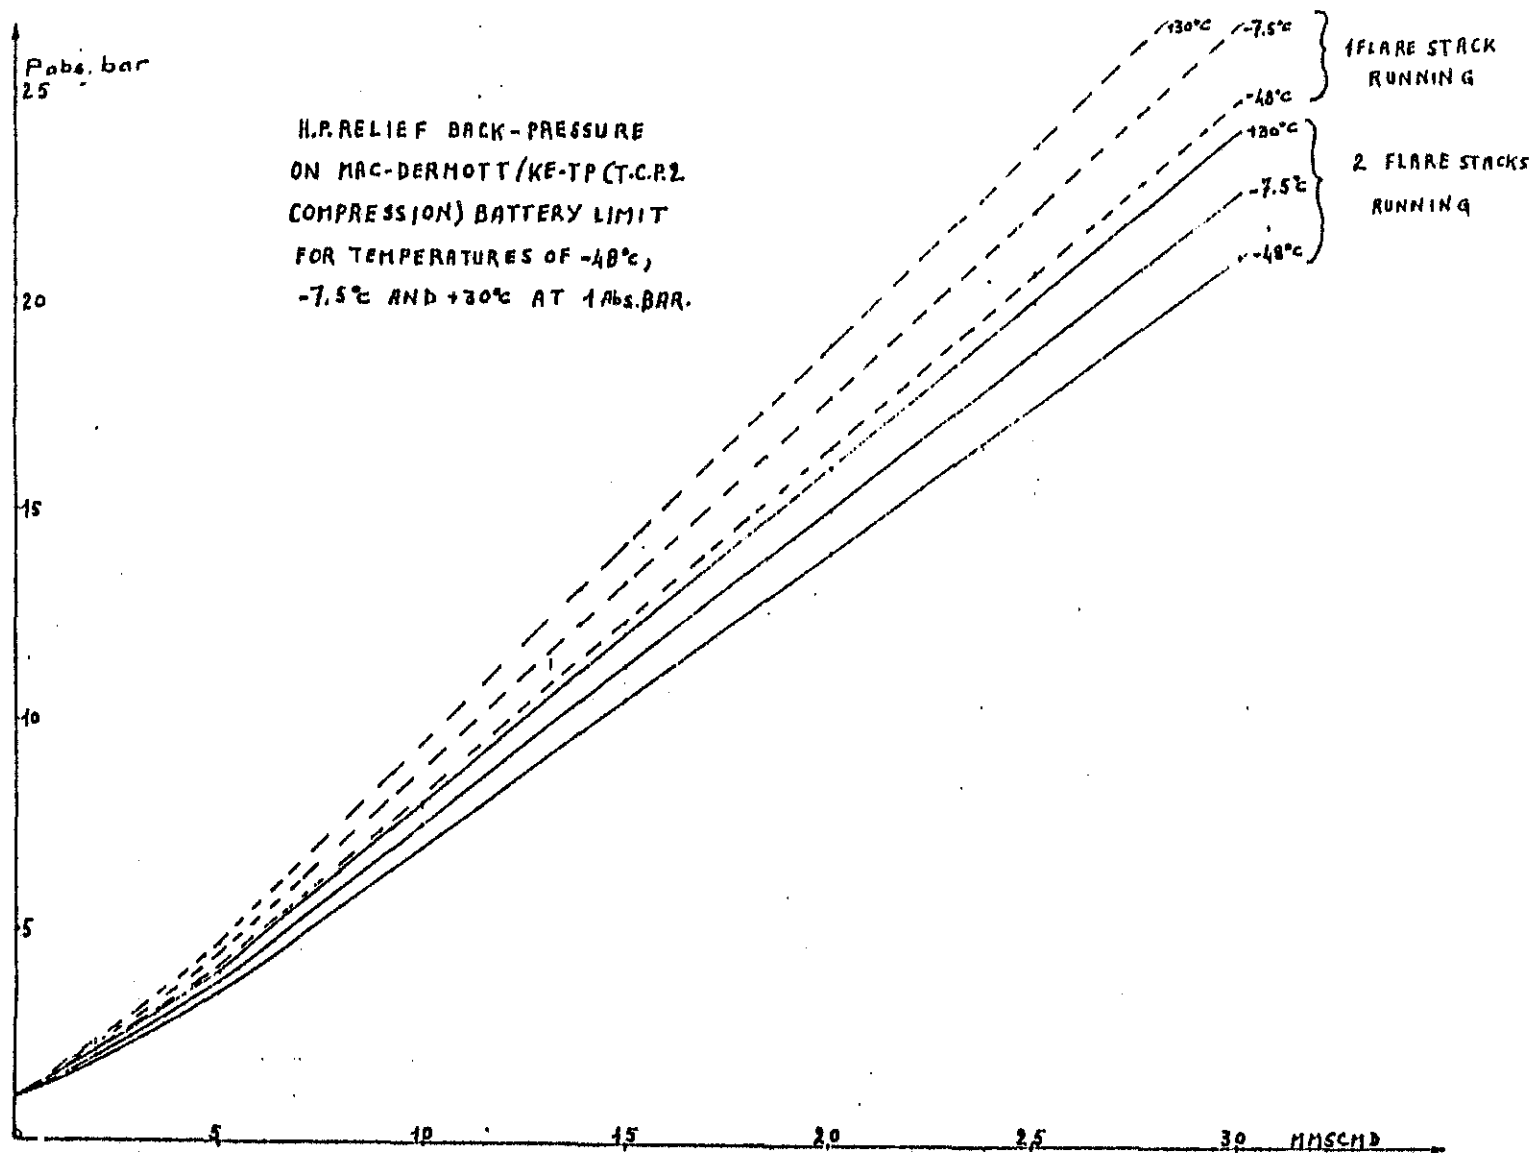


FIG. 7

APPENDIX 10

CALCULATION OF TEMPERATURE DOWNSTREAM
OF THE BLOW DOWN VALVES

CALCULATION NOTES

CLIENT: E.A.N.

PROJECT: TCP-2 Extension

SHEET 1 OF 1

DISCIPLINE: Process

ENGINEER: JIN

REF.: JIN/asb

SUBJECT: Calculation of temperature downstream the blowdown valves

Basic

The method for calculating the temperature downstream of the blowdown valves, is based on the correlations outlined in GPSA Engineering Data Book, section 17. (Page 17-6 is attached for information.)

Assumptions:

1. The gas composition is identical to the ODIN gas composition.
2. The upstream pressure is taken at 160 bara, the downstream pressure at 2 bara.
3. The upstream temperature is 5°C (41°F)

The calculation results are given below.

Conclusion: Temperature downstream of the blowdown valves is estimated to be around - 75°C.
(Based on extrapolation between the values given below).

chart. The pure component critical temperatures (T_c), critical pressures (P_c) and acentric factors (ω) are given in the table of physical constants, Section 16, Physical Properties.

The reduced temperature and pressure are defined as $T_r = T/T_c$ and $P_r = P/P_c$, where absolute temperatures and pressures are used. The units of $(H^\circ - H)$ will depend on the units of R , the universal gas constant, and T_c . For $(H^\circ - H)$ values of Btu/lb mole, $R = 1.986$ Btu/lb mole $^\circ R$, and T_c is in $^\circ R$.

Note that the ideal gas state enthalpies are given in units of Btu/lb; therefore, the component molecular weight must be used for converting either the ideal gas state enthalpy or the effect of pressure on the enthalpy before substituting into Equation 3.

Undefined mixtures—Very often the enthalpy of petroleum fractions or of the C_7+ in natural systems must be calculated. For this case average or pseudo properties are used for the undefined mixture. Generally the specific gravity, molecular weight and ASTM or true boiling point distillation will be known.

Figs. 16-18 through 16-20, Section 16 relate ASTM distillation, molecular weight, specific gravity, critical temperature, and critical pressure of petroleum fractions. Once the last four quantities are known, the ideal gas state enthalpy for the petroleum fraction can be obtained from Fig. 17-12.

An acentric factor can be estimated by using Fig. 16-21, Section 16. Then the effect of pressure on enthalpy for the petroleum fraction is found using the figures for $[(H^\circ - H)/RT_c]^{(0)}$ and $[(H^\circ - H)/RT_c]^{(1)}$ and Equation 4 exactly as was done for a pure component. The enthalpy of the undefined mixture is calculated as shown by Equation 3.

Defined mixtures—The enthalpy of a mixture for which a component analysis is known can be calculated by combining pure component data and constants. The mixture ideal gas state enthalpy is calculated by a mole fraction average of the pure component ideal gas state enthalpies.

$$H_m^\circ = \sum_i x_i H_i^\circ \quad (5)$$

where x_i is the mole fraction of the i th component.

Equation 5 assumes no heat of mixing in the ideal state because the molecules are at infinite attenuation and should not affect one another.

Pseudocritical temperatures and pressures can be calculated for the mixture using Kay's rule.⁴

$$T_{cm} = \sum_i x_i T_{ci} \text{ and } P_{cm} = \sum_i x_i P_{ci} \quad (6)$$

The mixture acentric factor is also calculated as a mole fraction average of pure component acentric factors.

$$\omega_m = \sum_i x_i \omega_i \quad (7)$$

Other methods for obtaining pseudocriticals are more sophisticated than Kay's rule and in many cases give better results. These sophisticated methods usually involve complex equations and/or interaction parameters. For desk calculations Kay's rule is very convenient, while for computer calculations a more complex method can be used.

The pseudocriticals are used to calculate pseudo-

reduced temperature and pressure in order to obtain values of $[(H^\circ - H)/RT_c]^{(0)}$ and $[(H^\circ - H)/RT_c]^{(1)}$. The mixture acentric factor and pseudocritical temperature are then used to calculate $(H^\circ - H)_m$, the effect of pressure on enthalpy for the mixture.

$$(H^\circ - H)_m = RT_{cm} \{ [(H^\circ - H)/RT_c]^{(0)} + \omega_m [(H^\circ - H)/RT_c]^{(1)} \} \quad (8)$$

The value of the mixture enthalpy at the desired temperature and pressure is found by substituting H_m° and $(H^\circ - H)_m$ for H° and $(H^\circ - H)$ in Equation 3.

The enthalpy of a two-phase mixture should be calculated by first performing a flash calculation in order to obtain the moles and composition of each phase at the desired conditions. Then the enthalpy of each phase should be calculated as described above. The molar enthalpy of the total mixture is calculated by combining the gas and liquid phase enthalpies on a mole basis.

Total enthalpy charts. Total enthalpy charts are included in Figs. 17-20 through 17-28 in order to offer a rapid means of calculating heat balances essentially on the same basis as outlined in the preceding sections of the Enthalpy Correlation. They may be used in lieu of the detailed component-wise calculations for all vapor, all liquid, or vapor-liquid mixture enthalpies. The charts cover the range of composition, temperature and pressure encountered in most natural gas systems from wellhead separators through liquefied natural gas systems.

The total enthalpy charts were developed in a computer program by synthesizing binary mixtures of normal paraffin hydrocarbons using the pure component lighter and heavier than the molecular weight for which enthalpies are to be calculated. Molecular weights were calculated in increments of 2 from 16 to 30 MW and in increments of 5 from 30 MW through 160 MW.

The ideal gas state enthalpy for each component of the binary mixture was calculated and then the mixture ideal enthalpy calculated. The ideal gas state enthalpy for methane, ethane, and propane is a curve fit of the data in Fig. 17-11A. For butane and heavier, a fourth order polynomial was used with the same coefficients as listed in the API Data Book, Table A1.2 page 7-9. The fifth coefficient, "E", was dropped to convert to $0^\circ R$, 0 psia enthalpy datum.

The ideal gas state enthalpy was then corrected for the effect of pressure on enthalpy of the simple and real fluid using interpolation of tabular data used to derive Figs. 17-13 and 17-14. Pressure calculations were made from reduced pressures of 0.2 to 3000 psia in increments of 100 psi. Temperatures used ranged from $-300^\circ F$. minimum or $T_R = 0.35$ minimum to $600^\circ F$. in increments of $50^\circ F$.

Caution. Inevitably some mixtures encountered in the natural gas industry lie inside the phase envelopes of Figs. 17-13 and 17-14. Rather than extrapolate into the phase envelopes of Figs. 17-13 and 17-14 for enthalpy pressure corrections, the total enthalpies were first generated, plotted, and then extrapolated.

Extensions of vapor enthalpies to lower temperatures
(Text cont'd. p. 17-18)

CALCULATION OF TEMPERATURE DOWNSTREAM
THE BLOWDOWN VALVES

								TRIAL I		TRIAL II	
COMP	MW	IDEAL GAS STATE ENTHALPIES AT 41°F		FRACTION	CRITICAL TEMP, °R	CRITICAL PRES, PSIA	ACENTRIC FACTOR	IDEAL GAS STATE ENTHALPIES AT - 100°F		IDEAL GAS STATE ENTHALPIES AT - 90°F	
		BTU/LB	BTU/LB-MOL					BTU/LB	BTU/LB-MOL		
N2	28	124	3473.2	0.92	227.6	493	0.040	88	2464.9	84	2352
CO2	44	84	3696.8	0.24	547.6	1071	0.225	56	2464.6	58	2552.6
C1	16	250	4010.0	94.81	343.1	667.8	0.0104	175	2807.0	102	2919.3
C2	30.1	157	4721.0	3.85	549.8	707.8	0.0986	102	3067.1	110	3207.7
C3	44.1	130	5733.0	0.06	665.7	616.3	0.1524	80	3528.0	85	3748.5
1C4	58.1	120	6974.4	0.01	734.7	529.1	0.1848	70	4068.4	75	4357.5
C4	58.1	130	7555.6	0.02	765.3	550.7	0.2010	80	4649.6	85	4938.5
1C5	72.15	120	8658.0	0.02	828.8	490.4	0.2223	70	5050.5	75	5411.3
C5	72.15	127	9163.1	0.02	845.4	488.6	0.2539	78	5627.6	85	6132.8
C6	86.2			0.05	912.0	470	0.290				
Temperature, °F					41			-100		-90°	
Pressure, PSIA					2320			29.0		29.0	
Pseudocritical temp, °R					351.3			351.3		351.3	
Pseudocritical pres, PSIA					668.5			668.5		668.5	
Reduced temp					1.426			1.02		1.05	
Reduced pres					3.47			0.04		0.04	
Acentric factor					0.015			0.015		0.015	
$(H^0-H)/RT_c$					1.85			0.042		0.038	
$(H^0-H)/RT_c$					0.34			-		-	
$(H^0-H)/RT_c = (H^0-H)/RT_c^0 + W_m(H^0-H)/RT_c^1$					1.85			0.042		0.038	
$(H^0-H)_m$ BTU/lb mol					1291			29.30		26.51	
H_m BTU/lb mol					4033.7			2813.6		2928.9	
H_m BTU/lb mol					2743			2784.3		2902.4	
Enthalpy Difference								41.3		159.4	

APPENDIX 11

FIRE PROTECTION - LIQUID VAPOURIZATION

- GAS EXPANSION

CALCULATION NOTES

CLIENT: E.A.N.

PROJECT: TCP-2 Extension

SHEET 1 OF 8

DISCIPLINE: Process

ENGINEER: JIN

REF.: JIN/asb

SUBJECT: Fire protection - Liquid vapourization

Formula used (ref. API RP 520)

Total heat absorption from fire

$$Q = 21000 F \times A^{0.82}$$

Q = total heat absorption BTU/hr

A = total wetted area sqft

F = environment factor, for bare vessel F = 1.0

1. Slug catcher CV 210 (PSV V 210 1/2)

Max liquid level (which corresponds to LSHH) is at 1650 mm. Vessel size is 2400 ID x 9140 T/T.

$$\begin{aligned} \text{Wetted area } A &= \left[\pi \times \text{ID} \times L + \pi \times \text{ID}^2 \right] \frac{1650}{2400} = 60 \text{ m}^2 \\ &= 632 \text{ sqft} \end{aligned}$$

$$Q = 21000 \times 632^{0.82} = 4.157 \text{ 261 BTU/hr}$$

Condensate latent heat is 72 kcal/kg

$$\text{Weight flow rate } \frac{4157 \text{ 261} \times 0.252}{72} = 14550 \text{ kg/hr}$$

(0.489 MSCM/D)

CALCULATION NOTES

CLIENT: E.A.N.	PROJECT: TCP-2 Extension	SHEET 2 OF 8
DISCIPLINE: Process	ENGINEER: JIN	REF.: JIN/asb
SUBJECT: Fire protection - Liquid vapourization		

2. Condensate / Methanolated water separator - ODIN CV 204
(PSV V 204 1/2)

Vessel size is 1000 ID x 4000 T/T.

Max liquid height is equal to 750 mm.

$$\text{Wetted area } A = (\pi \times 1.0 \times 4.0 + \pi \times 1.0^2) \times 0.75 = 11.8 \text{ m}^2$$

(130 sqft)

$$Q = 21000 \times 130^{0.82} = 1136718 \text{ BTU/hr}$$

$$\text{Weight flow rate } \frac{1136718 \times 0.252}{72} = 3978 \text{ kg/hr}$$

$$\underline{(0.134 \text{ MSCM/D})}$$

3. Condensate / Methanolated water separator NEF CV 213
(PSV V 213 1/2)

The vessel is identical to CV 204

Flow rate will therefore be 3978 kg/hr

$$\underline{(0.134 \text{ MSCM/D})}$$

4. Methanolated water flash drum - CV 220

Vessel size is 900 ID x 2900 T/T.

Max liquid height is equal to 550 mm.

$$\text{Wetted area } A = (\pi \times 0.9 \times 2.9 + \pi \times 0.9^2) \times \frac{0.55}{0.9} = 6.6 \text{ m}^2$$

(71 sqft)

CALCULATION NOTES

CLIENT: E.A.N.

PROJECT: TCP-2 Extension

SHEET 3 OF 8

DISCIPLINE: Process

ENGINEER: JIN

REF.: JIN/asb

SUBJECT: Fire protection - Liquid vapourization

$$Q = 21000 \times 71^{0.82} = 69261 \text{ BTU/hr}$$

$$\text{Weight flow rate } \frac{69261 \times 0.252}{72} = 2424 \text{ kg/hr}$$

(0.080 MSCM/D)

5. Pig receiver - ODIN CM 201 (PSV M 201.1)

△ Size of equipment is 550 ID x 4000 T/T.

Wetted area $A = \pi \times 0.55 \times 4 \times \frac{1}{2} = 3.46 \text{ m}^2 (37.2 \text{ sqft})$
(assuming pig receiver half full of liquid)

$$Q = 21000 \times (37.2)^{0.82} = 407441 \text{ BTU/hr}$$

$$\text{Weight flow rate } \frac{407441 \times 0.252}{72} = 1425 \text{ kg/hr}$$

(0.050 MSCM/D)

CALCULATION NOTES

CLIENT: E.A.N.

PROJECT: TCP-2 Extension

SHEET 4 OF 8

DISCIPLINE: Process

ENGINEER: JIN

REF.: JIN/asb

SUBJECT: Fire protection - Liquid vapourization

6. Slug catcher CV 1A (PSV VIA 6/7)

This is an existing vessel. In case of fire the vapour will release to the HP relief system. The relief flowrate is identical to

0.455 MSCM/DSummary - Liquid vapourization

Vessel	Wetted ₂ area m ²	Flowrate		Flare system
		KG/hr	MSCM/D	
CV 210	60.0	14550	0.489	Low temperature
CV 1A	-	-	0.455	High pressure
CV 204	11.8	3978	0.134	Low pressure
CV 213	11.8	3978	0.134	Low pressure
CV 220	6.6	2424	0.080	Low pressure
△ CM 201	3.5	1425	0.050	Low temperature

CLIENT: E.A.N.	PROJECT: TCP-2 Extension	SHEET 5 OF 8
DISCIPLINE: Process	ENGINEER: JIN	REF.:
SUBJECT: Fire protection - Gas expansion		

Relief rates from thermal gas expansion due to fire



The relief rates from gas expansion due to fire has been calculated according to API RP 520 appendix C paragraph C 3 for the calculation without insulation and section 6 paragraph 6.3.1 for the insulation effect on the above calculations.

The discharge area for safety relief valves on gas containing vessels exposed to open fires, can be determined using the formula

$$\triangle \quad A = \frac{F^1 A_3}{\sqrt{P_1}}$$

where A = effective discharge area of the valve in sqin

P₁ = upstream relieving pressure in psia



A₃ = exposed surface area of vessel plus surrounding pipes in sqft

F¹ = an operating factor determined by

$$F^1 = \left(\frac{0.1406}{C \cdot K} \right) \left(\frac{\Delta T^{1.25}}{T_1^{0.6506}} \right)$$

where

$$C = 520 \sqrt{k \left(\frac{2}{k+1} \right)^{\frac{k+1}{k-1}}}$$

k = $\frac{C_P}{C_V}$ = ratio of specific heats

K = coefficient of discharge = 0.975

T₁ = gas temperature in degrees F +460 at the upstream pressure.

It is determined from the relationship

$$T_1 = \left(\frac{P_1}{P_n} \right) T_n$$

CALCULATION NOTES

CLIENT:	E.A.N	PROJECT:	TCP-2 Extension	SHEET 6	OF 8
DISCIPLINE:	Process	ENGINEER:	JIN	REF.:	
SUBJECT:	Fire protection - Gas expansion				

where T_n = normal operating gas temperature in degrees F +460

P_n = normal operating pressure in psia

$\Delta T = T_w - T_1$ = difference between wall temperature
and the temperature of gas at P_1

T_w = vessel wall temperature in degrees F +460

△ As the vessel and the surrounding pipes are insulated, this must be taken into account in order to estimate the vessel wall temperature.

From API RP 520 page 15:

The outside temperature of the insulation jacket in case of fire exposure will reach an equilibrium temperature of 1660°F.

From API RP 520 page 11:

In practice it is recommended that insulation jacket selected to provide a temperature difference of at least 1000°F.

From this is concluded that the max temperature of the vessel wall is:

$$T_w = (1660 - 1000)^{\circ}\text{F} = \underline{660^{\circ}\text{F}}$$

Calculation of F^1

$$T_w = 660^{\circ}\text{F} + 460 = 1120^{\circ}\text{R}$$

$$T_n = 5^{\circ}\text{C} = 41^{\circ}\text{F} + 460 = 501^{\circ}\text{R}$$

$$P_n = 149 \text{ bara} = 2161 \text{ psia}$$

$$P_1 = 177.5 \text{ bara} \times 1.1 = 2832 \text{ psia}$$

$$T_1 = \frac{2832}{2161} \times 501 = 656.6^{\circ}\text{R} = 196.6^{\circ}\text{F}$$

$$\Delta T = T_w - T_1 = 1120 - 656.6 = 463.4$$

$$k = \frac{CP}{CV} = 1.30 \text{ at standard conditions}$$

$$C = 520 \sqrt{1.3 \left(\frac{2}{2.3}\right)^{\frac{2.3}{0.3}}} = 347$$

CALCULATION NOTES

CLIENT:	E.A.N.	PROJECT:	TCP-2 Extension	SHEET	7	OF	8
DISCIPLINE:	Process	ENGINEER:		REF.:			
SUBJECT:	Fire protection - Gas expansion						

$$F^1 = \left(\frac{0.1406}{347 \times 0.975} \right) \left(\frac{463.4^{1.25}}{656.6^{0.6505}} \right) = 0.01314$$

Gas flow rate to be relieved is calculated using

$$W = CKAP_1 \frac{M}{ZT_1}$$

where W = flow through valve in lb/hr

M = molecular weight = 16.9

Z = compressibility factor at T_1 and P_1 = 0.98

CALCULATION NOTES

CLIENT: E.A.N.	PROJECT: TCP-2 Extension	SHEET 8 OF 8
DISCIPLINE: Process	ENGINEER: JIN	REF.:
SUBJECT: Fire protection - Gas expansion		

Calculation for Scrubber CV 211

The total exposed area used in the below calculations is based upon the area of the vessel itself plus surrounding pipelines. The area of the surrounding pipelines is defined as the area of the pipes to/from CV 211 within Module 50.

Area of vessel: 8.2 m^2

Area of pipes: 42.5 m^2

Total area $A_3 = 50.7 \text{ m}^2 = 545.4 \text{ sqft}$

$$\triangle A = \frac{0.01314 \times 545.4}{\sqrt{2832}} = 0.1346 \text{ in}^2$$

$$\triangle W = 347 \times 0.975 \times 0.1346 \times 2.832 \sqrt{\frac{16.9}{0.98 \times 656.6}} = 20903 \text{ lb/hr}$$

$$9482 \text{ kg/hr}$$

$$(0.319 \text{ MSCM/D})$$

Calculation for Scrubber CV 201

Area of vessel: 11.9 m^2

Area of pipes: 92.3 m^2

Total area $A_3 = 104.2 \text{ m}^2 = 1122 \text{ sqft}$

$$\triangle A = \frac{0.01304 \times 1122}{\sqrt{2832}} = 0.277$$

$$\triangle W = 347 \times 0.975 \times 0.277 \times 2832 \sqrt{\frac{16.9}{0.98 \times 656.6}} = 43003 \text{ lb/hr}$$

$$19506 \text{ kg/hr}$$

$$(0.656 \text{ MSCM/D})$$

APPENDIX 12

BACK PRESSURE CALCULATIONS

LP VENT SYSTEM TO GLYCOL SURGE DRUMS CV 17

CALCULATION NOTES

CLIENT:	E.A.N.	PROJECT:	TCP-2 Extension	SHEET	1 OF 2
DISCIPLINE:	Process	ENGINEER:	JIN	REF.:	
SUBJECT:	Back pressure calculations CV 17				

An important leakage on the tube side of the condensate heaters, may reduce the TEG circulation flow to zero because the tube side pressure is higher than the shell side pressure.

In this case the flow of condensate, gas and methanolated water will pass through on the shell side. The maximum flow rate corresponds to 3382 kg/hr which is the figure given on Process Flowsheet 88 00 00 5101.

The released gas will be evacuated through the existing 2" breather line to the LP vent system.

The back pressure is calculated using the Darcy formula:
(Ref. is made to Appendix 7)

$$\frac{\Delta P}{L} = \frac{4 \times f \times 0.000336 W^2}{(ID)^5 \times \rho}$$

W = 971 kg/hr (Ref. Technical Specifications, Chapter 3.6.2.4.5)

Friction factor "f" is determined from Reynolds number:

$$Re = \frac{6.32 \times W}{ID \times \rho} = \frac{6.32 \times 2141}{2.067 \times 0.013} = 503485$$

$$f = \frac{0.04}{Re^{0.172}} = 0.00418$$

CALCULATION NOTES

CLIENT:	E.A.N.	PROJECT:	TCP-2 Extension	SHEET	2	OF	2
DISCIPLINE:	Process	ENGINEER:	JIN	REF.:			
SUBJECT:	Back pressure calculations CV 17						

$$(\Delta P_{100}^1) = \frac{4 \times 0.00418 \times 0.000336 \times (2141)^2}{(2.067)^5 \times 0.0665} = \underline{10.3 \text{ psi/100 ft}}$$

Total length 30 m = 98.43 ft

$$\Delta P = 10.3 \times 0.9843 = 10.1 \text{ psi} = 0.7 \text{ bar}$$

Back pressure:	2.0 bara
Pressure drop:	<u>0.7 bara</u>
CV 17 pressure:	2.7 bara
CV 17 design pressure:	3.07 bara

The above calculations show that the CV 17 design pressure will not be reached.

APPENDIX 13

DATA SHEETS FOR SAFETY RELIEF VALVES

**sofresid norge a.s**

SHT 35/38

PROCESS SPECIFICATION

FUNCTION/ ITEM : SAFETY VALVES

CLIENT ELF AQUITAINE NORGE A/S

PROJECT TCP 2 EXTENSION

ITEM	PSV V204.1	PSV V204.2	PSV V213.1
REF. P & ID	8800115032	8800115032	8800115032
NATURE OF FLUID	6	6	6
FLANGE RATING / FACING INLET	300 RF	300 RF	300 RF
FLANGE RATING / FACING OUTLET Δ	150 RF	150 RF	150 RF
CASE FOR RELIEF	FIRE	FIRE	FIRE
SET PRESSURE BARA	25	25	25
OVERPRESSURE PERMISSIBLE	10	10	10
REQUIRED CAPACITY KG/HR	3978	3978	3978
RELIEVING TEMPERATURE Δ °C	149	149	149
MOLECULAR WEIGHT (OF VAPOURIZED LIQUID)	17.7	17.7	17.7
COMPRESSIBILITY FACTOR	0.98	0.98	0.98
VISCOSITY (AT OPERATING CONDITIONS) cP			
SP GR LIQUID (AT OPERATING CONDITIONS)			
C _p / C _v RATIO	1.3	1.3	1.3
BACK PRESSURE BARA (MAX)	2	2	2

NOTES

3	REVISED AS NOTED	15/9/88	JIN		
2	FOR APPROVAL	12/6/81	JIN	87	
REV NO	REVISION	DATE	BY	APP	APP BY CLIENT
FILE NO	S.N NO.	CLIENT			

sofresid norge a.s

**sofresid norge a.s**

SHT 36/38

PROCESS SPECIFICATION

FUNCTION/ ITEM : SAFETY VALVES

CLIENT ELF AQUITAINE NORGE A/S

PROJECT TCP 2 EXTENSION

ITEM	PSV V213.2	PSV V220.1	PSV V220.2
REF. P & ID	8800115032	8800105033	8800105033
NATURE OF FLUID	G	G	G
FLANGE RATING / FACING INLET	300 RF	150 RF	150 RF
FLANGE RATING / FACING OUTLET	150 RF Δ 3	150 RF	150 RF
CASE FOR RELIEF	FIRE	FIRE	FIRE
SET PRESSURE BARA	25	16.2	16.2
OVERPRESSURE PERMISSIBLE	10	10	10
REQUIRED CAPACITY KG/HR	3978	2424	2424
RELIEVING TEMPERATURE Δ °C	149	246	246
MOLECULAR WEIGHT (OF VAPOURIZED LIQUID)	17.7	17.7	17.7
COMPRESSIBILITY FACTOR	0.98	1.0	1.0
VISCOSITY (AT OPERATING CONDITIONS) cP			
SP GR LIQUID (AT OPERATING CONDITIONS)			
C _p / C _v RATIO	1.3	1.3	1.3
BACK PRESSURE BARA (MAX)	2	2	2

NOTES

3	REVISED AS NOTED	15/9/81	JIN		
2	FOR APPROVAL	12/6/81	JIN	<i>[Signature]</i>	
REV NO	REVISION	DATE	BY	APP	APP BY CLIENT
FILE NO	S.N NO.	CLIENT			

sofresid norge a.s

**sofresid norge a.s**

SHT 38/39

PROCESS SPECIFICATION

FUNCTION/ITEM : SAFETY VALVES

CLIENT ELF ADUITAINE NORGE A/S

PROJECT TCP 2 EXTENSION

ITEM		PSV P 223 A.1	PSV P 223 B.1	
REF. P & ID		8800095036	8800095036	
NATURE OF FLUID		METHANOL	METHANOL	
FLANGE RATING / FACING INLET		1500 RTJ	1500 RTJ	
FLANGE RATING / FACING OUTLET		150 RF	150 RF	
CASE FOR RELIEF		BLOCKED LINE	BLOCKED LINE	
SET PRESSURE	BARA	177.5	177.5	
OVERPRESSURE PERMISSIBLE	%	0	0	
REQUIRED CAPACITY	KG/HR	0.005 M ³ /HR	0.005 M ³ /HR	
RELIEVING TEMPERATURE	°C	21	21	
MOLECULAR WEIGHT				
COMPRESSIBILITY FACTOR				
VISCOSITY (AT OPERATING CONDITIONS)	cP	0.7	0.7	
SP GR LIQUID (AT OPERATING CONDITIONS)		0.8	0.8	
C _p / C _v RATIO				
BACK PRESSURE BARA		~ 0	~ 0	

NOTES

2	FOR APPROVAL	12/6/81	JIN	87	
REV NO	REVISION	DATE	BY	APP	APP BY CLIENT
FILE NO	S.N. NO.	CLIENT			

sofresid norge a.s

**sofresid norge a.s**

SHT 37/38

PROCESS SPECIFICATION

FUNCTION / ITEM : SAFETY VALVES
CLIENT ELF ADUITAINE NORGE A/S
PROJECT TCP 2 EXTENSION

ITEM	△ 3	PSVP 225 A.1	PSVP 225 B.1
REF. P & ID		8800105033	8800105033
NATURE OF FLUID		INHIBITOR	INHIBITOR
FLANGE RATING / FACING INLET		150 RF	150 RF
FLANGE RATING / FACING OUTLET		150 RF	150 RF
CASE FOR RELIEF		BLOCKED LINE	BLOCKED LINE
SET PRESSURE	BARA	16	16
OVERPRESSURE PERMISSIBLE		0	0
REQUIRED CAPACITY	KG/HR	0.002 M ³ /HR	0.002 M ³ /HR
RELIEVING TEMPERATURE	°C	21	21
MOLECULAR WEIGHT			
COMPRESSIBILITY FACTOR			
VISCOSITY (AT OPERATING CONDITIONS)	cP ₀	0.6	0.6
SP GR LIQUID (AT OPERATING CONDITIONS)		0.8	0.8
C _p / C _v RATIO			
BACK PRESSURE BARA		1.5	1.5

NOTES

3	REVISED AS NOTED	15/9/81	JIN		
2	FOR APPROVAL	12/6/81	JIN	87	
REV NO	REVISION	DATE	BY	APP	APP BY CLIENT
FILE NO.	S.N. NO.				CLIENT

sofresid norge a.s