DWG. NO. ELN 2144 | SHEET NO. 204

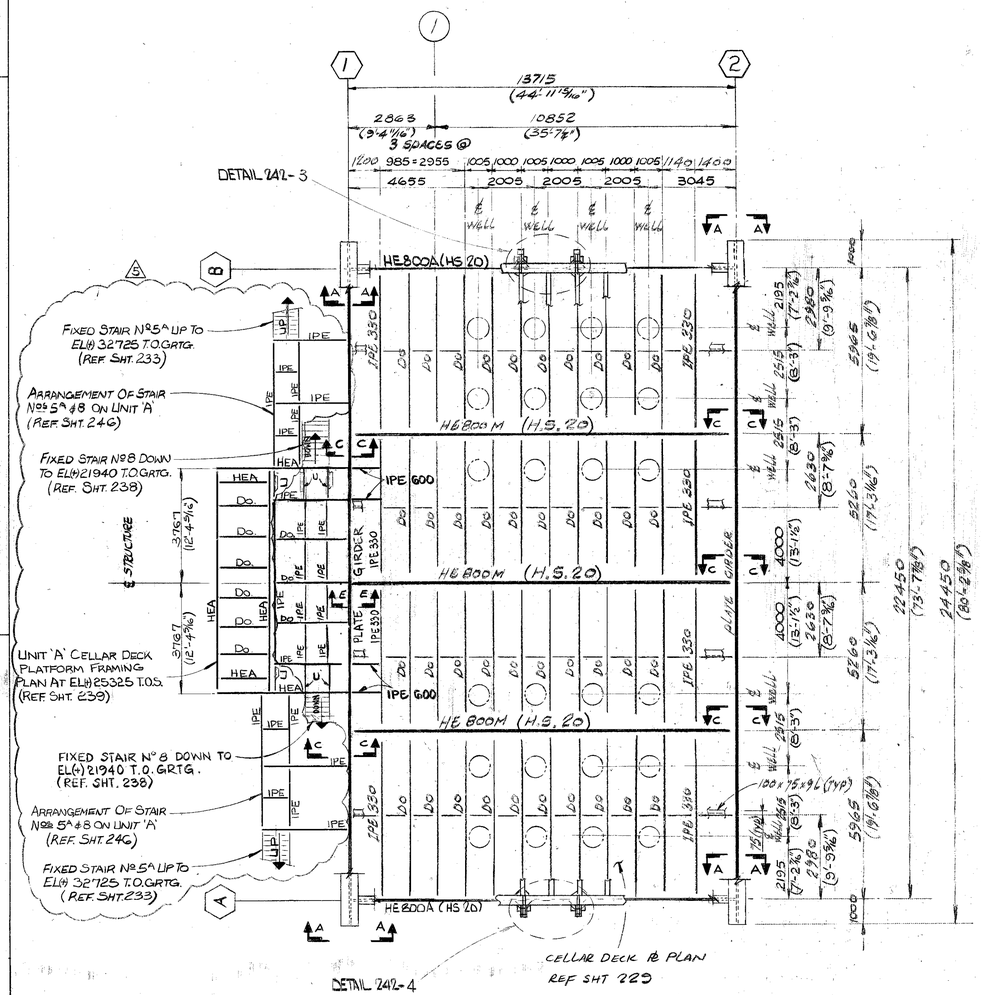

UNIT 'A' CELLAR DECK FRAMING
EL (+) 25225 T.O.S. UNLESS NOTED (+) OR (-)

(SCALE 1:100)

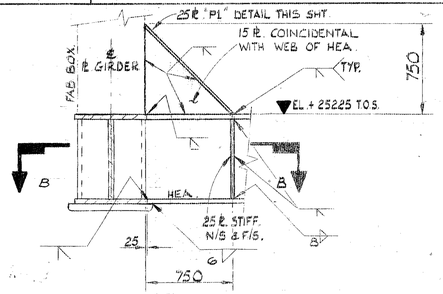

SECTION A-A
(SCALE 1:25)

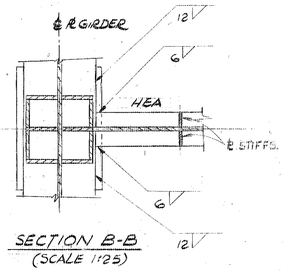

SECTION B-B
(SCALE 1:25)

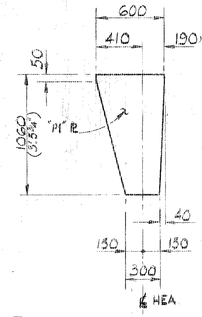

"P1" DETAIL (TRUE VIEW)
(REF SECTION A.A.)
(SCALE 1:25)

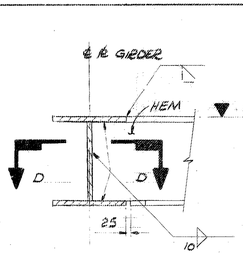

SECTION C-C
(SCALE 1:25)

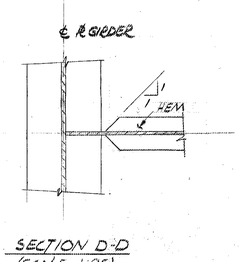

SECTION D-D
(SCALE 1:25)

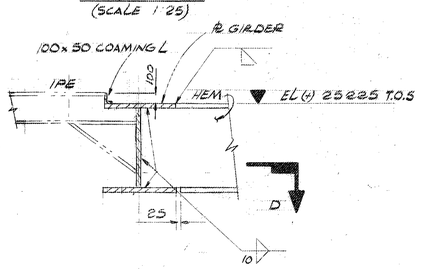

SECTION E-E
(SCALE 1:25)

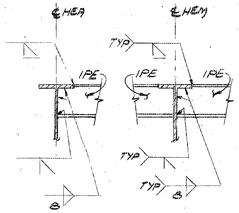

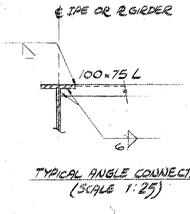

TYPICAL ANGLE CONNECTION
(SCALE 1:25)

TYPICAL BEAM CONNECTION DETAILS FOR IPE 330
(SCALE 1:25)

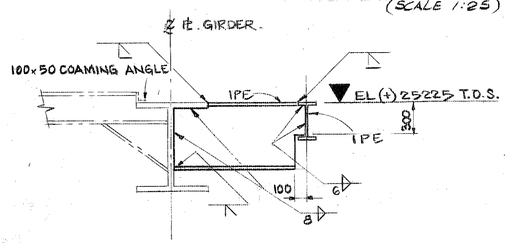

TYPICAL BEAM CONNECTION DETAILS FOR IPE 600.
(SCALE 1:25).

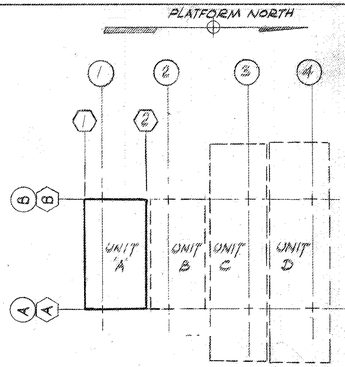

KEY PLAN

NOTES
1) DIMENSIONS IN BRACKETS ARE IMPERIAL EQUIVALENTS
2) ALL MATERIAL ON THIS SHEET TO BE (M.L.O.) UNLESS NOTED.
3) ALL WELDS TO BE FULL PENETRATION DOUBLE BEVEL BUTT WELD UNLESS NOTED.

FAB. STDS. REQ'D. THIS SHT

DESIGN	ELEC.	INSTR.	PIPING	STRUCT	NO.	BY	DATE	REVISIONS	DATE	APP.
				RB	5	LAB	22-8-77	STAIRS N°5A REPOSITIONED & PLATFM EXTENDED	3-1-77	RB

DESIGN	ELEC.	INSTR.	PIPING	STRUCT	NO.	BY	DATE	REVISIONS	DATE	APP
					4	PB.	26 Aug 76	GIRDER & STIFFS ADDED ON SECT AA. STIFFS ADDED. ON SECT BB. "P1" DETAIL ADDED.	27 Aug 76	RB
					3	KMS	17-7-76	DETAILS 242-3 & 242-4 ADDED	16 Aug 76	RB
					2	T.M.	21-1-76	STAIRS N°5^A & 8 & 8 GOG'S ADDED PLATFORM NOW DETAILED ON SHT 233 REF SHT 229 ADDED	2-3-76	RB
					1	BH.	26/3/76	LANDING MODIFIED & HOLD REMOVED.	22 Oct 76	RB

ELF-NORGE A/S
NORWAY

DRILLING PLATFORM N°2
NORTH SEA — FRIGG FIELD — W.D. 100 M

McDERMOTT — HUDSON
LONDON — ENGLAND

APPROVED
McDERMOTT — HUDSON
DATE: 23 Sep 74

ENGINEERS APPROVAL

	BY	DATE
PROJECT		16/9/76
STRUCTURAL		16/9/76
PROCESS		
MECHANICAL		
ELECTRICAL		
INSTRUMENT		
PAR. CHECK	B.C.S.B	23-SEP-76
PROP. CHECK		

DRAWN BY	SCALE	DATE	DWG NO.
	AS NOTED	12 SEP 74	ELN 2144
DESIGNED BY			SHEET NO.
PDM.			204

UNIT 'A' CELLAR DECK FRAMING

5

GAF 0071/74